


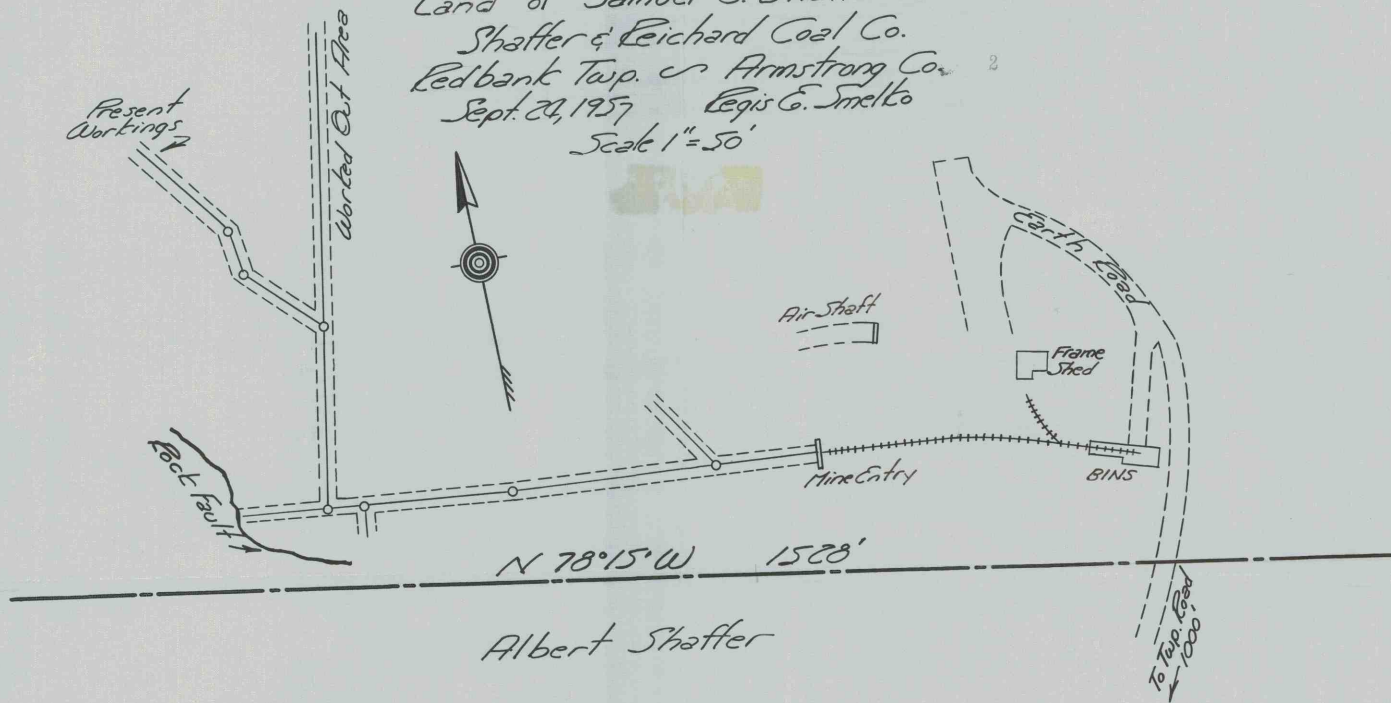

Land of Samuel C. Shaffer Heirs
Shaffer & Reichard Coal Co.
Redbank Twp. ~ Armstrong Co. 2
Sept. 29, 1957 EGIS E. Smelko
Scale 1" = 50'



276

32144