


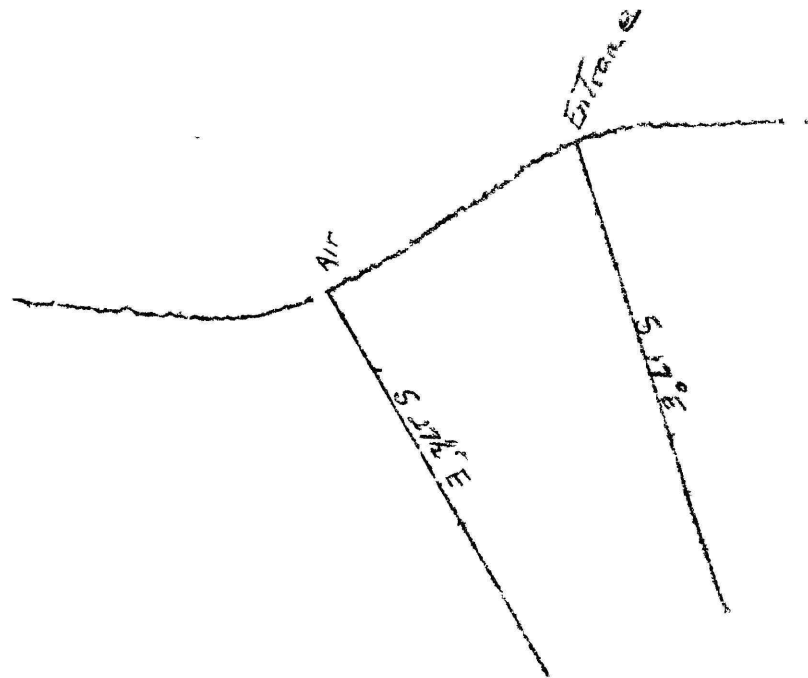

Scale 2" = 50'

Jim Crissman Mine
 Pulneyville - Belnap Road
 Surveyed January 22, 1955-
 by Lew Sturgeon