


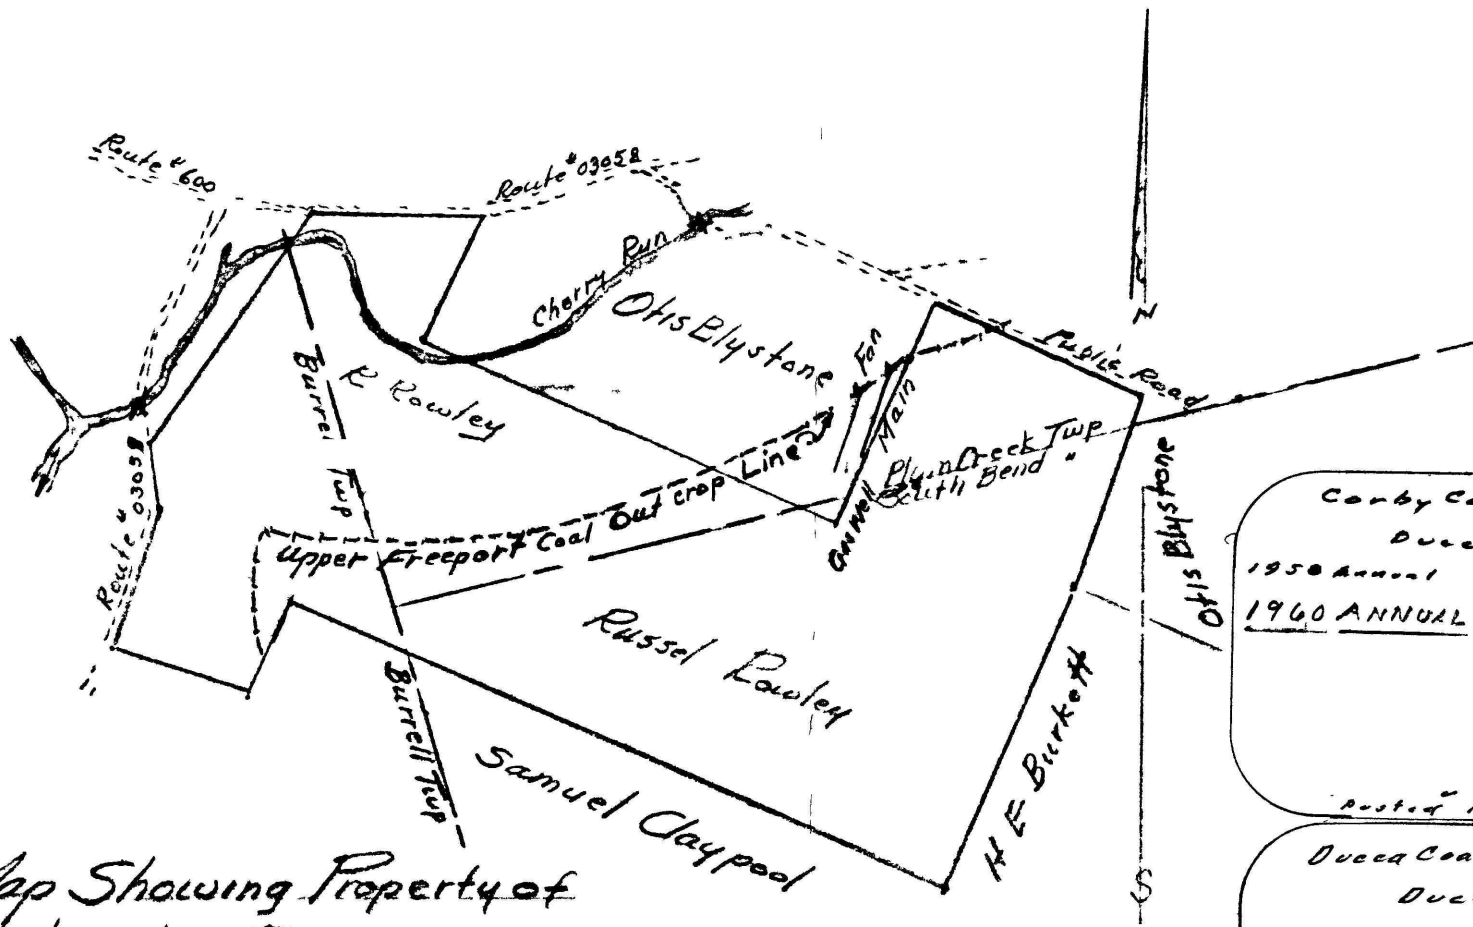

Map Showing Property of
 Louis Ducca -
 Situate - Plum Creek Twp, Armstrong Co., Pa.
 Scale - 1" = 400' - Map 30-1957
 Q B Jones Reg #1691-

Carby Coal Co.
 Ducca MINE
 1950 Annual District 2
 1960 ANNUAL DISTRICT 2

Posted 1-18-1960

Ducca Coal Co.
 Ducca
 1956 Annual District 2