


E. WALKER

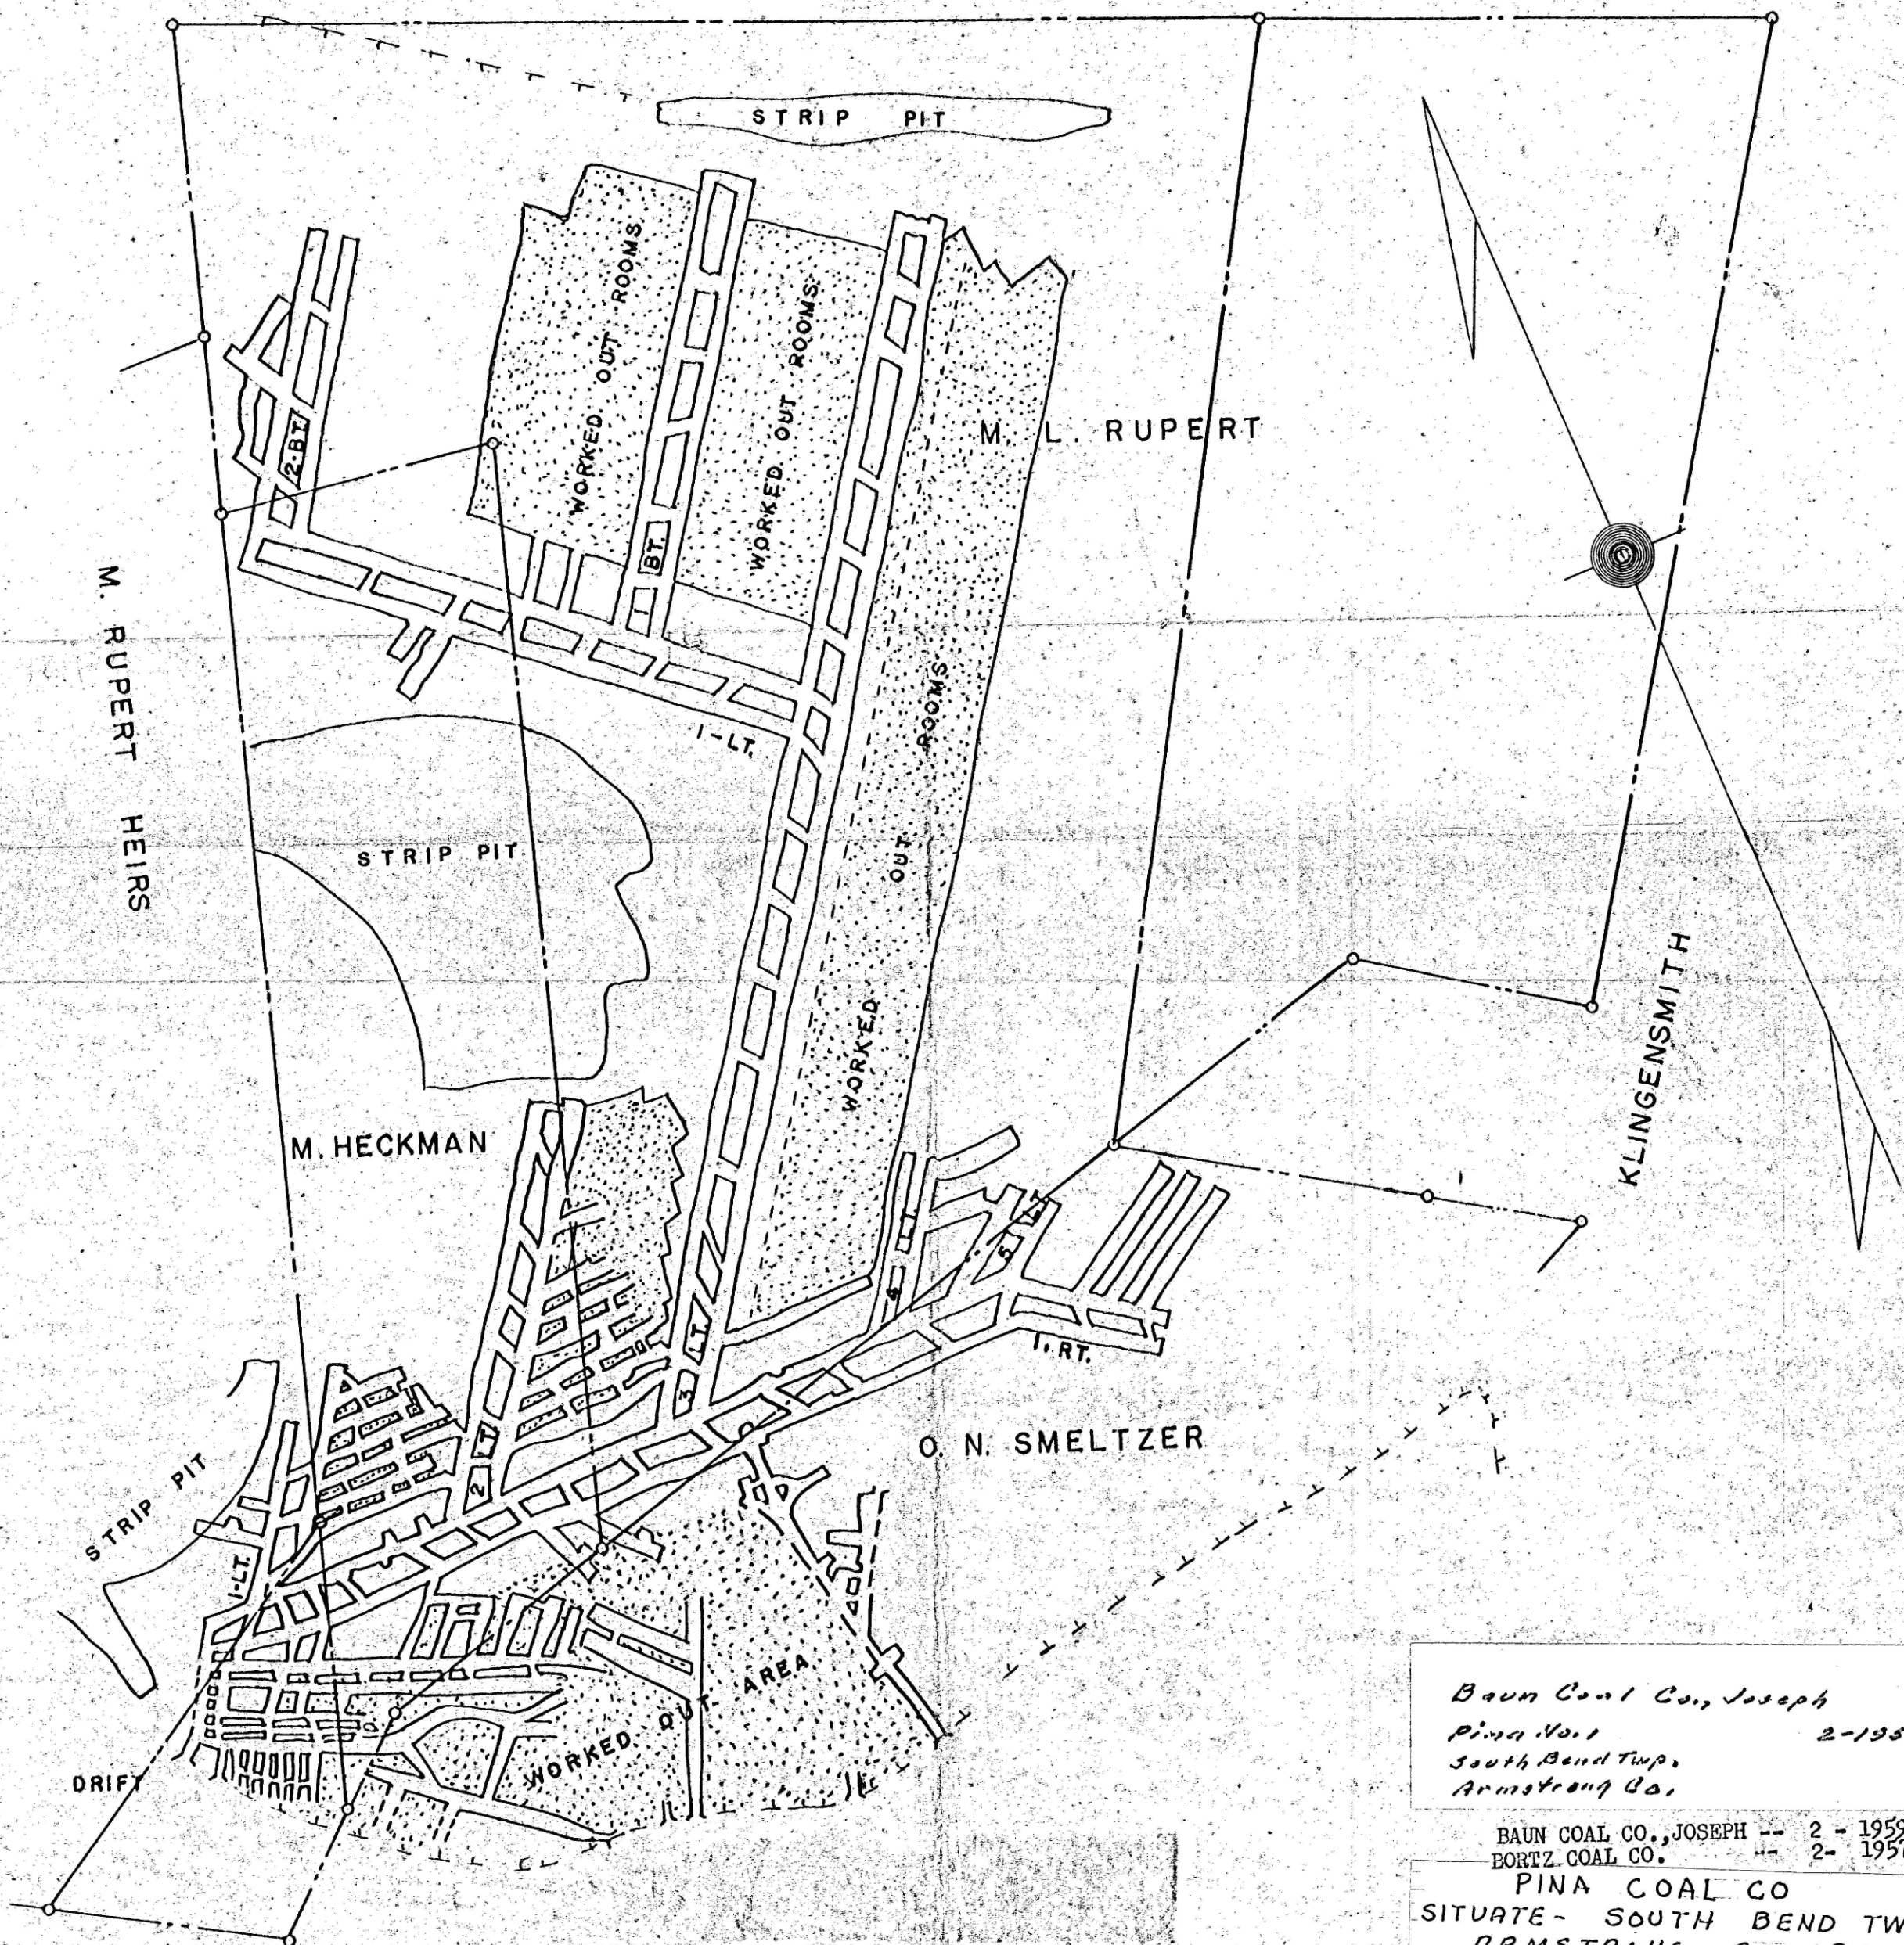

Baum Coal Co., Joseph
Pina No. 1 2-1959
South Bend Twp.
Armstrong Co.

BAUM COAL CO., JOSEPH -- 2 - 1959
BORTZ COAL CO. -- 2 - 1957

PINA COAL CO
SITUATE - SOUTH BEND TWP.
ARMSTRONG CO., PA.
SCALE 1"=200' MAY 26, 1956
UPPER FREEPORT VEIN.