


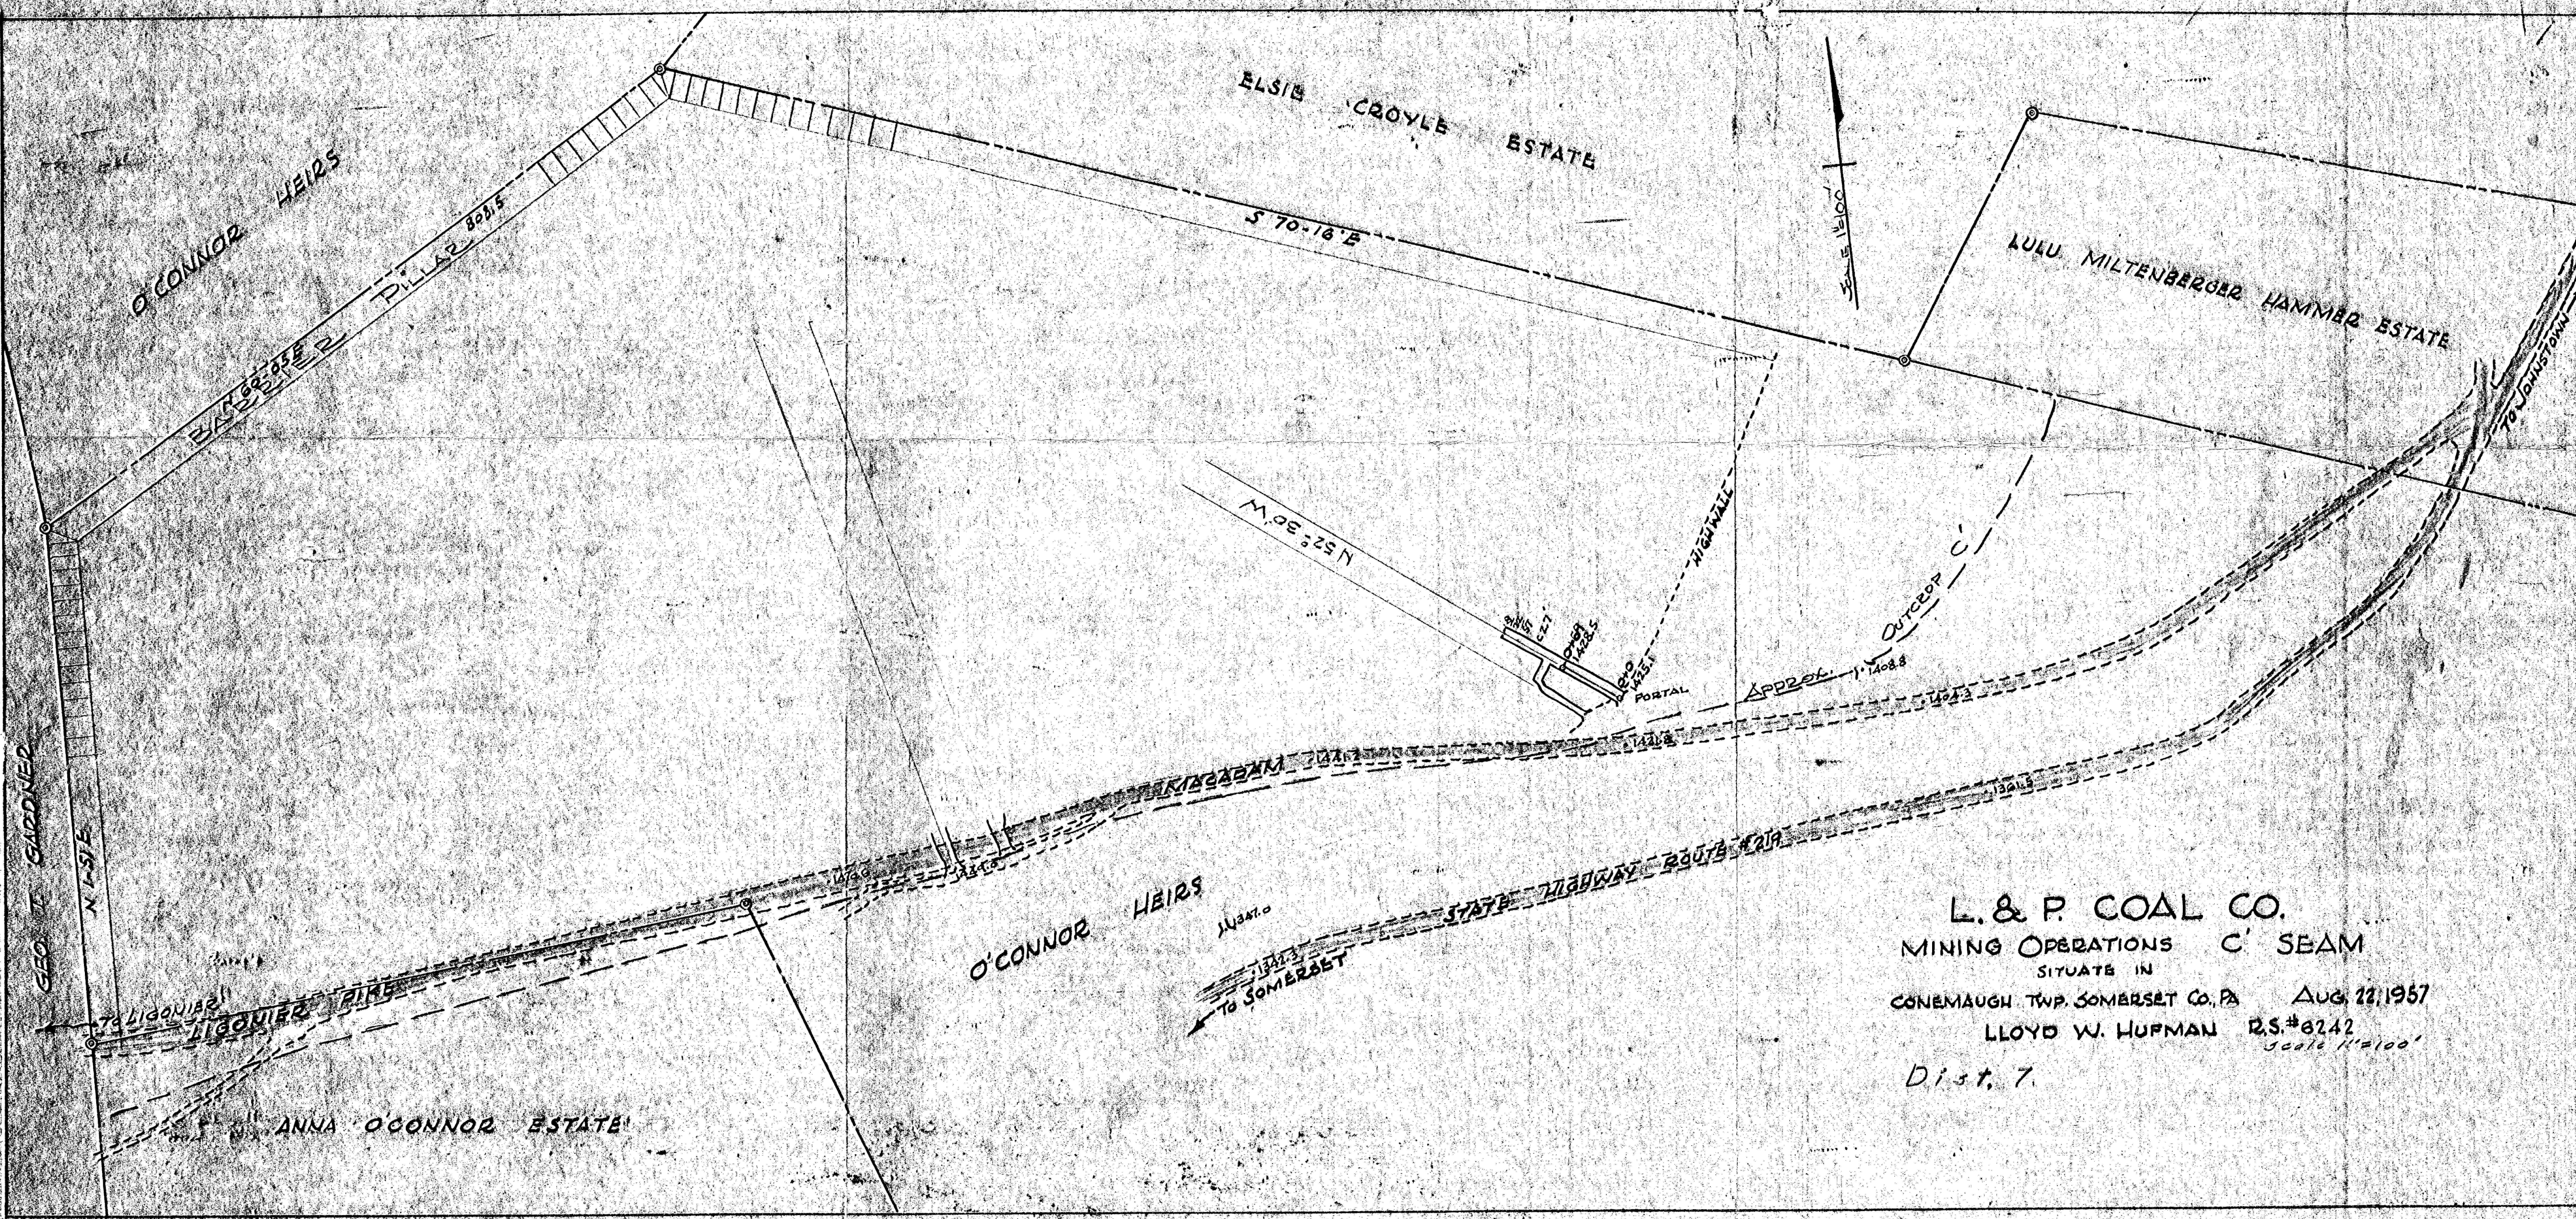

GEO. T. GARDNER
N 52° 30' W

O'CONNOR HEIRS

ELSIE COOYLE ESTATE

LULU MILTENBERGER HAMMER ESTATE

O'CONNOR HEIRS

ANNA O'CONNOR ESTATE

L. & P. COAL CO.
MINING OPERATIONS C' SEAM
SITUATE IN
CONEMAUGH TWP. SOMERSET CO., PA. AUG. 22, 1957
LLOYD W. HUFMAN D.S. #6242
Scale 1"=100'
Dist. 7.