


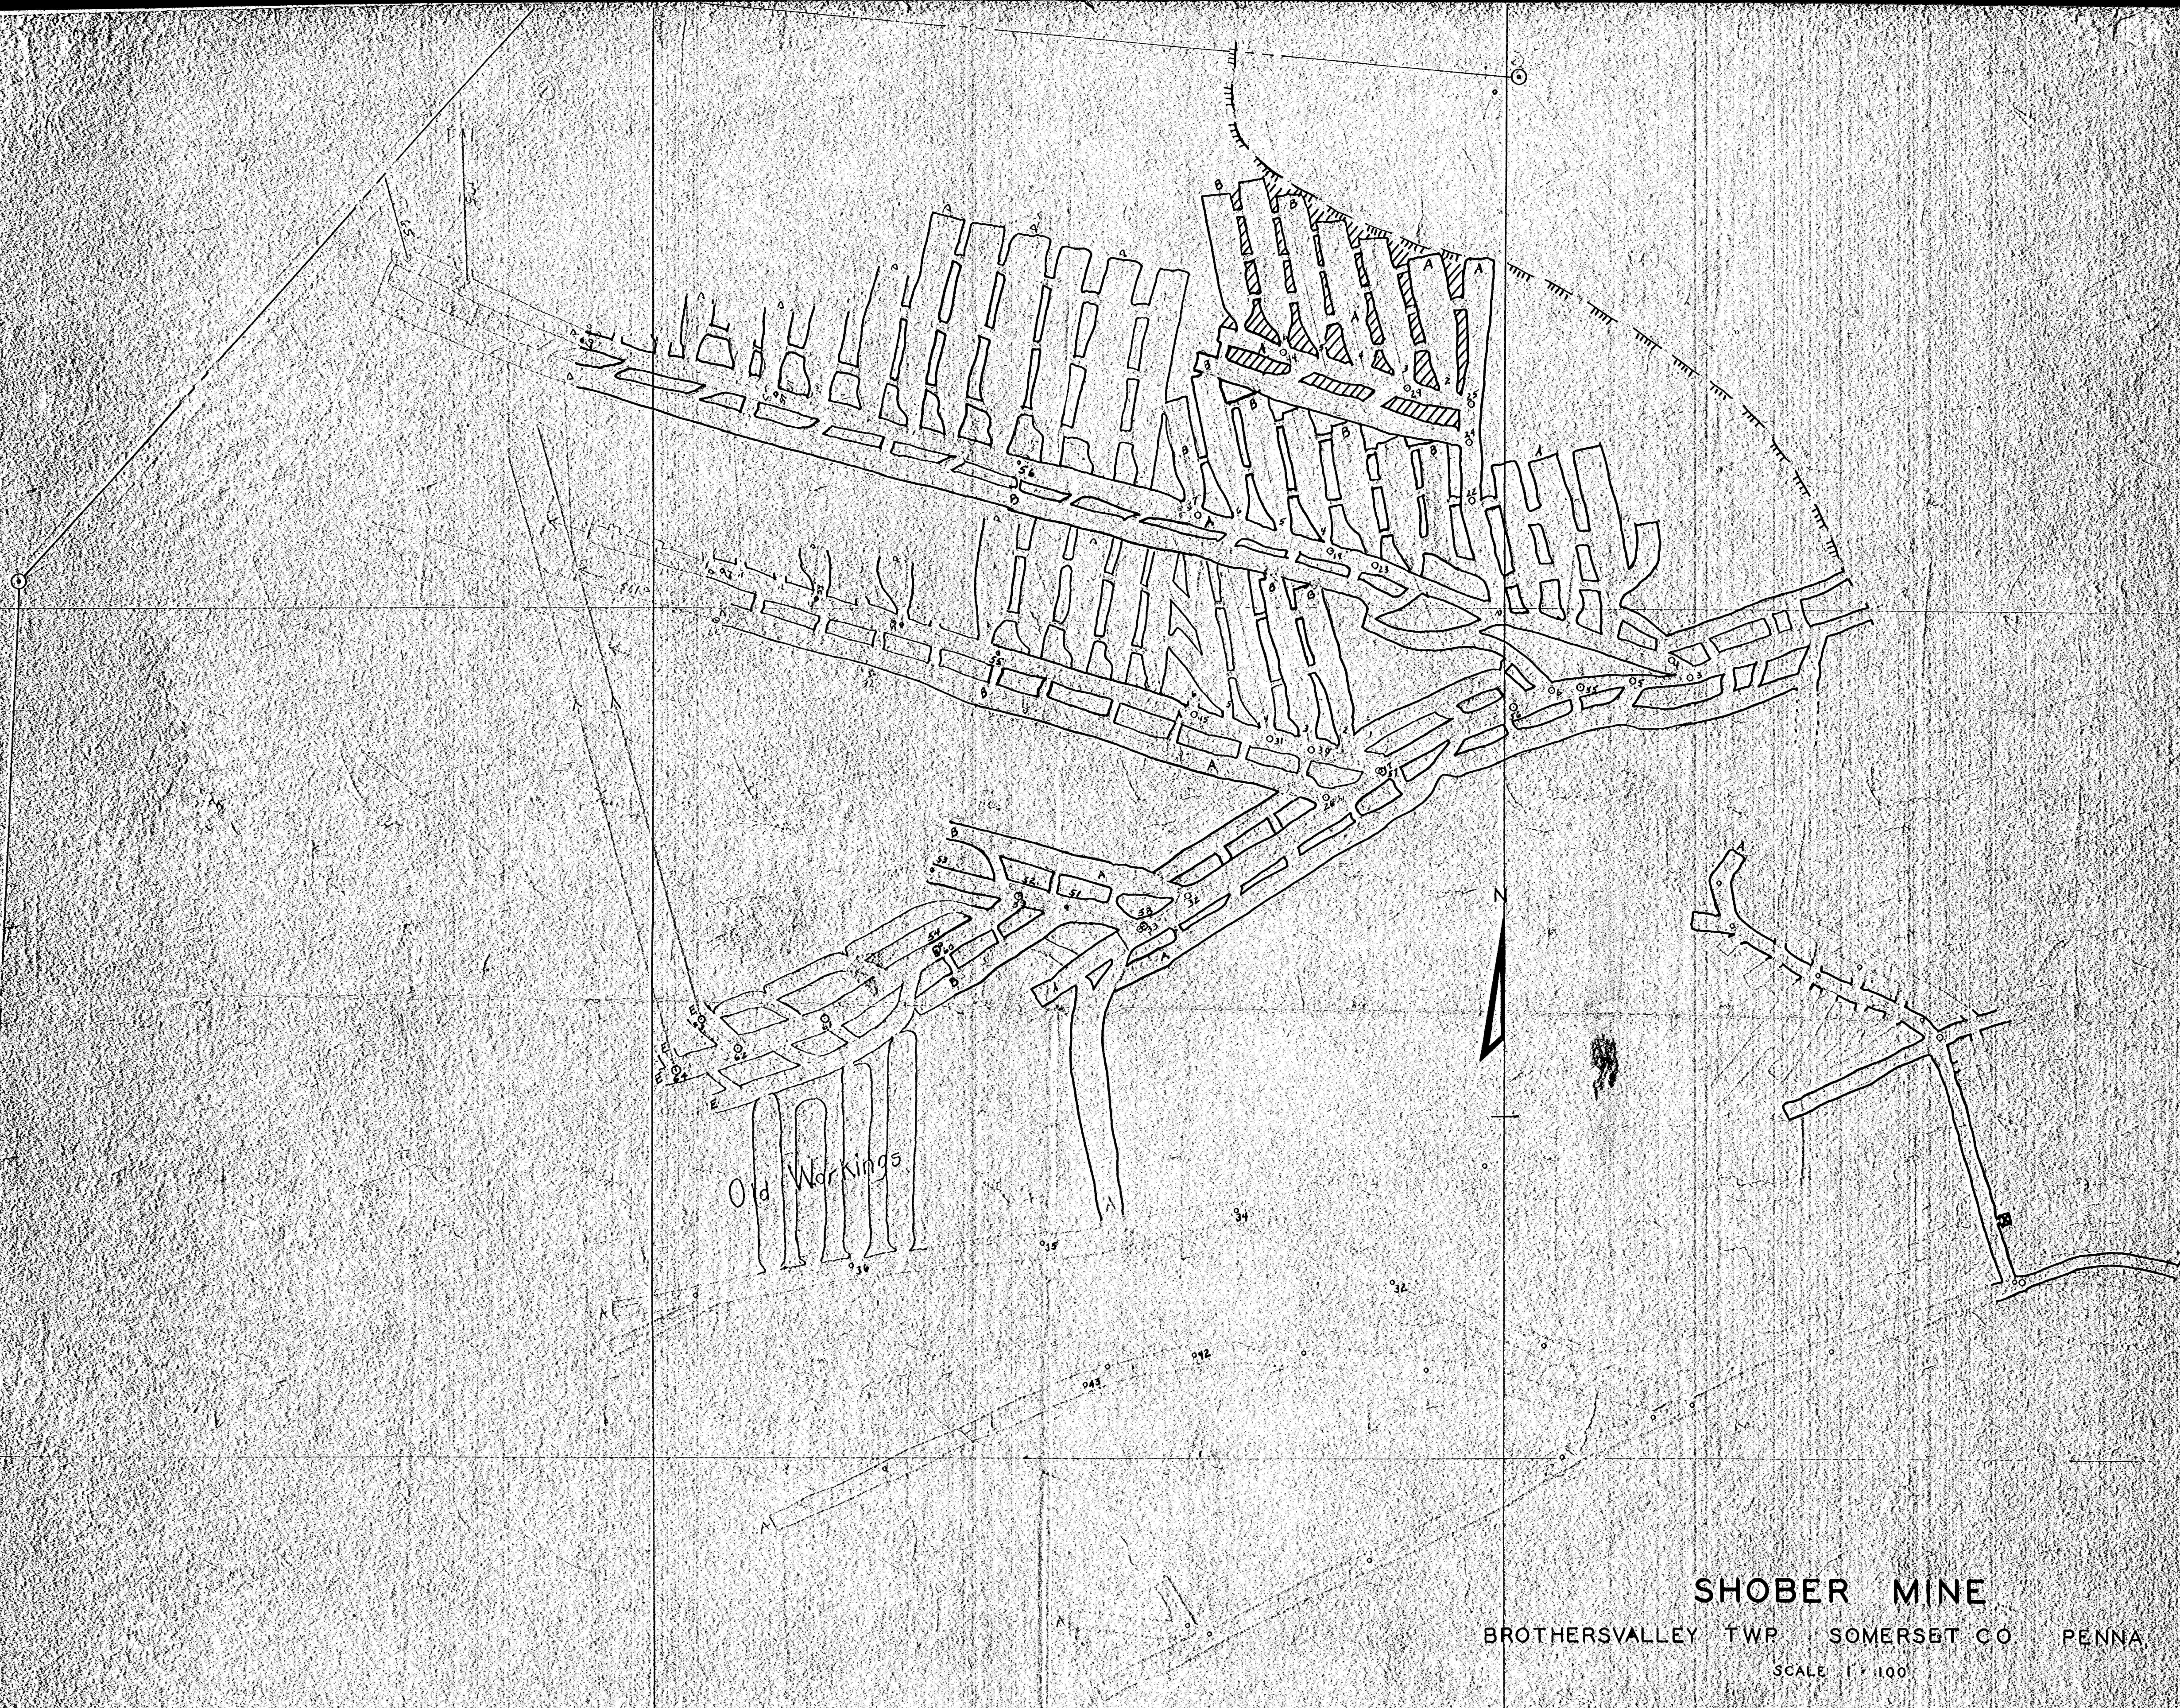

A	WILLIAM S. THOMPSON - R.S.	APRIL 16, 1947
B		JAN. 21, 1948
C		NOV. 13, 1948
D		MAY 13, 1948
E	R. Wayne Suder R.S.	Nov. 2, 1955