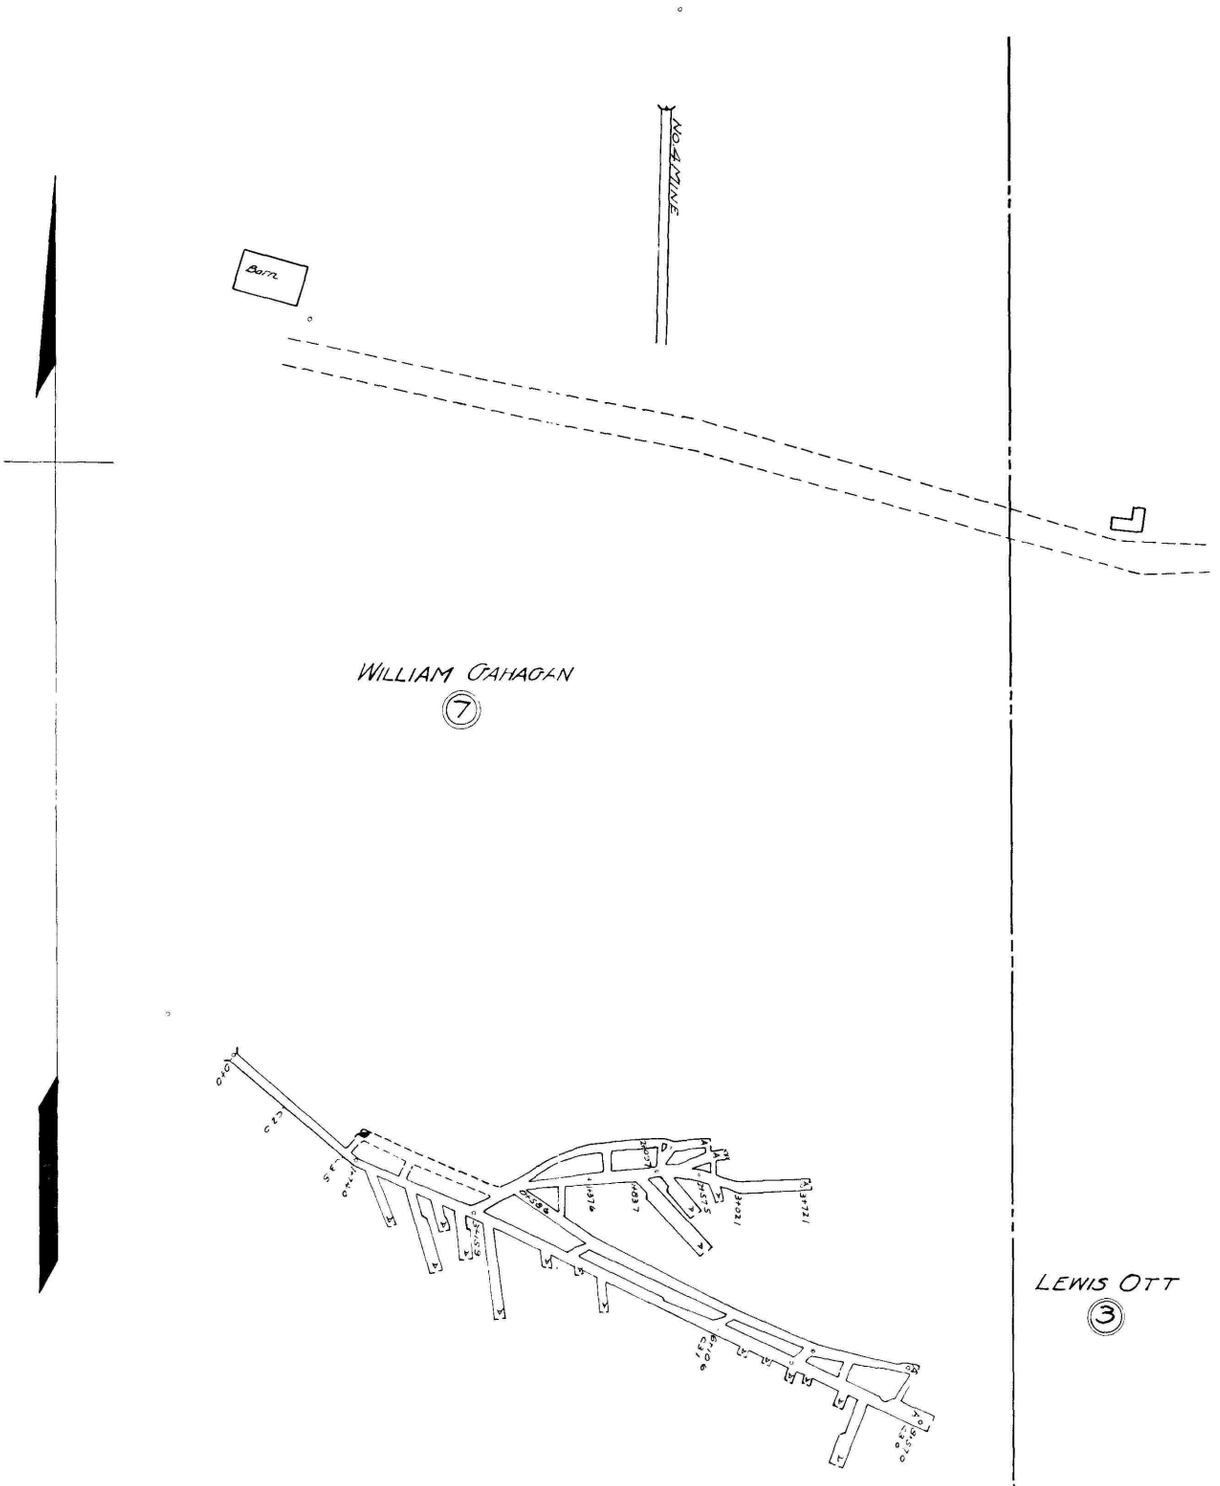

INDEX TO SURVEYS			
Letter	Date	Surveyed by	Plotted by
A	Feb 11, 1920	T.B Wilkie	David Abrams

SHADE COAL MINING CORORATION
MAP OF COHN'S MINE
SITUATE IN
PAINT TWP SOMERSET CO. PA.

Scale 1" = 100' S.E Dickey & Co. Feb 17, 1920.
Civil and Mining Engr's.
Johnstown, Pa

1-C-179