


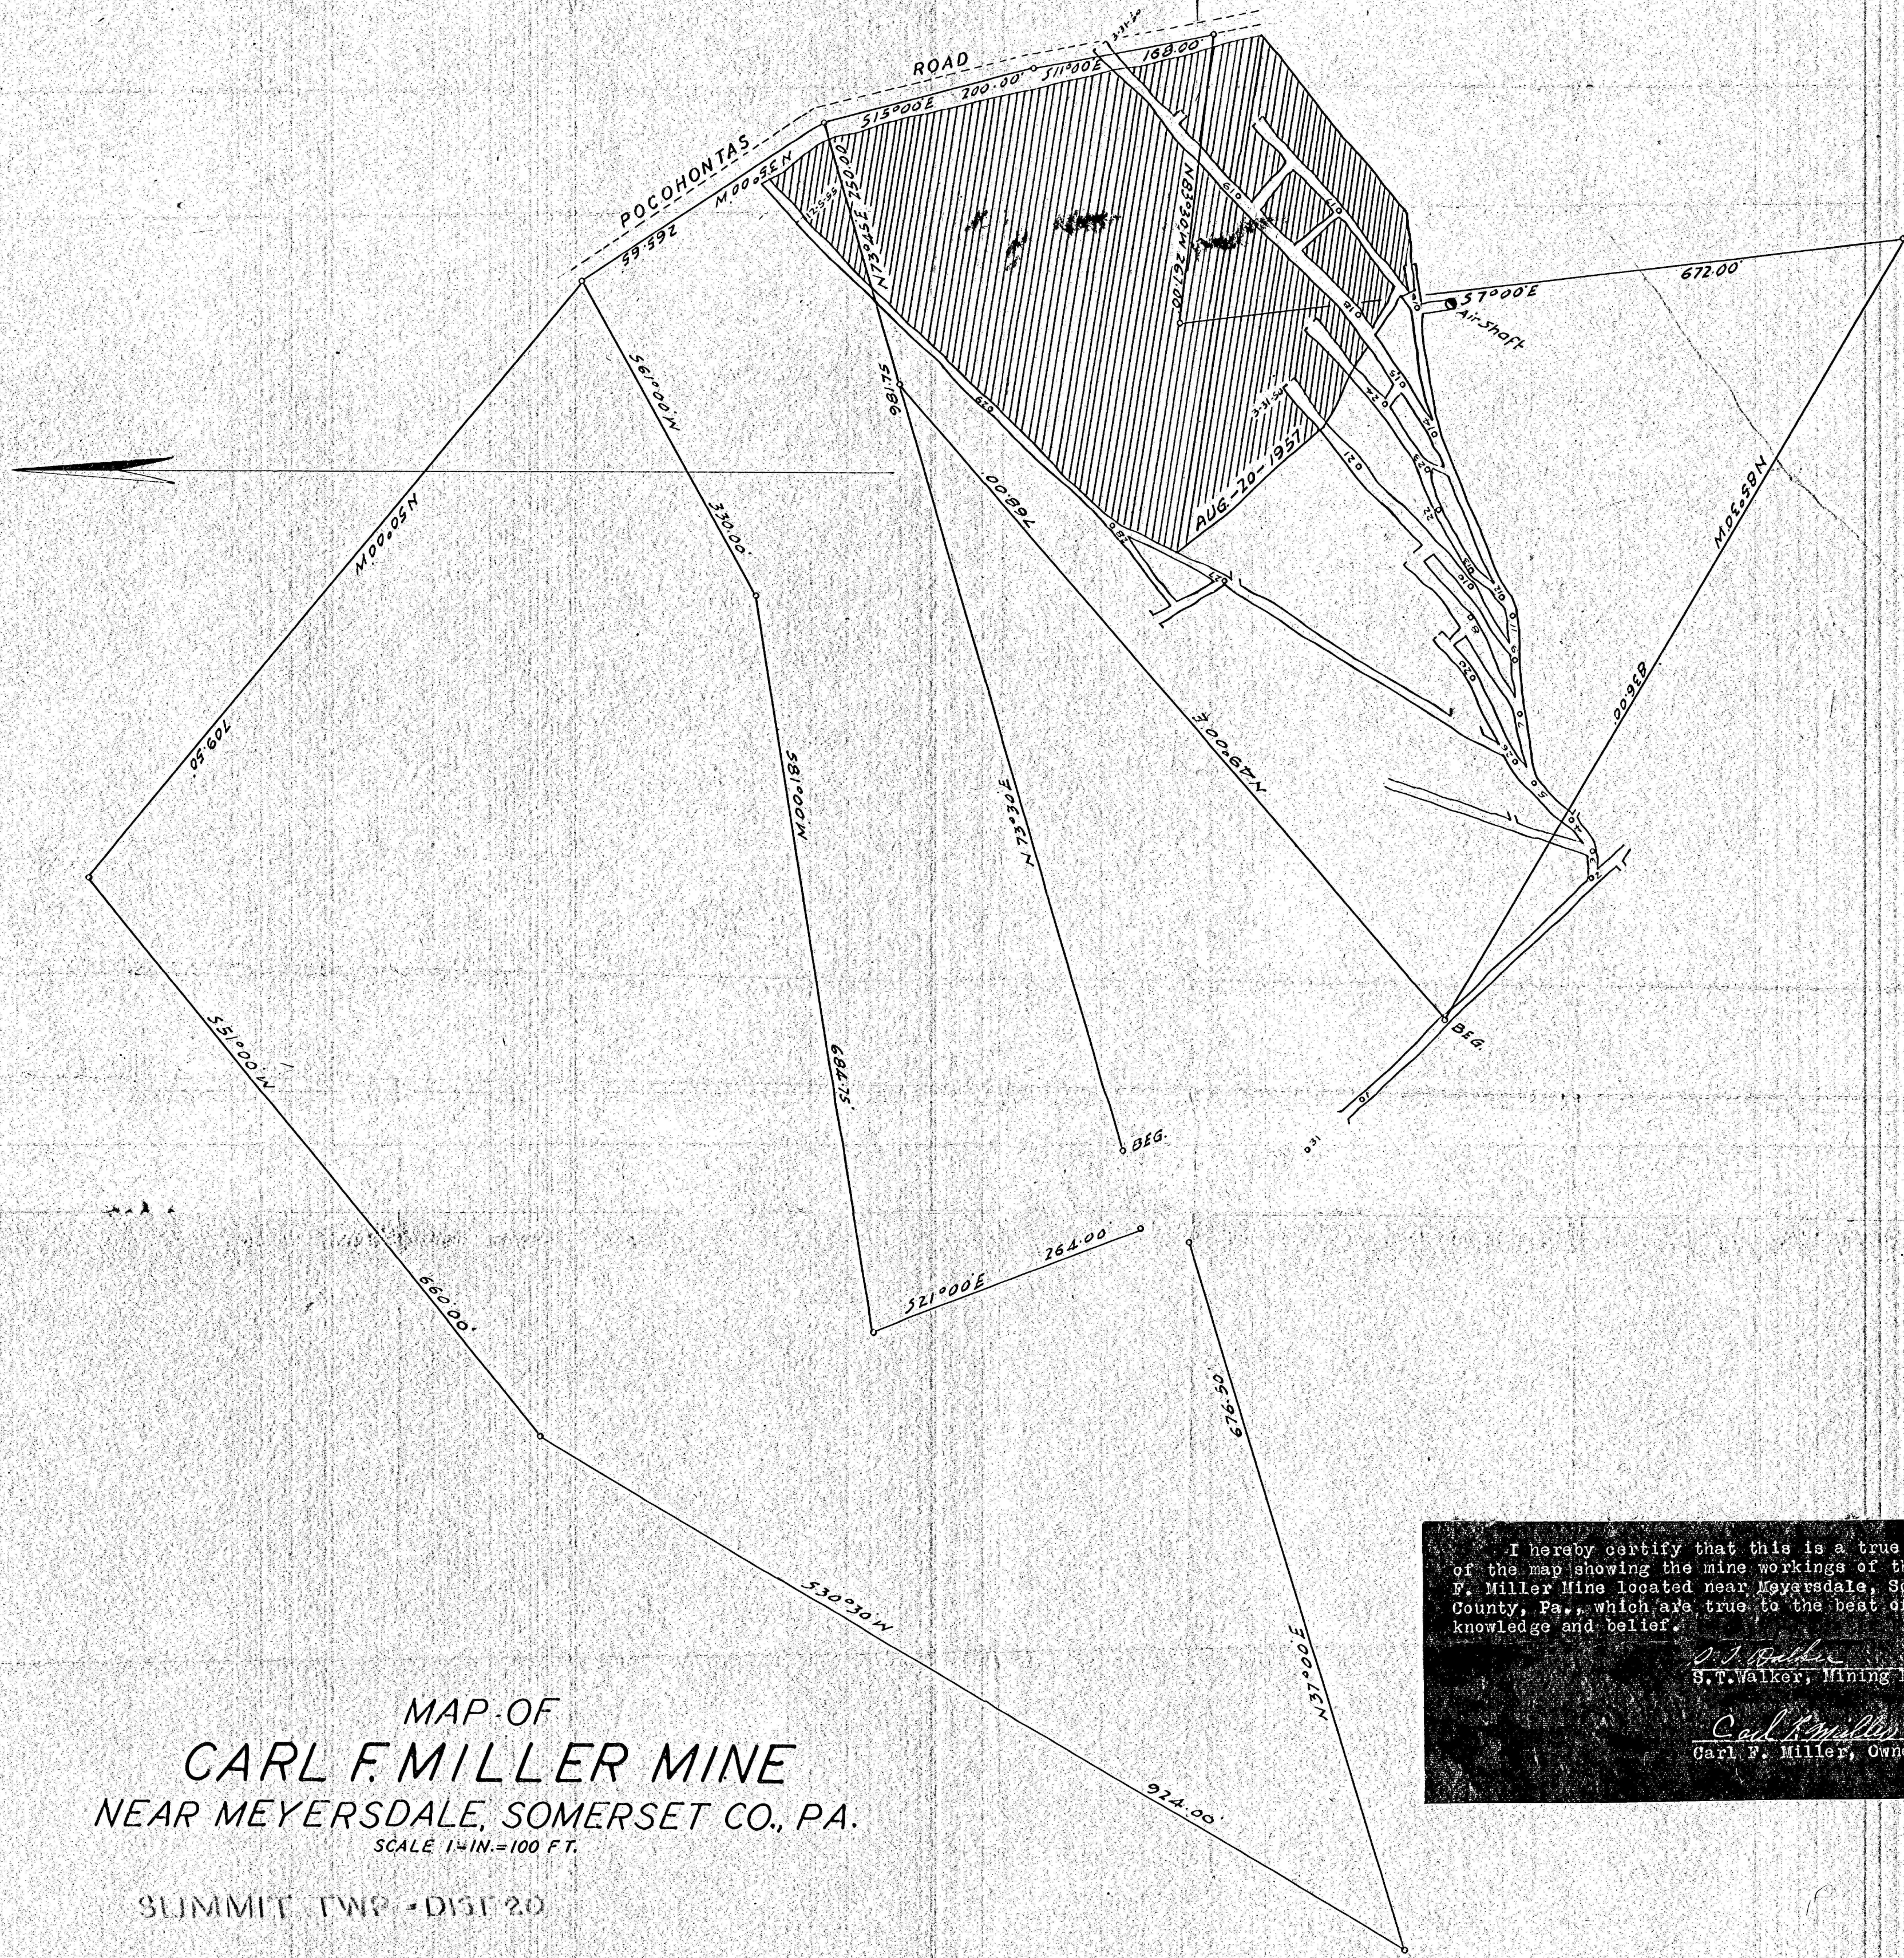

MAP OF
CARL F. MILLER MINE
 NEAR MEYERSDALE, SOMERSET CO., PA.
 SCALE 1"=100 FT.

SUMMIT TWP - DIST 20

I hereby certify that this is a true copy
 of the map showing the mine workings of the Carl
 F. Miller Mine located near Meyersdale, Somerset
 County, Pa., which are true to the best of my
 knowledge and belief.

S.T. Walker
 S.T. Walker, Mining Engr.

Carl F. Miller
 Carl F. Miller, Owner