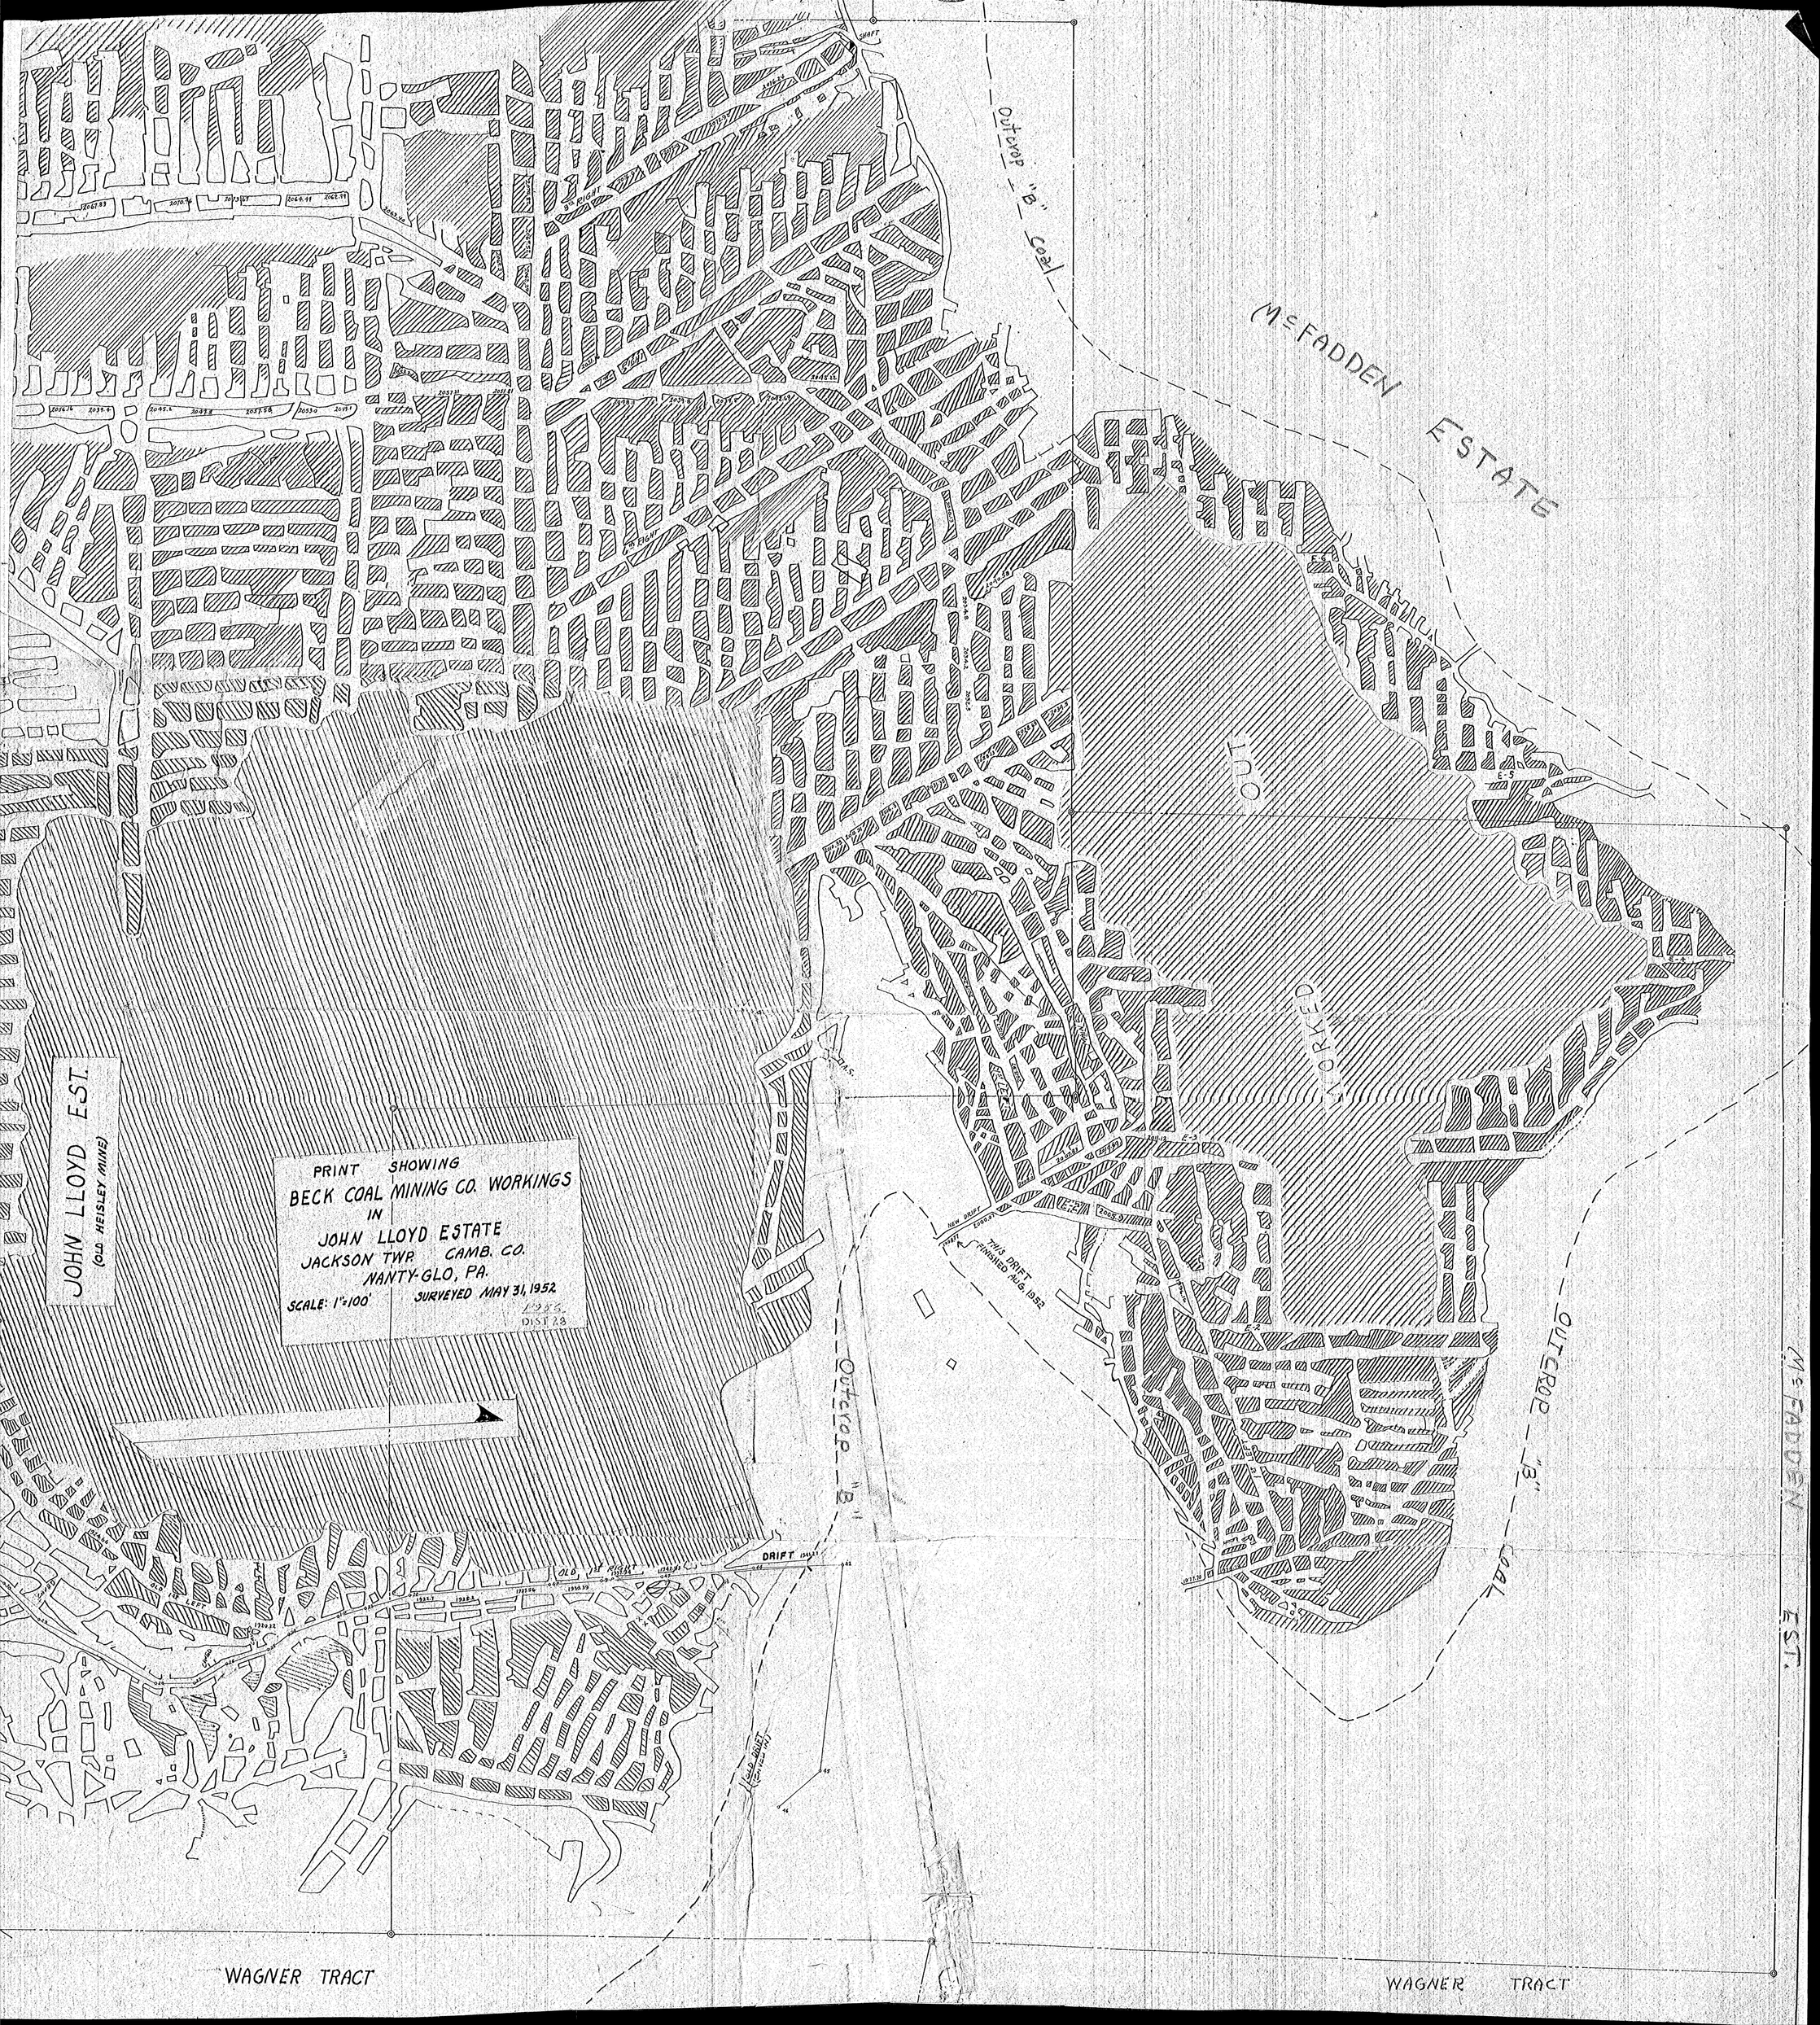
PRINT SHOWING
BECK COAL MINING CO. WORKINGS
IN
JOHN LLOYD ESTATE
JACKSON TWP. CAMB. CO.
NANTY-GLO, PA.
SCALE: 1"=100'
SURVEYED MAY 31, 1952
1953
DIST 28
JOHN LLOYD EST.
(OLD HEISLEY MINE)
Outcrop "B" Coal
McFADDEN ESTATE
OUT CROP
McFADDEN EST.
OUTCROP "B" COAL
SHAFT
NEW DRIFT
THIS DRIFT FINISHED AUG. 1952
DRIFT
OLD
WAGNER TRACT
WAGNER TRACT