


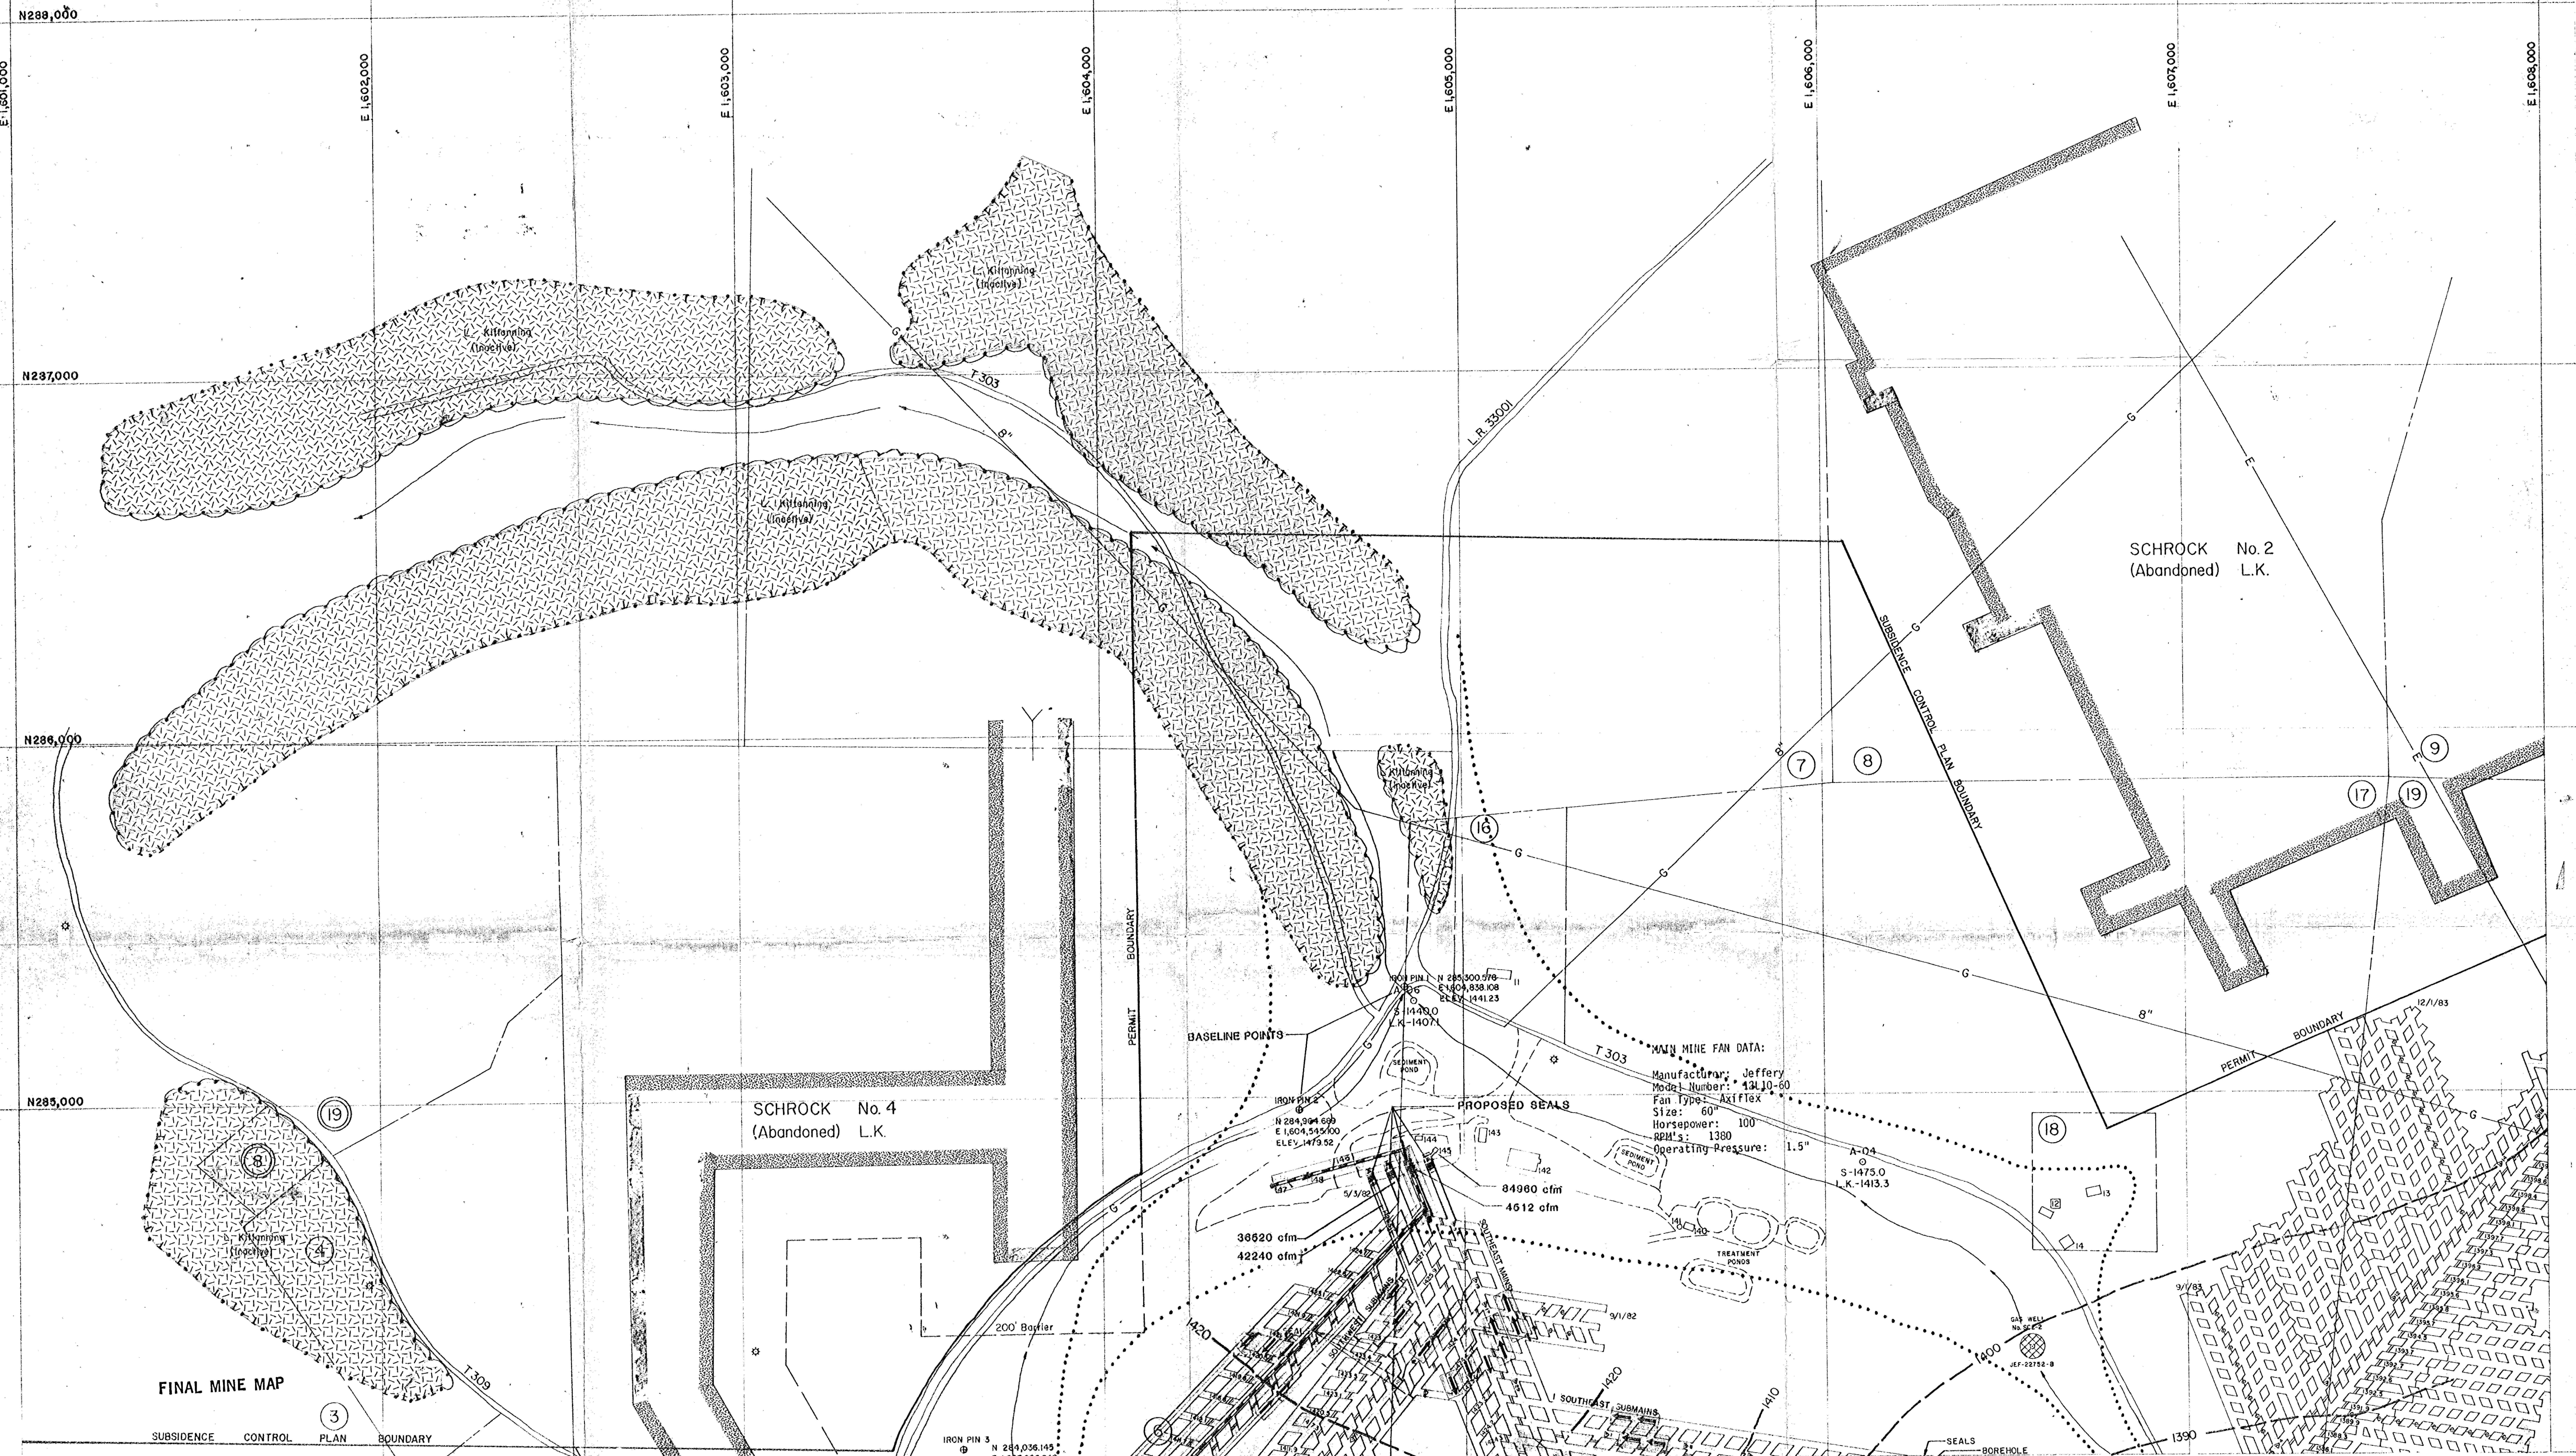

PORTER TWP., JEFFERSON CO.
Doverspike Bros. Coal Co.
R.D. 4 Box 221, Portersville, Pa. 15787

SUGARCAMP NO. 2

SHEET No. 2 of 18 SCALE 1"=200'

EXHIBIT "B"

LEGEND

PERMIT AREA
UNDERGROUND WORKINGS
TOWNSHIP BOUNDARY
COUNTY BOUNDARY
TEST BOREHOLE
CROP LINES
COAL CONTOURS
SURFACE WORKINGS
MINE OPENINGS, Not Sealed
MINE OPENINGS, Sealed
PROPERTY LINES
PRE 1966 DWELLINGS

POST 1966 DWELLINGS
CEMETERIES
STRUCTURES
MAJOR ELECTRIC LINES
GAS WELLS
WATER WELLS
STREAMS
LAKES or PONDS
SPRINGS
WATER TREATMENT FACILITIES
CONTIGUOUS PROPERTY

LEGEND cont.

WATER
6 MONTH PROJECTIONS
SUPPORT AREA
CONTEMPLATED MINING
COMPLETED MINING
SURVEY STATION
GAS WELL BARRIER

(No Mining Within Barrier Unless Approved)

DATE: _____

SCALE: 1"=200'

DOVERSPIKE BROS. COAL CO.
SUGARCAMP No. 2 MINE

DATE: _____

SCALE: 1"=200'

INTAKE AIR
RETURN AIR
PRIMARY ESCAPEWAY
SECONDARY ESCAPEWAY
BELT LINE
B-E POINTS (Approved)
B-E POINTS (Proposed)
STOPPING

STOPPING W/ DOOR
CHECK CURTAIN
REGULATOR
DOUBLE DOORS (Equip. doors)
OVERCAST

Survey is closed loop, Accuracy is 1:10000
Individuals responsible for information:
Mark Pennsy, Engineer & Larry Smith, Superintendent