


LETTER	DATE OF SURVEY	SURVEYED BY	PLOTTED BY
A	Feb. 13, 1919	E. P. Herschner	C. L. R. Bondy
B	May 31, 1919	"	"
C	April 8, 1920	"	"

ED. GONDER SURFACE.
ATLANTIC COAL CO. COAL.

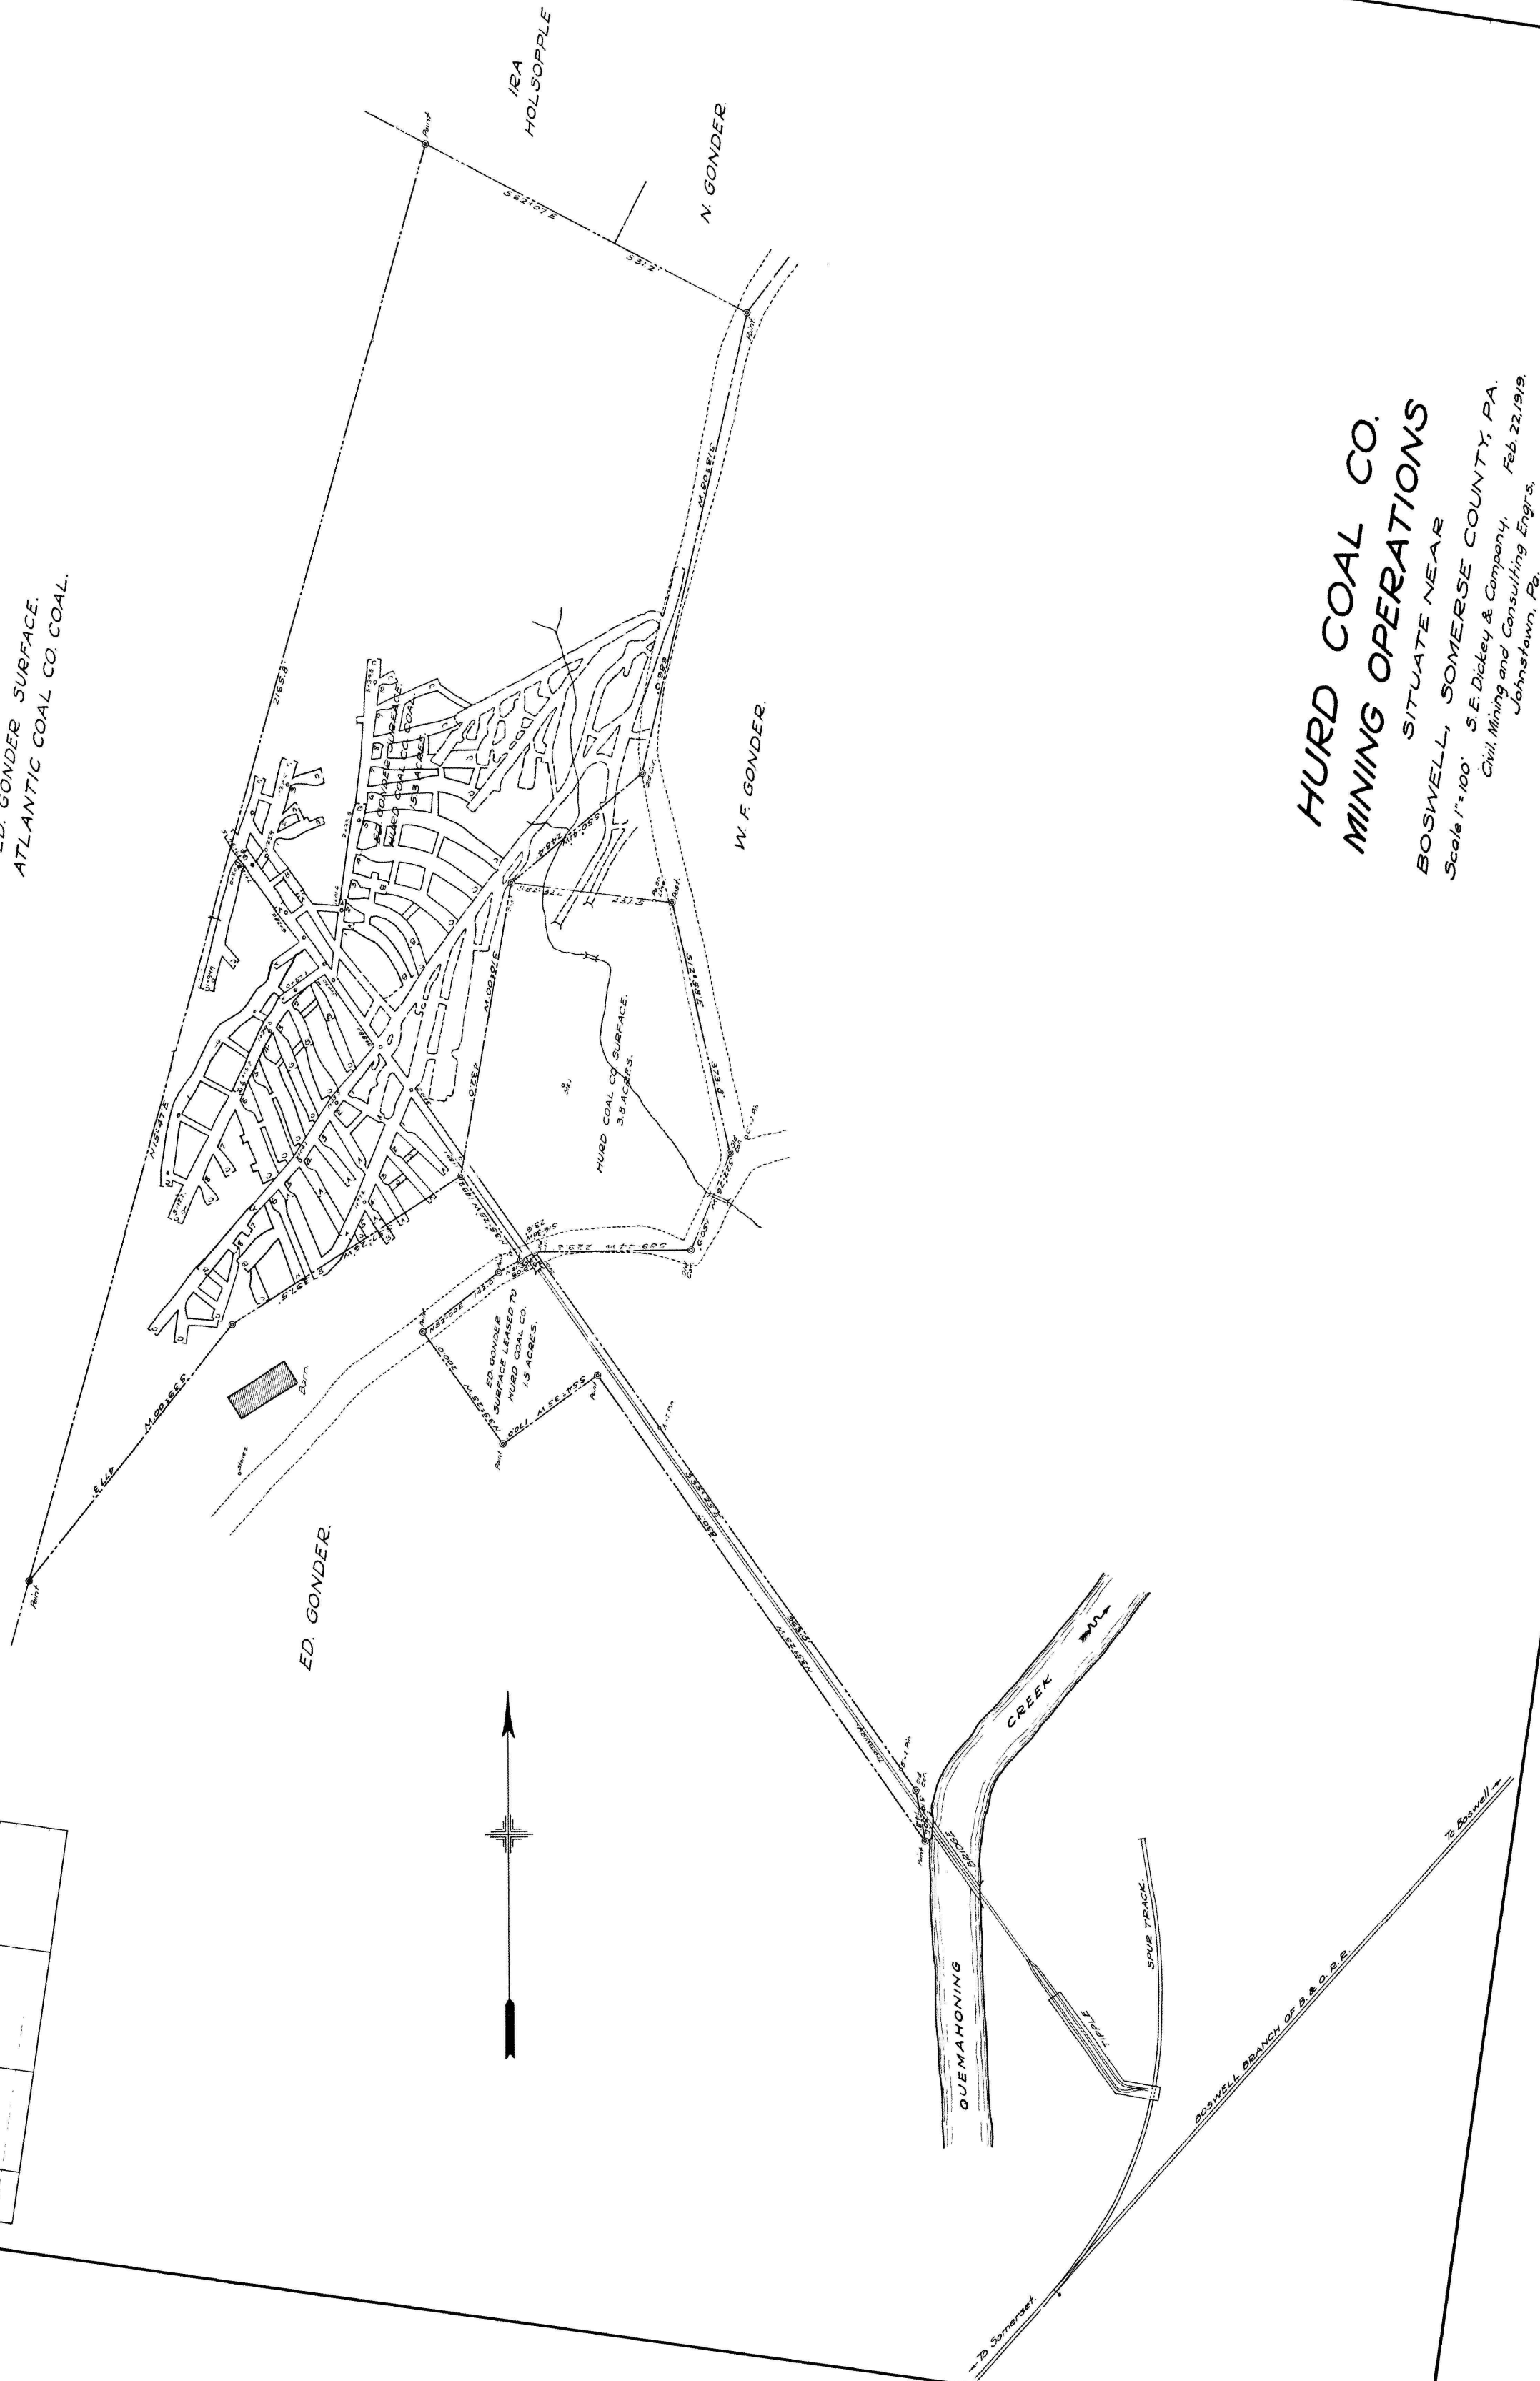

HURD COAL CO.
MINING OPERATIONS
SITUATE NEAR
BOSWELL, SOMERSET COUNTY, PA.
Scale 1"=100' S. E. Dickey & Company, Feb. 22, 1919.
Civil Mining and Consulting Engrs.
Johnstown, Pa.