


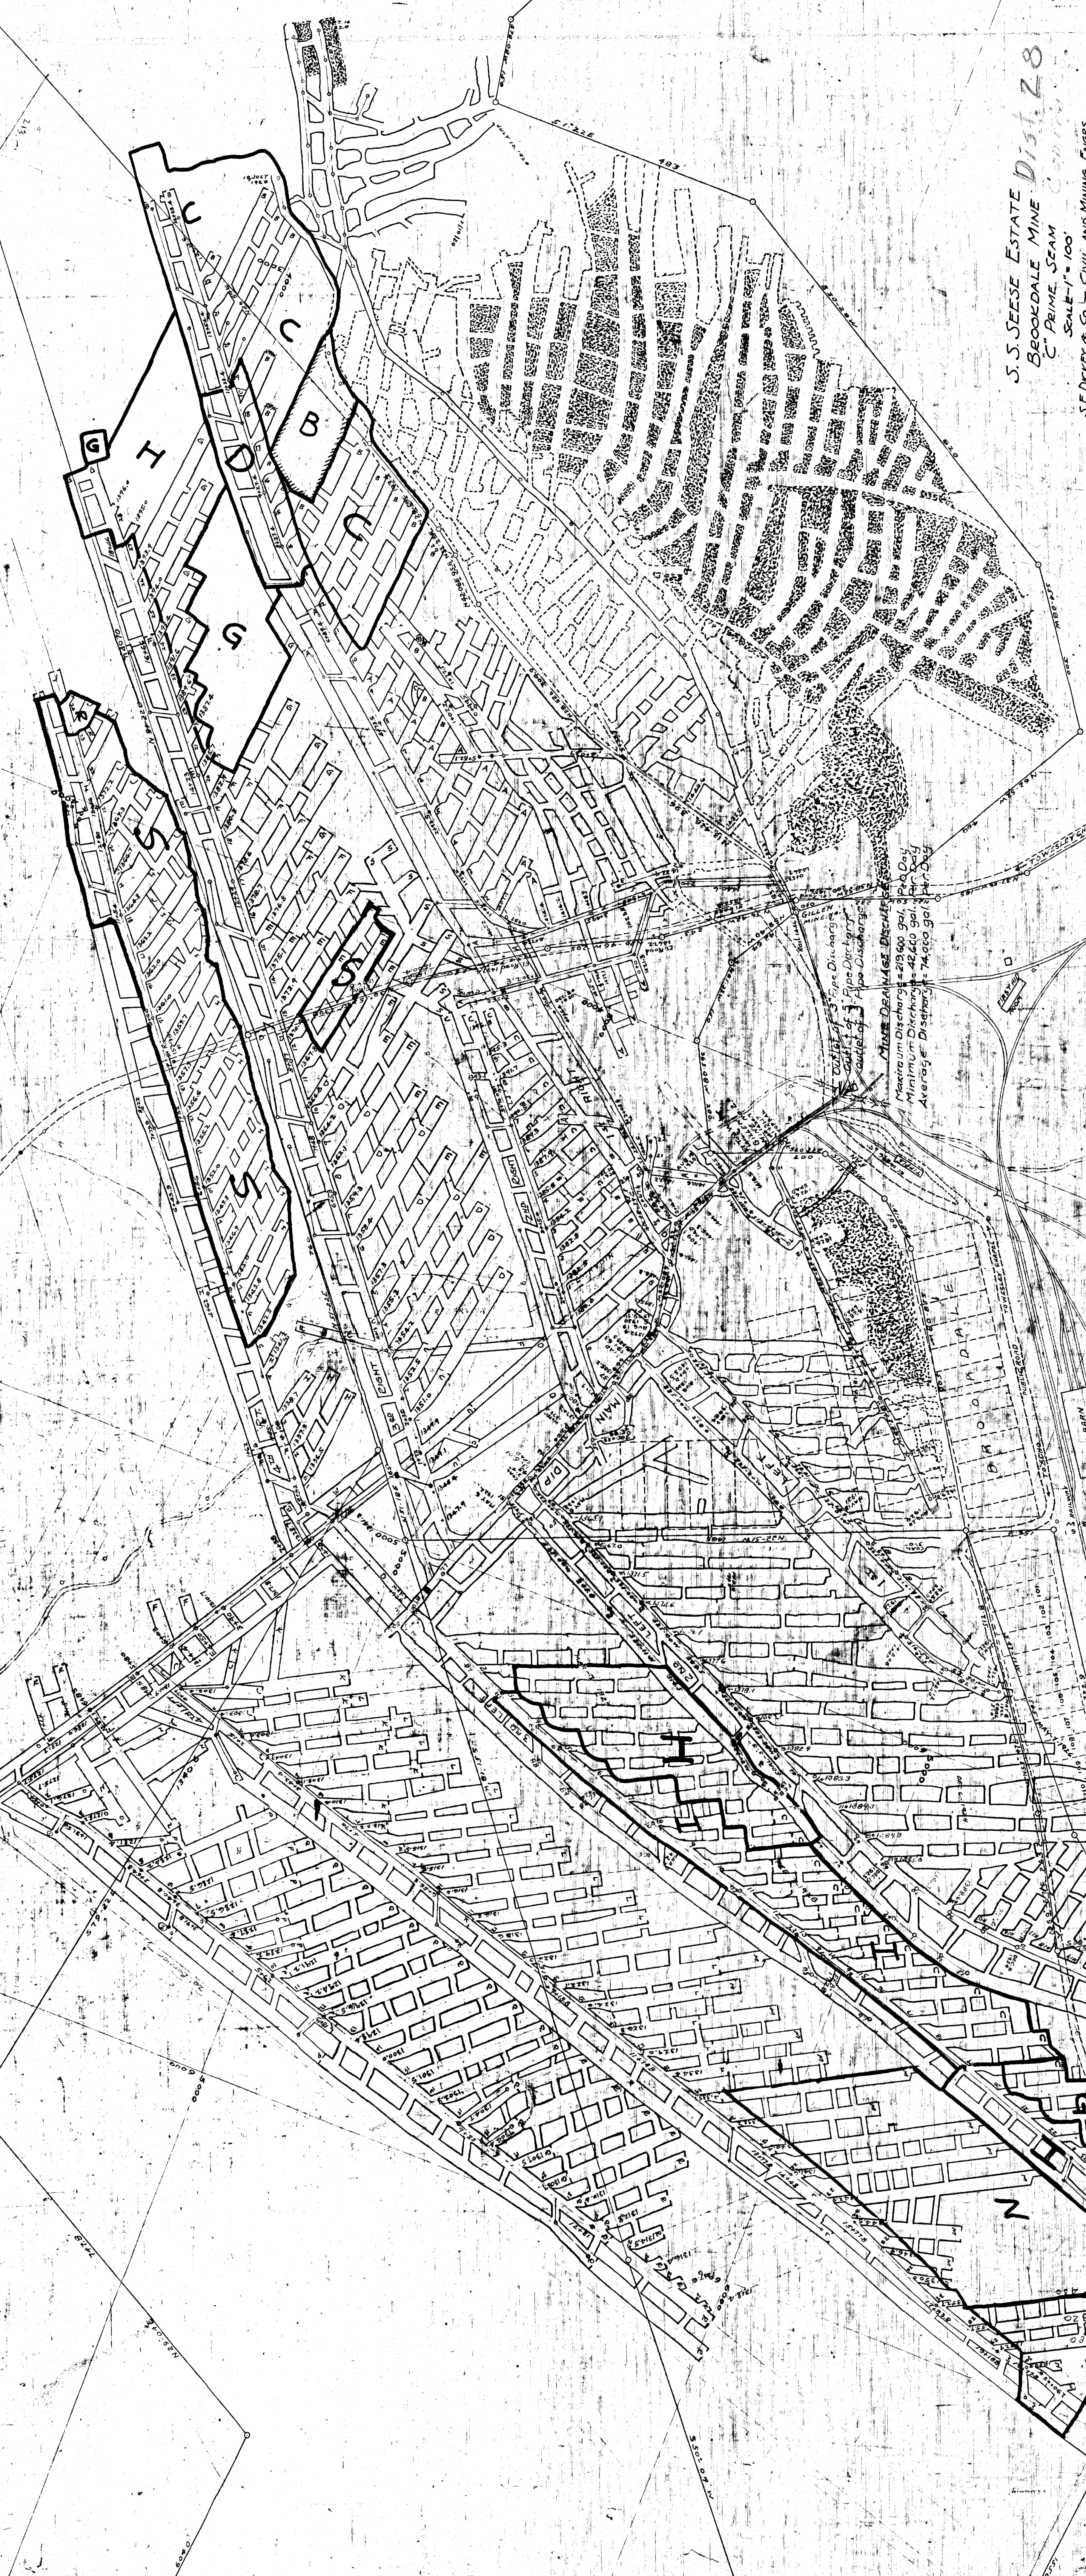

S. J. SEESE ESTATE DIST. 28
BROOKDALE MINE
C. PRIME SEAM
SCALE 1" = 100'


