


4316
6/16/57
CC

DEEP MINE SAFETY 100

BROWN BROTHERS COAL CO.
"B" SEAM
QUEMAHONING TOWNSHIP
SOMERSET COUNTY, PA
SCALE 1"=100'
SOMERSET PA SEPT. 10, 1957
CASSIDY & CROUSE
H.C. Crouse, Jr.
REVISED 4-1-59 Robert W. Crouse, Jr. RS. # 57458

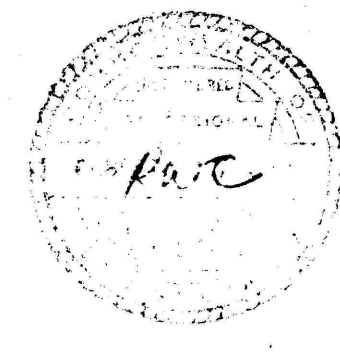

DAVID MAHLER SURV.

S62°47'E

1545.0

JAMES ZOLDA "B" Seam

HIGH WALL STRIP MINE

SCHOOL
TWP. ROAD TO BRESTWICK

PETE BARTA SURV.

HAROLD J. REXROTH
20Ac. Surv.

JAMES ZOLDA "B" Seam

BANK

HIGH WALL STRIP MINE

STORY TOWN

LINCOLN HWG.

DON DEARMIT SURV.

TO REELS COR.

TRIP

B SEAM CROP LINE

N 13°12'E 205.1

MAIN

