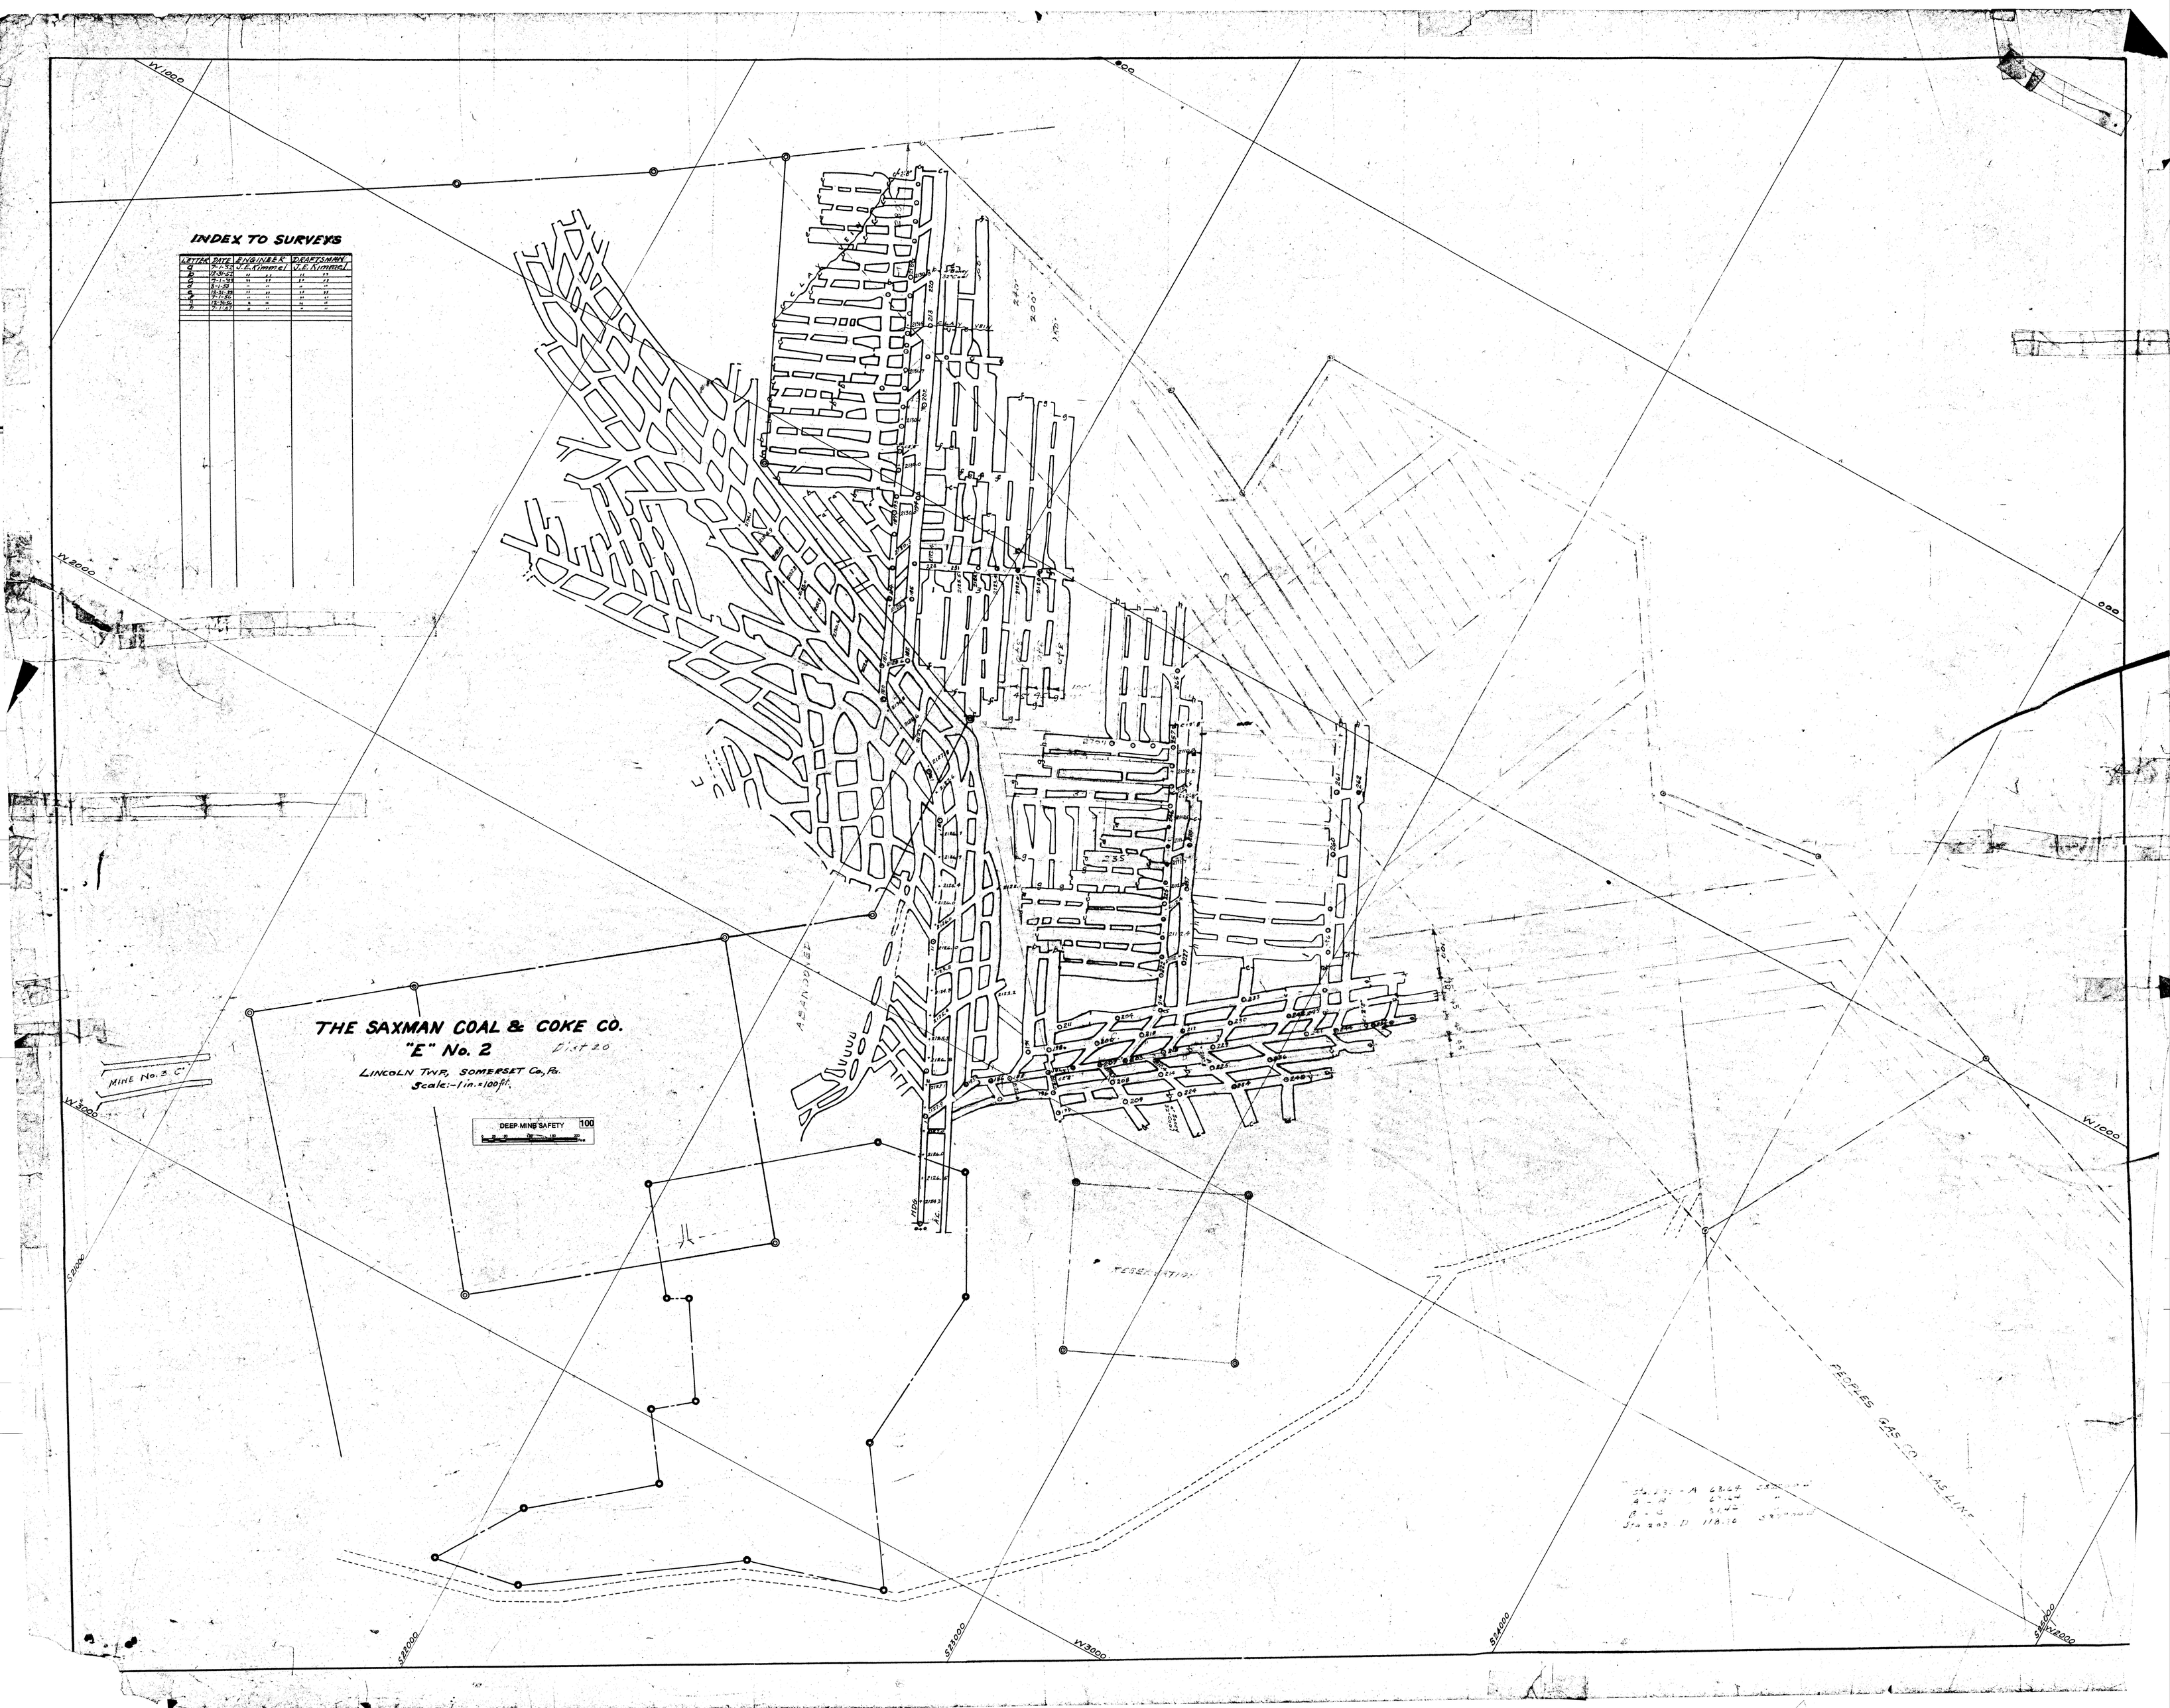
INDEX TO SURVEYS
LETTER | DATE | ENGINEER | DRAFTSMAN
a | 7-1-55 | N.B. Gimbel | V.L. Simmons
b | 12-9-61 | " | " | " | "
c | 7-11-38 | " | " | " | "
d | 8-1-38 | " | " | " | "
e | 12-31-38 | " | " | " | "
f | 7-1-60 | " | " | " | "
g | 12-31-56 | " | " | " | "
h | 7-1-62 | " | " | " | "
THE SAXMAN COAL & COKE CO.
"E" No. 2
Dist 20
LINCOLN TWP, SOMERSET Co, Pa.
Scale:-1 in.=100 ft.
DEEP MINE SAFETY 100
MINE No. 3 "C"
ABANDONED
RESERVATION
PEOPLES GAS CO. PIPE LINE
W1000
W2000
W3000
S22000
S23000
S24000
S25000
S26000