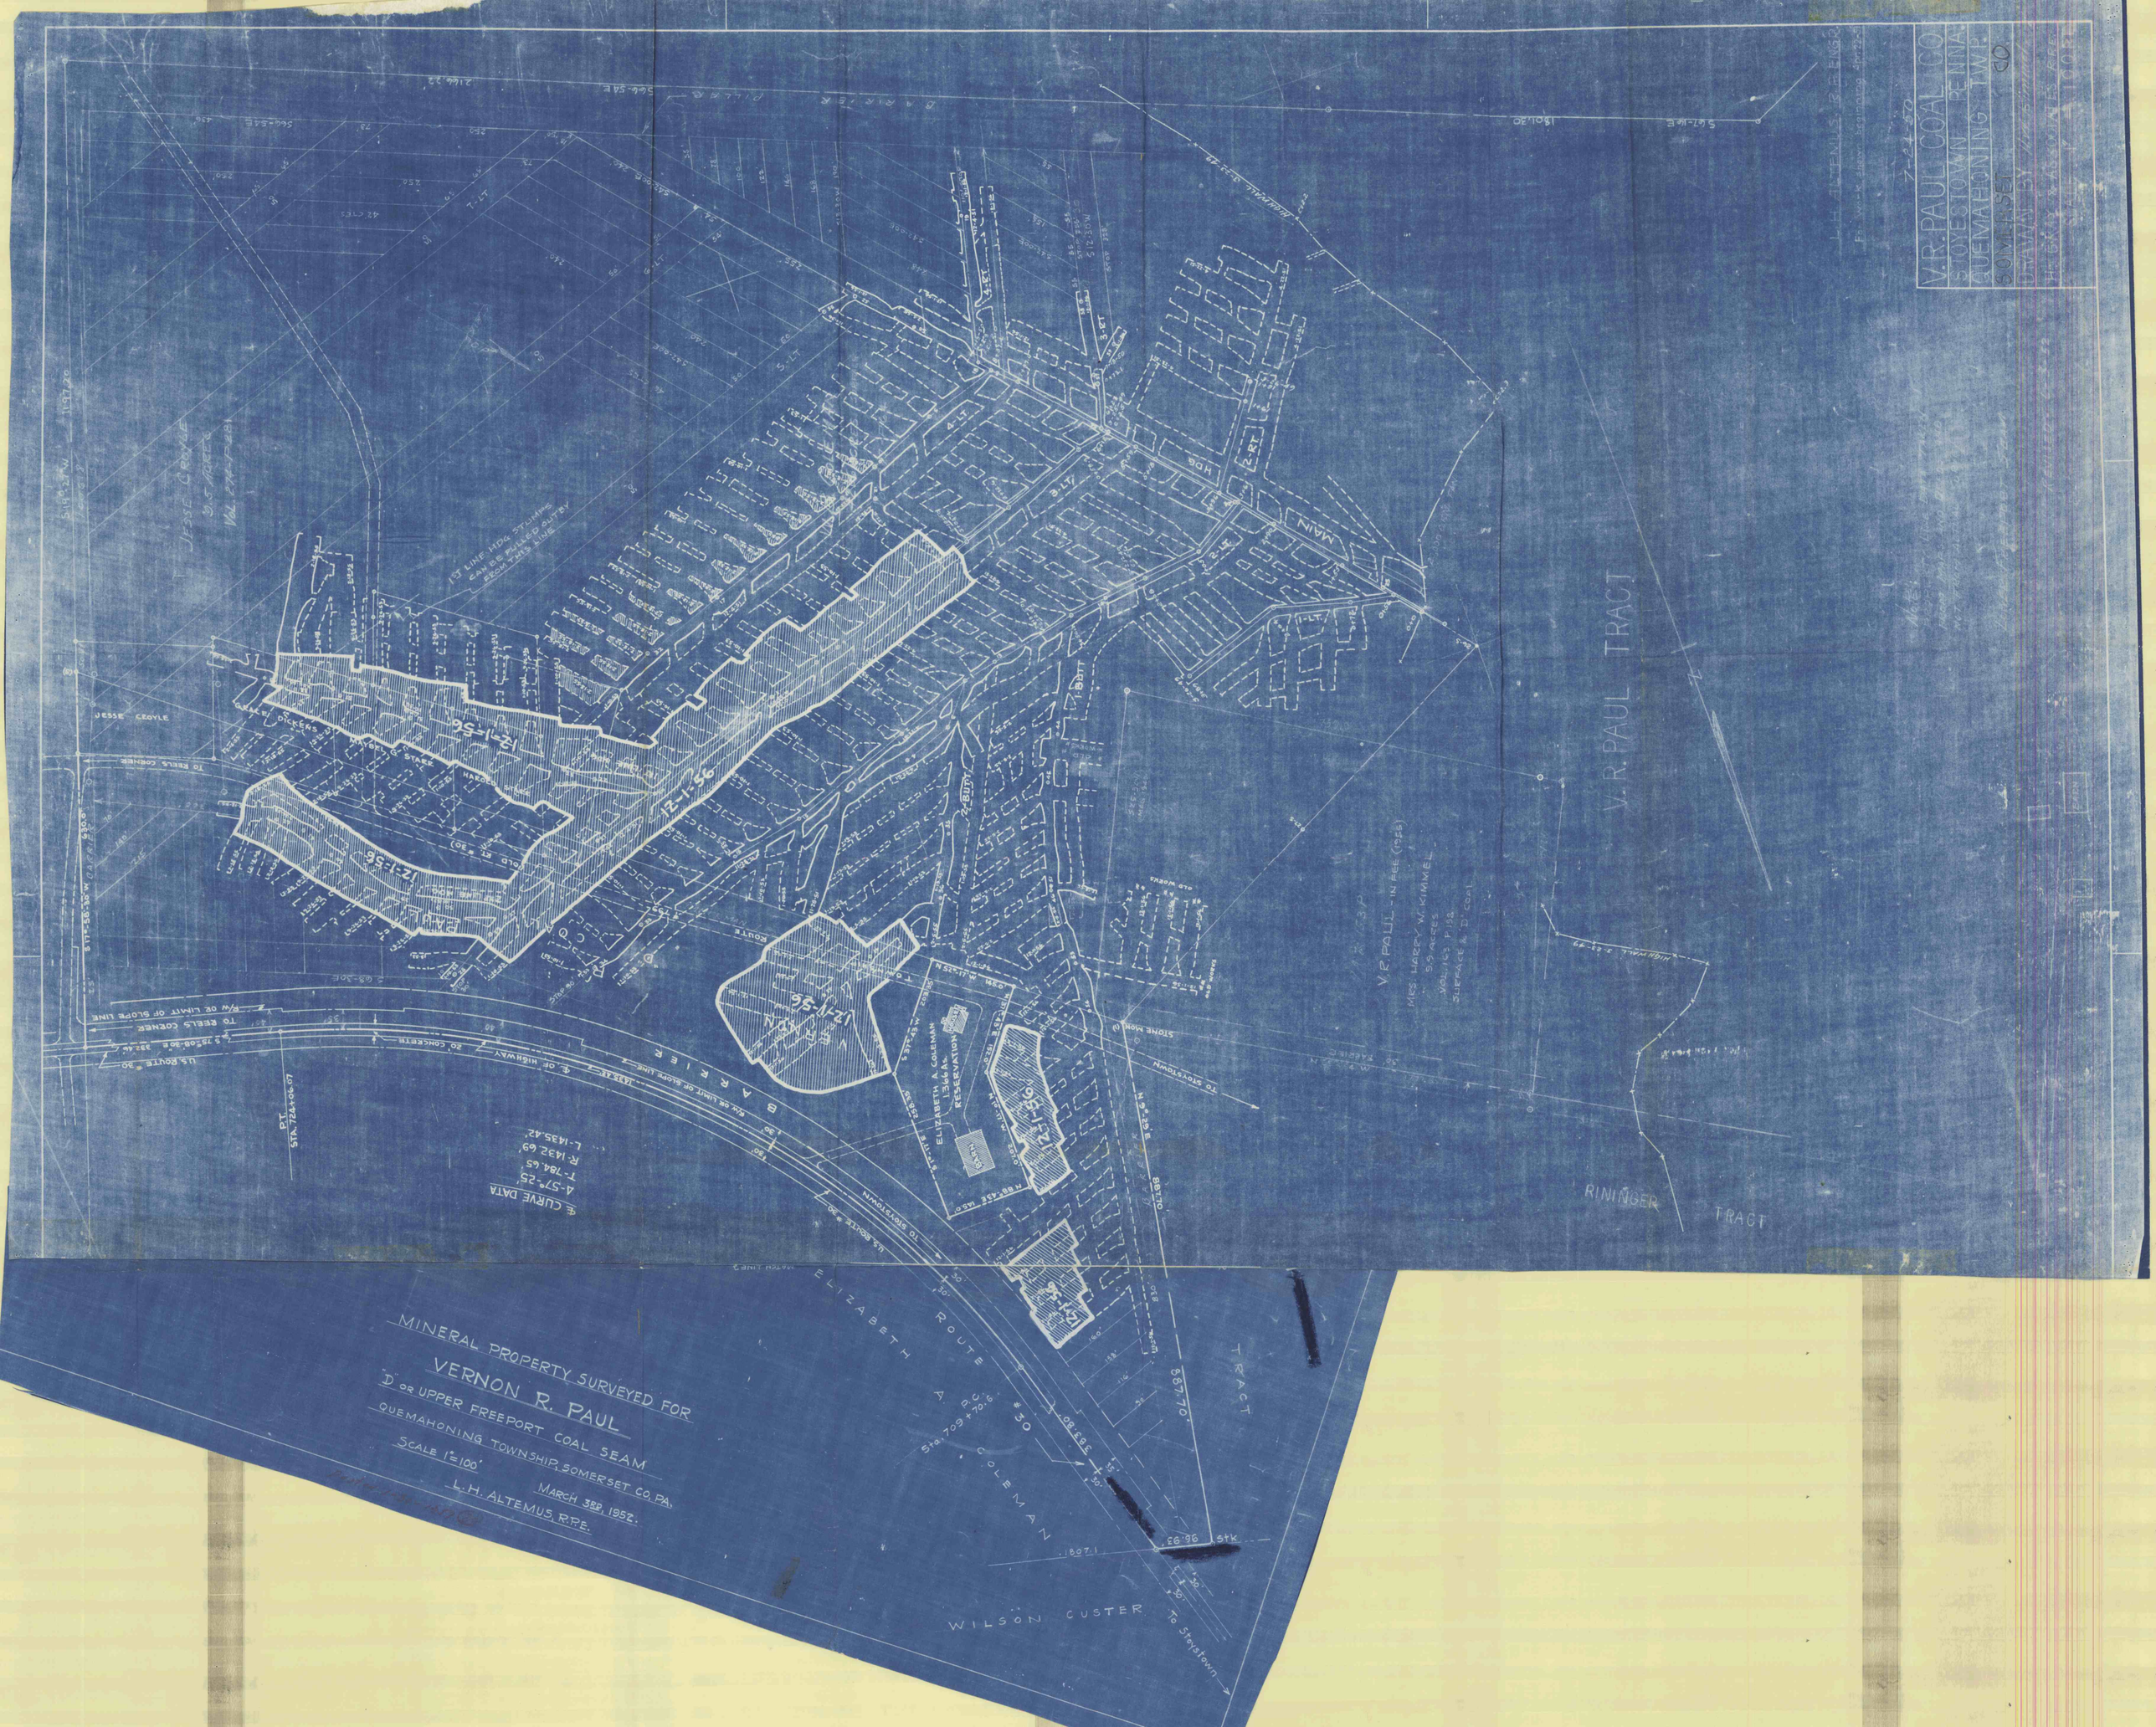
V.R. PAUL COAL CO
STONYSTOWN PENNA.
QUEMAHONING TWP.
SOMERSET CO.
L.H. ALTEMUS, R.E. & ENGR.
V.R. PAUL TRACT
V.R. PAUL TRACT
RINIGER TRACT
BARRIER
MAIN
HDG.
1ST LINE HDG. STUMPS CAN BE PULLED OUTTA FROM THIS LINE
JESSE CEOYLE
TO FEELS CORNER
TO STONYSTOWN
U.S. ROUTE #30
ELIZABETH A. COLEMAN 136 Ac. RESERVATION
STONE MOUND
WILSON CUSTER
TO Shaystown
ELIZABETH A. COLEMAN
ROUTE #30
Sta. 709+70.6
P.C.
P.T.
Sta. 724+06.07
℄ CURVE DATA
Δ-57°-25'
T-784.45'
R-1432.69'
L-1435.42'
MINERAL PROPERTY SURVEYED FOR
VERNON R. PAUL
"D" OR UPPER FREEPORT COAL SEAM
QUEMAHONING TOWNSHIP, SOMERSET CO. PA.
SCALE 1"=100'
MARCH 3RD, 1952.
L.H. ALTEMUS, R.P.E.