


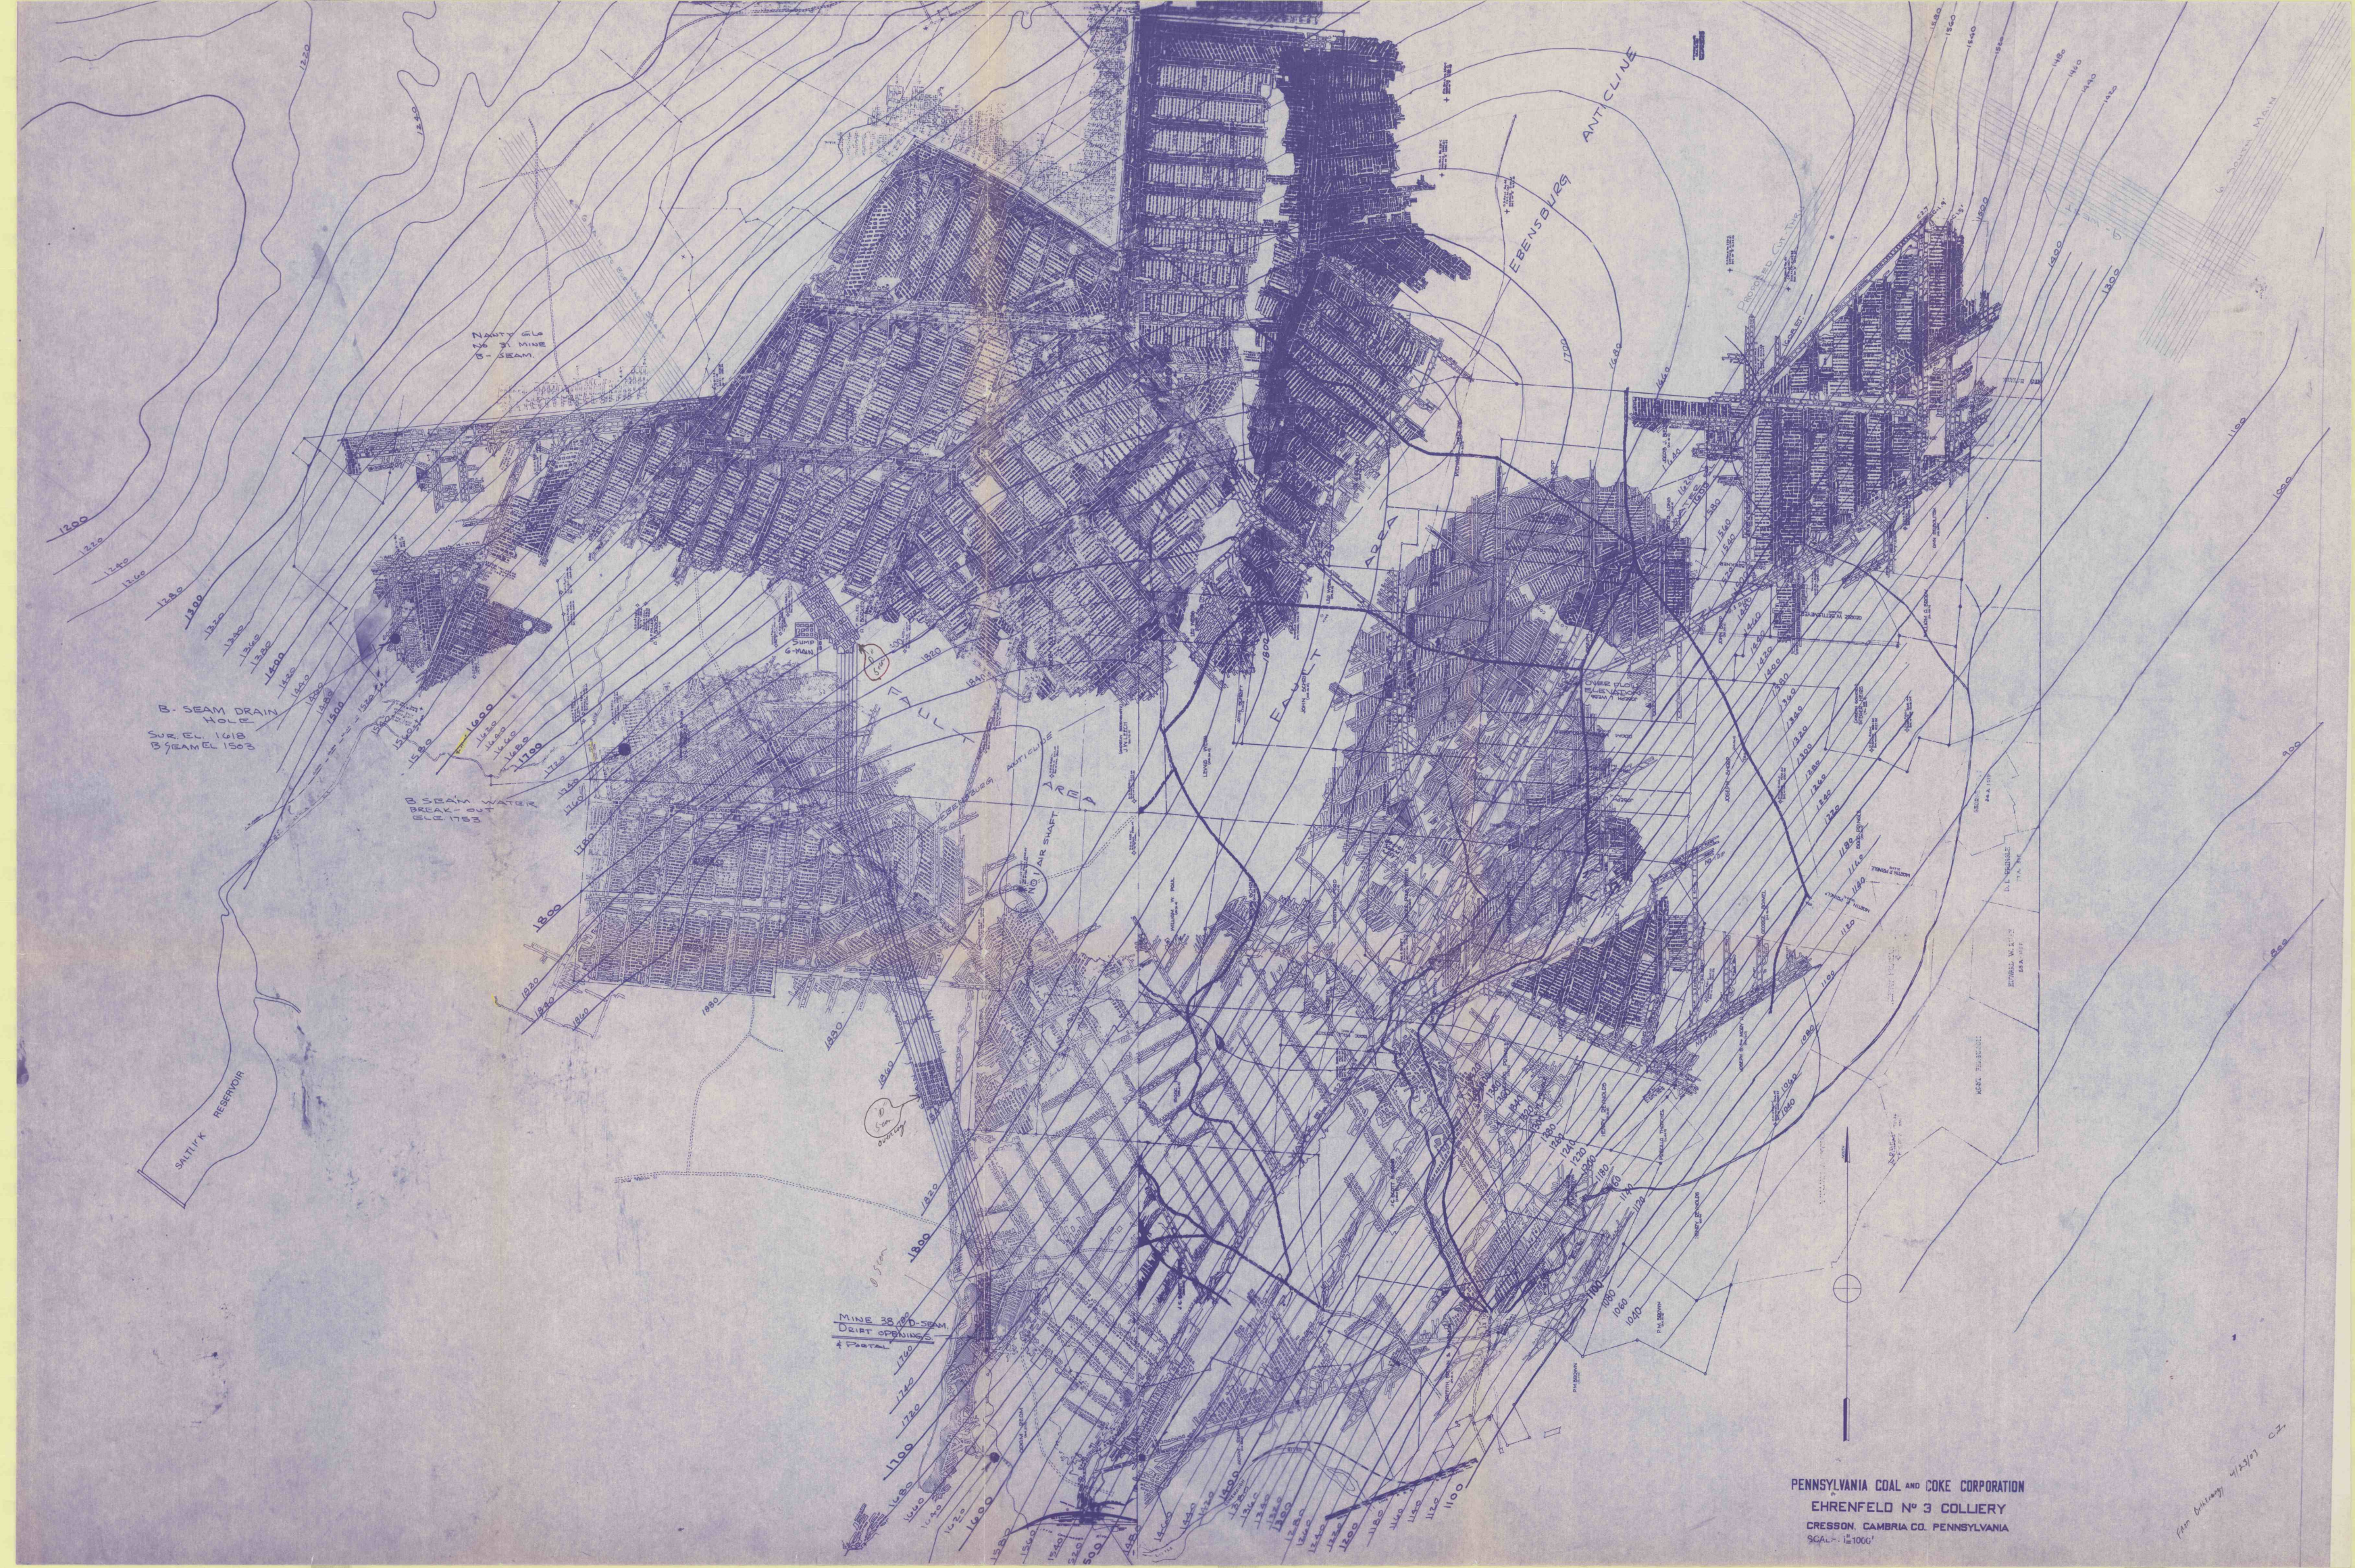

NAUTY GLS
NO 3 MINE
B-SEAM

B-SEAM DRAIN
HOLE
SUR. EL. 1618
B-SEAM EL 1503

B-SEAM WATER
BREAK-OUT
ELE 1753

MINE 38 D-SEAM
DRIFT OPENINGS
& PISTOL

PENNSYLVANIA COAL AND COKE CORPORATION
EHRENFELD NO 3 COLLIERY
CRESSON, CAMBRIA CO. PENNSYLVANIA
SCALE - 1"=1000'

From battery 4/23/01 C.J.