
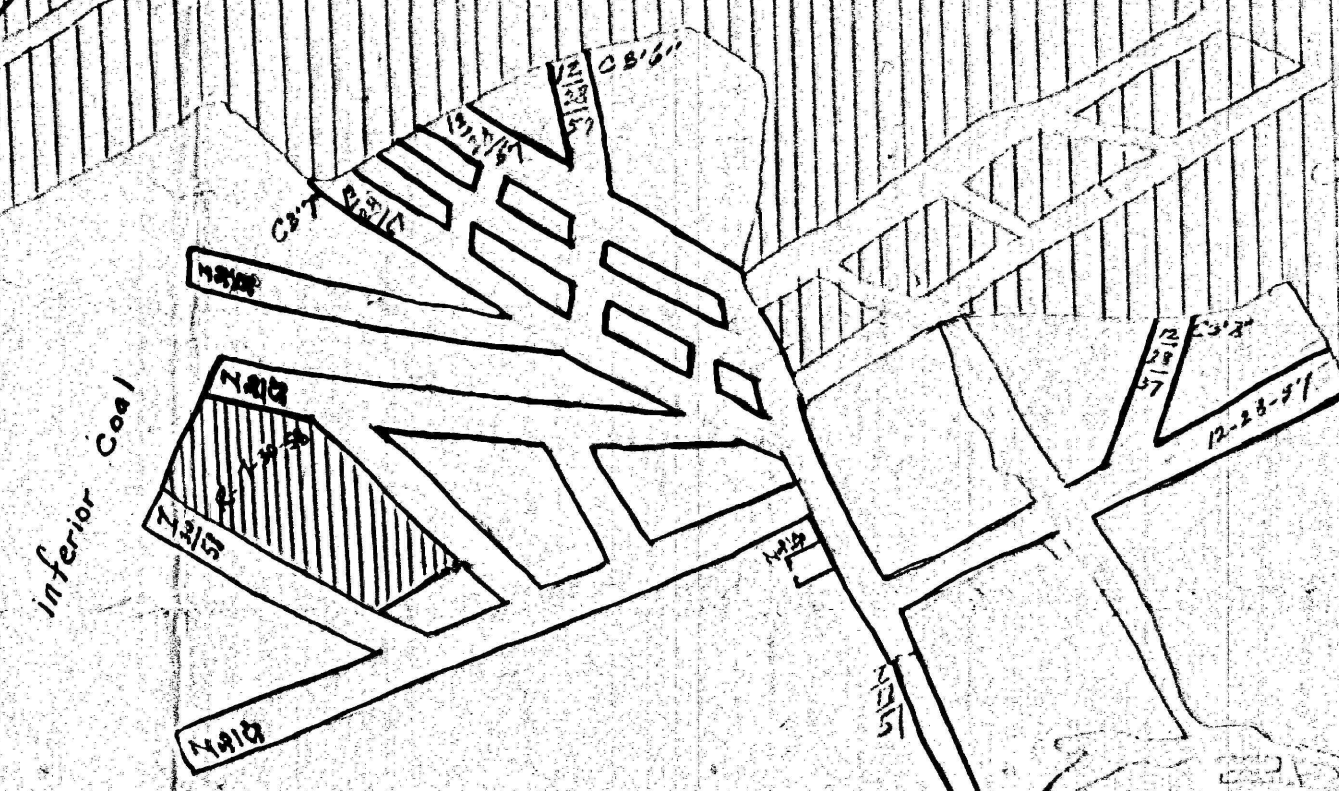


Mined Out
The B.W.C.M. Co.

Mined Out
The B.W.C.M. Co.

Tract No 772
Samuel Naugle
48.66 Ac.

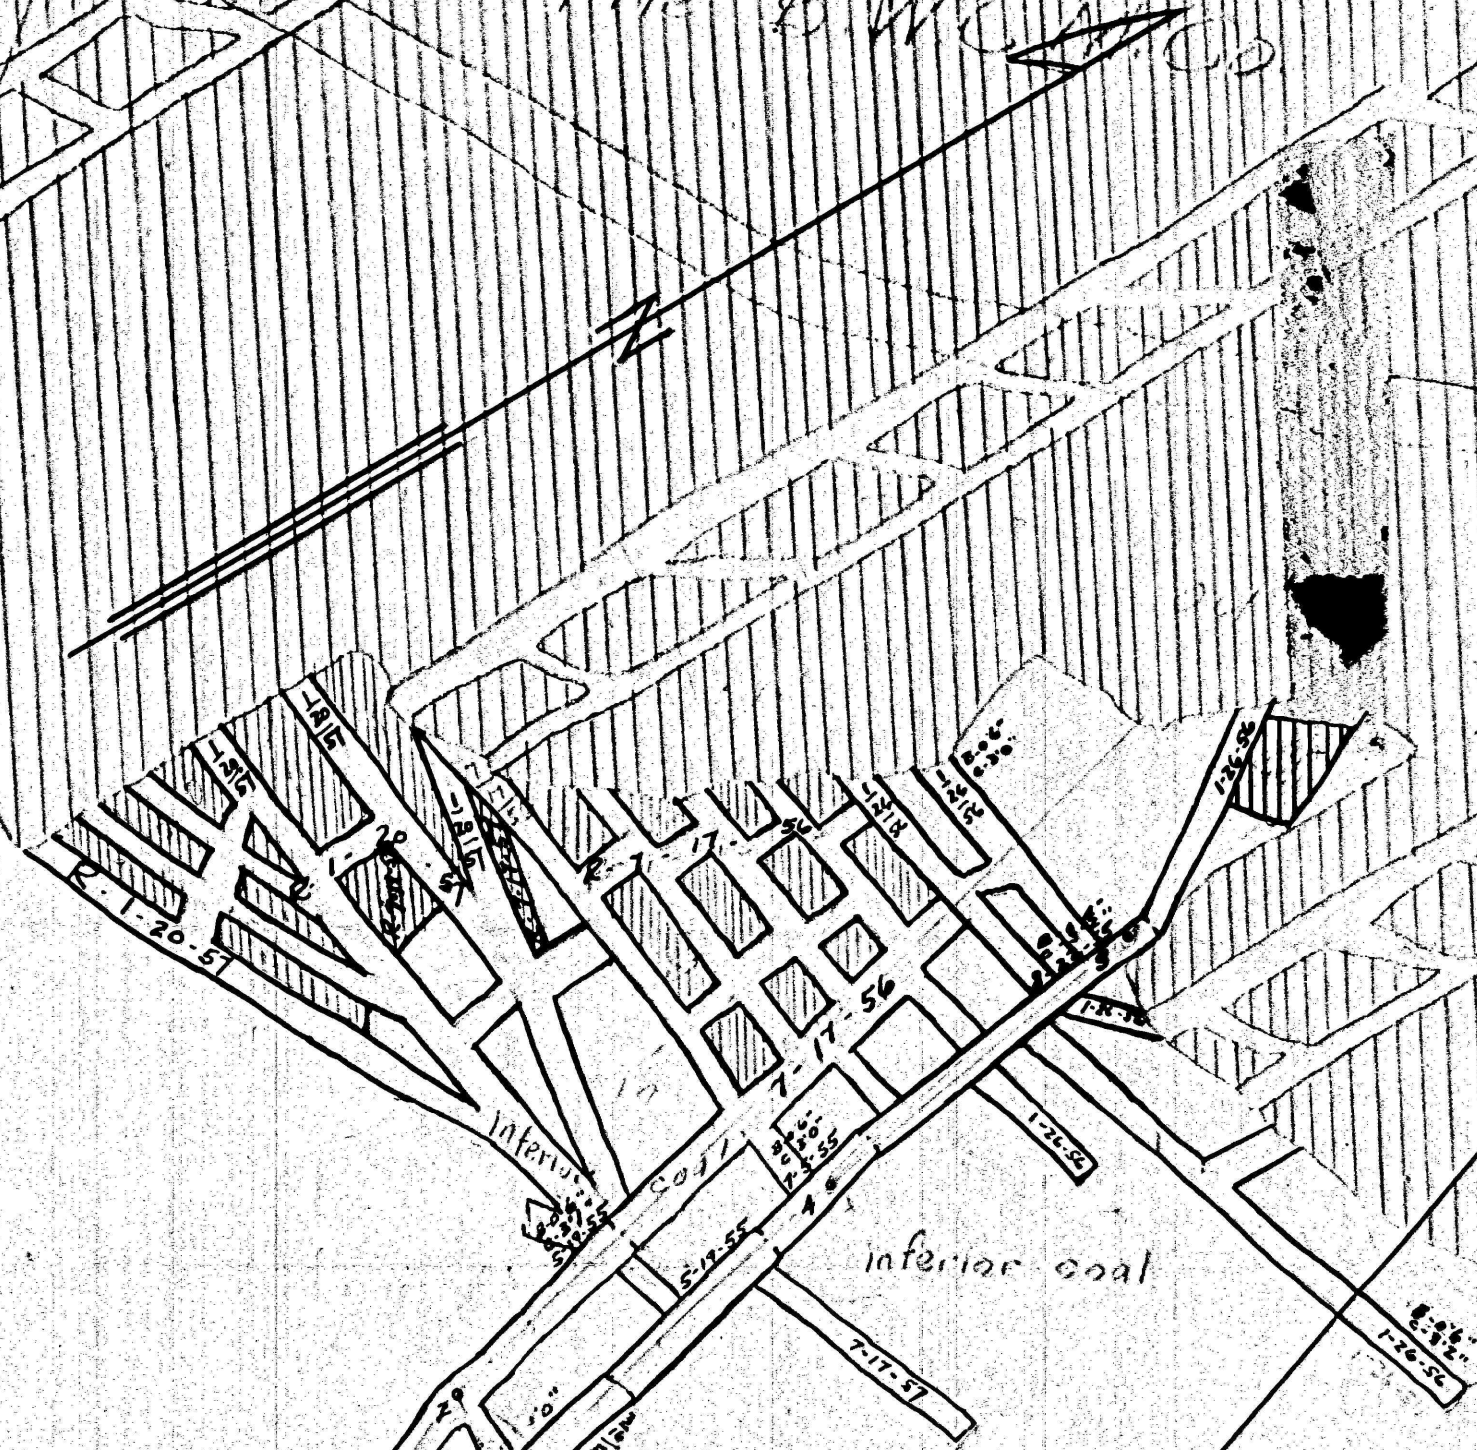

Old C' Prime Mine

Somerset Land & Coal Co.
Troy No. 7 C 24-1957

Tract No 773
Ruben Miller
141.20 Ac.

Hillsboro Coal Co.
C' Prime Seam
Situate
Paint Twp. Somerset Co. Pa.
Scale 1" = 100' Mar 16, 1955

mine & tunnel

