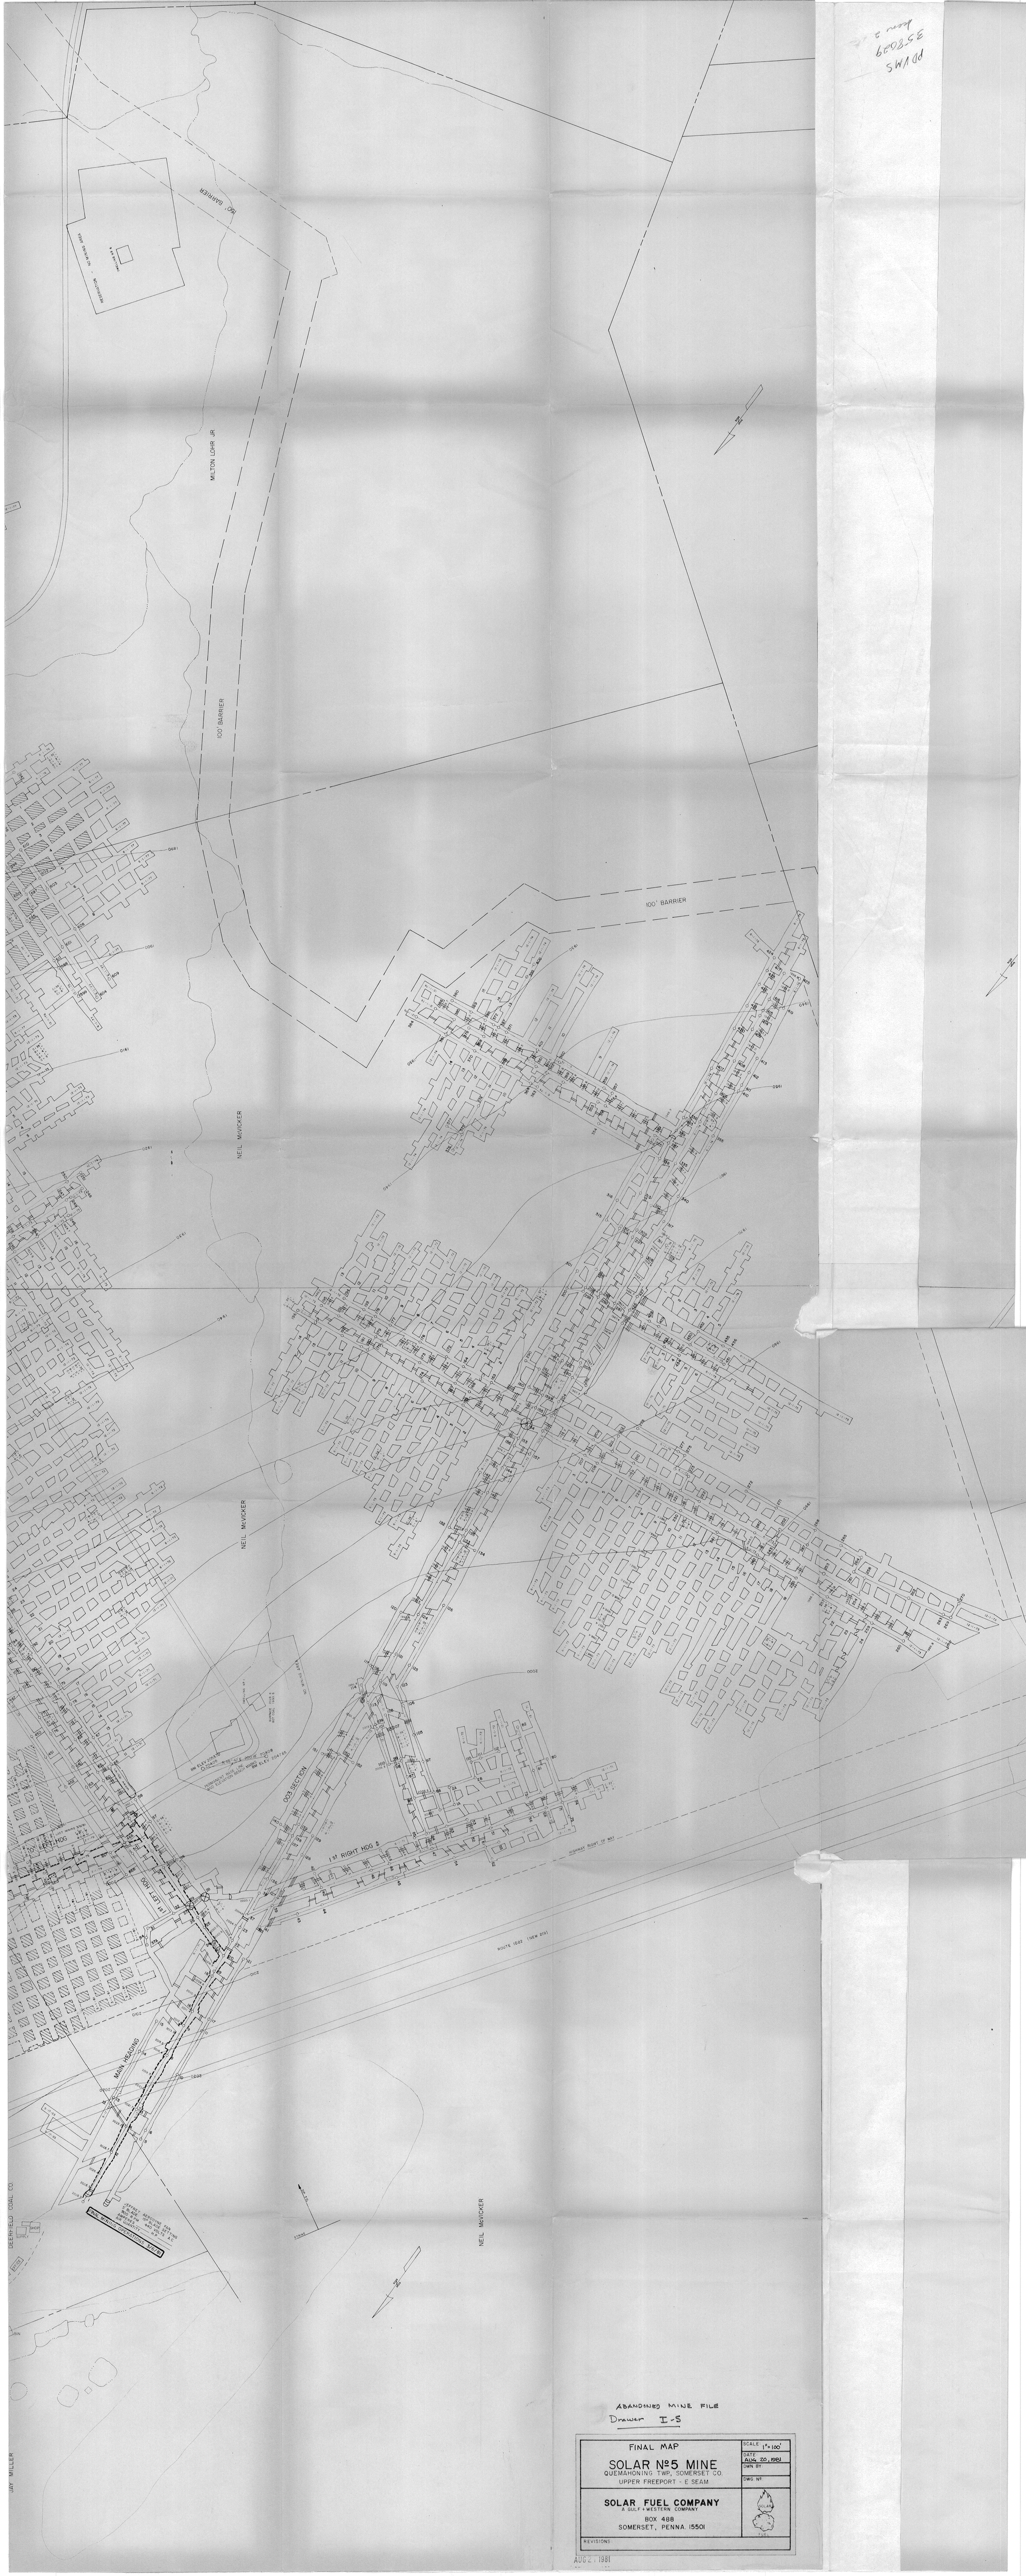

ABANDONED MINE FILE
Drawer I-S

FINAL MAP

SOLAR Nº5 MINE
QUEMAHONING TWP, SOMERSET CO
UPPER FREEPORT - E SEAM

SCALE 1"=100'
DATE AUG. 20, 1980
DWN BY
CHKD BY

SOLAR FUEL COMPANY
A GULF + WESTERN COMPANY
BOX 488
SOMERSET, PENNA. 15501

REVISIONS

AUG 21 1981