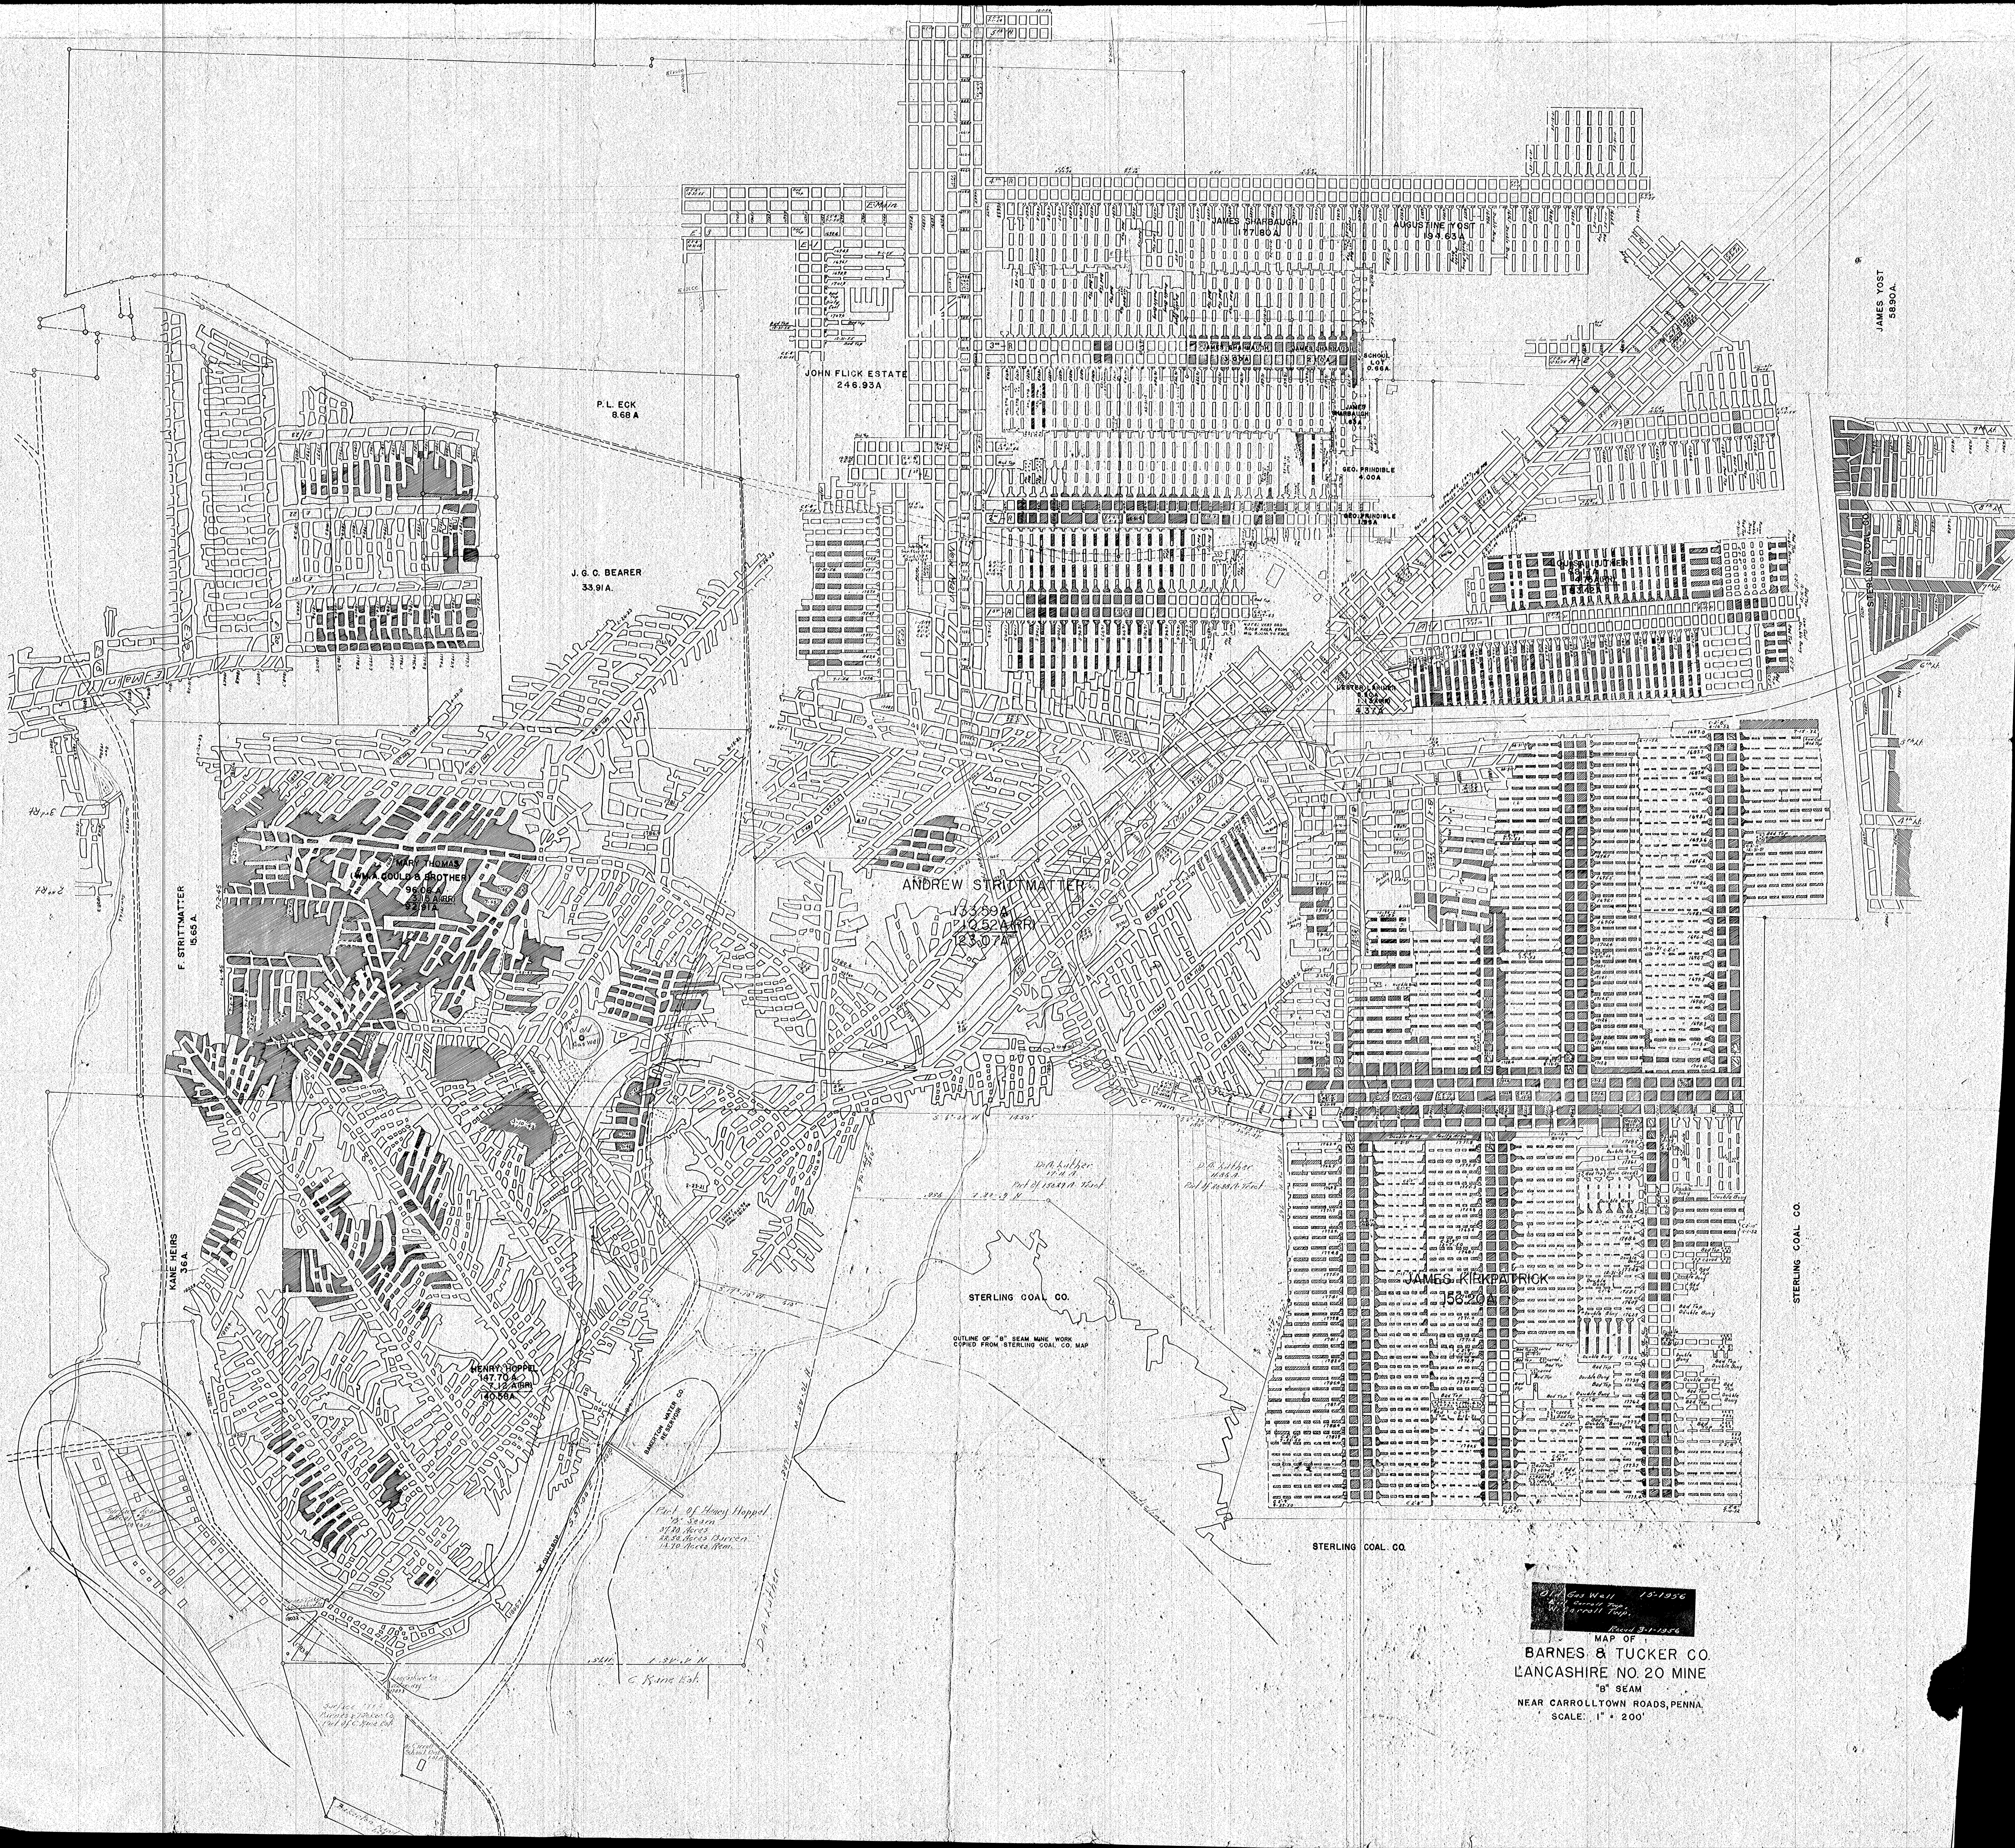
P.L. ECK
8.68 A
J. G. C. BEARER
33.91 A.
JOHN FLICK ESTATE
246.93A
JAMES SHARBAUGH
177.80 A
AUGUSTINE YOST
194.63 A
JAMES SHARBAUGH
SCHOOL LOT
0.66A.
JAMES SHARBAUGH
1.63A
GEO. PRINDIBLE
4.00A
GEO. PRINDIBLE
1.93A
LOUISA LUTHER
LESTER LARIMER
5.50A
1.13A(RR)
4.37A
JAMES YOST
58.90 A.
STERLING COAL CO.
MARY THOMAS
(WM. A. GOULD & BROTHER)
96.06 A
3.15 A(RR)
92.91 A
F. STRITTMATTER
15.65 A.
ANDREW STRITTMATTER
133.59A
10.52A(RR)
123.07A
KANE HEIRS
36 A.
HENRY HOPPEL
147.70 A.
7.12 A(RR)
140.58A.
Old Gas Well
BAKERTON WATER CO. RESERVOIR
Part of Henry Hoppel
"B" Seam
37.20 Acres
22.50 Acres Barren
14.70 Acres Rem.
D.A. Luther
C. Kane Est.
STERLING COAL CO.
OUTLINE OF "B" SEAM MINE WORK
COPIED FROM STERLING COAL CO. MAP
D.A. Luther
17.4 A.
Part of 158.29 A. Tract
D.A. Luther
11.86 A.
Part of 80.88 A. Tract
JAMES KIRKPATRICK
156.20A
STERLING COAL CO.
STERLING COAL CO.
E. Main
New Main
C Main
1st R
2nd R
3rd R
4th R
5th R
A-1
A-2
A-3
B-1
B-3
E-1
E-3
4th Lt.
5th Lt.
6th Lt.
7th Lt.
8th Lt.
9th Lt.
3rd Rt.
2nd Rt.
Surface Lease Parcel #2
Lancashire #20 Water Well
Surface 33.2 Barnes & Tucker Co. Part of C. Kane Est.
W. Carroll School Dist.
Bakerton
Outcrop
Bad Top
Double Bony
NOTE: VERY BAD ROOF AREA FROM #16 ROOM TO FACE

Old Gas Well 15-1956
E. Carroll Twp.
W. Carroll Twp.
Recd 3-1-1956

MAP OF
BARNES & TUCKER CO.
LANCASHIRE NO. 20 MINE
"B" SEAM
NEAR CARROLLTOWN ROADS, PENNA.
SCALE: 1" = 200'