


"FAIROAKS PLAN"

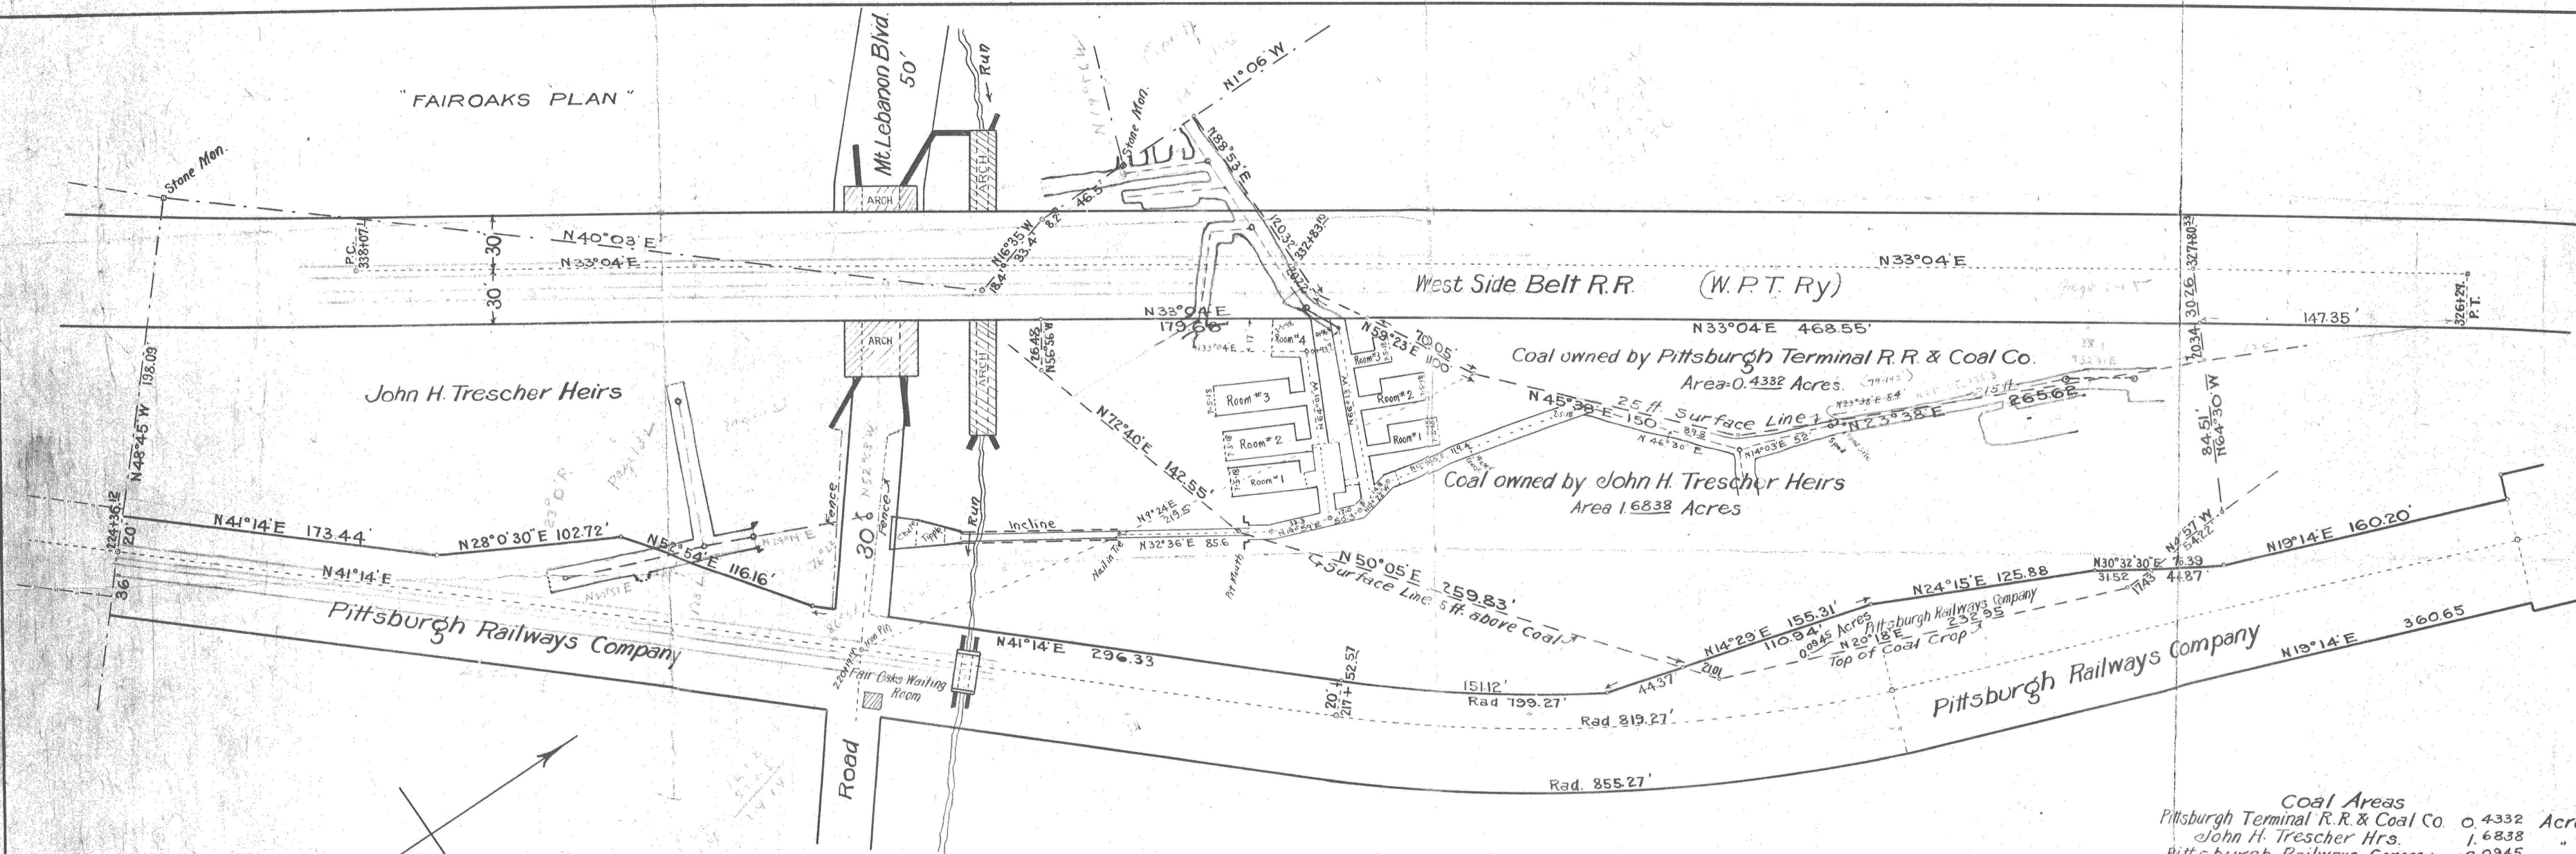

Property of
JOHN H. TRESCHER HEIRS
 Baldwin Twp, Ally Co, Pa.
 Coal Areas surveyed for Wm. F. Brown
 March 11/18.

Scale 1"=50'
 79-126
 Cal. Bk. 3-138
 79-142

T. J. McGovern
 Civil and Mining Engineer.

Coal Areas	
Pittsburgh Terminal R.R. & Coal Co.	0.4332 Acres
John H. Trescher Hrs.	1.6838 "
Pittsburgh Railways Company	0.0945 "
Total	2.2115 Acres.