


Aug 15

Aug 15

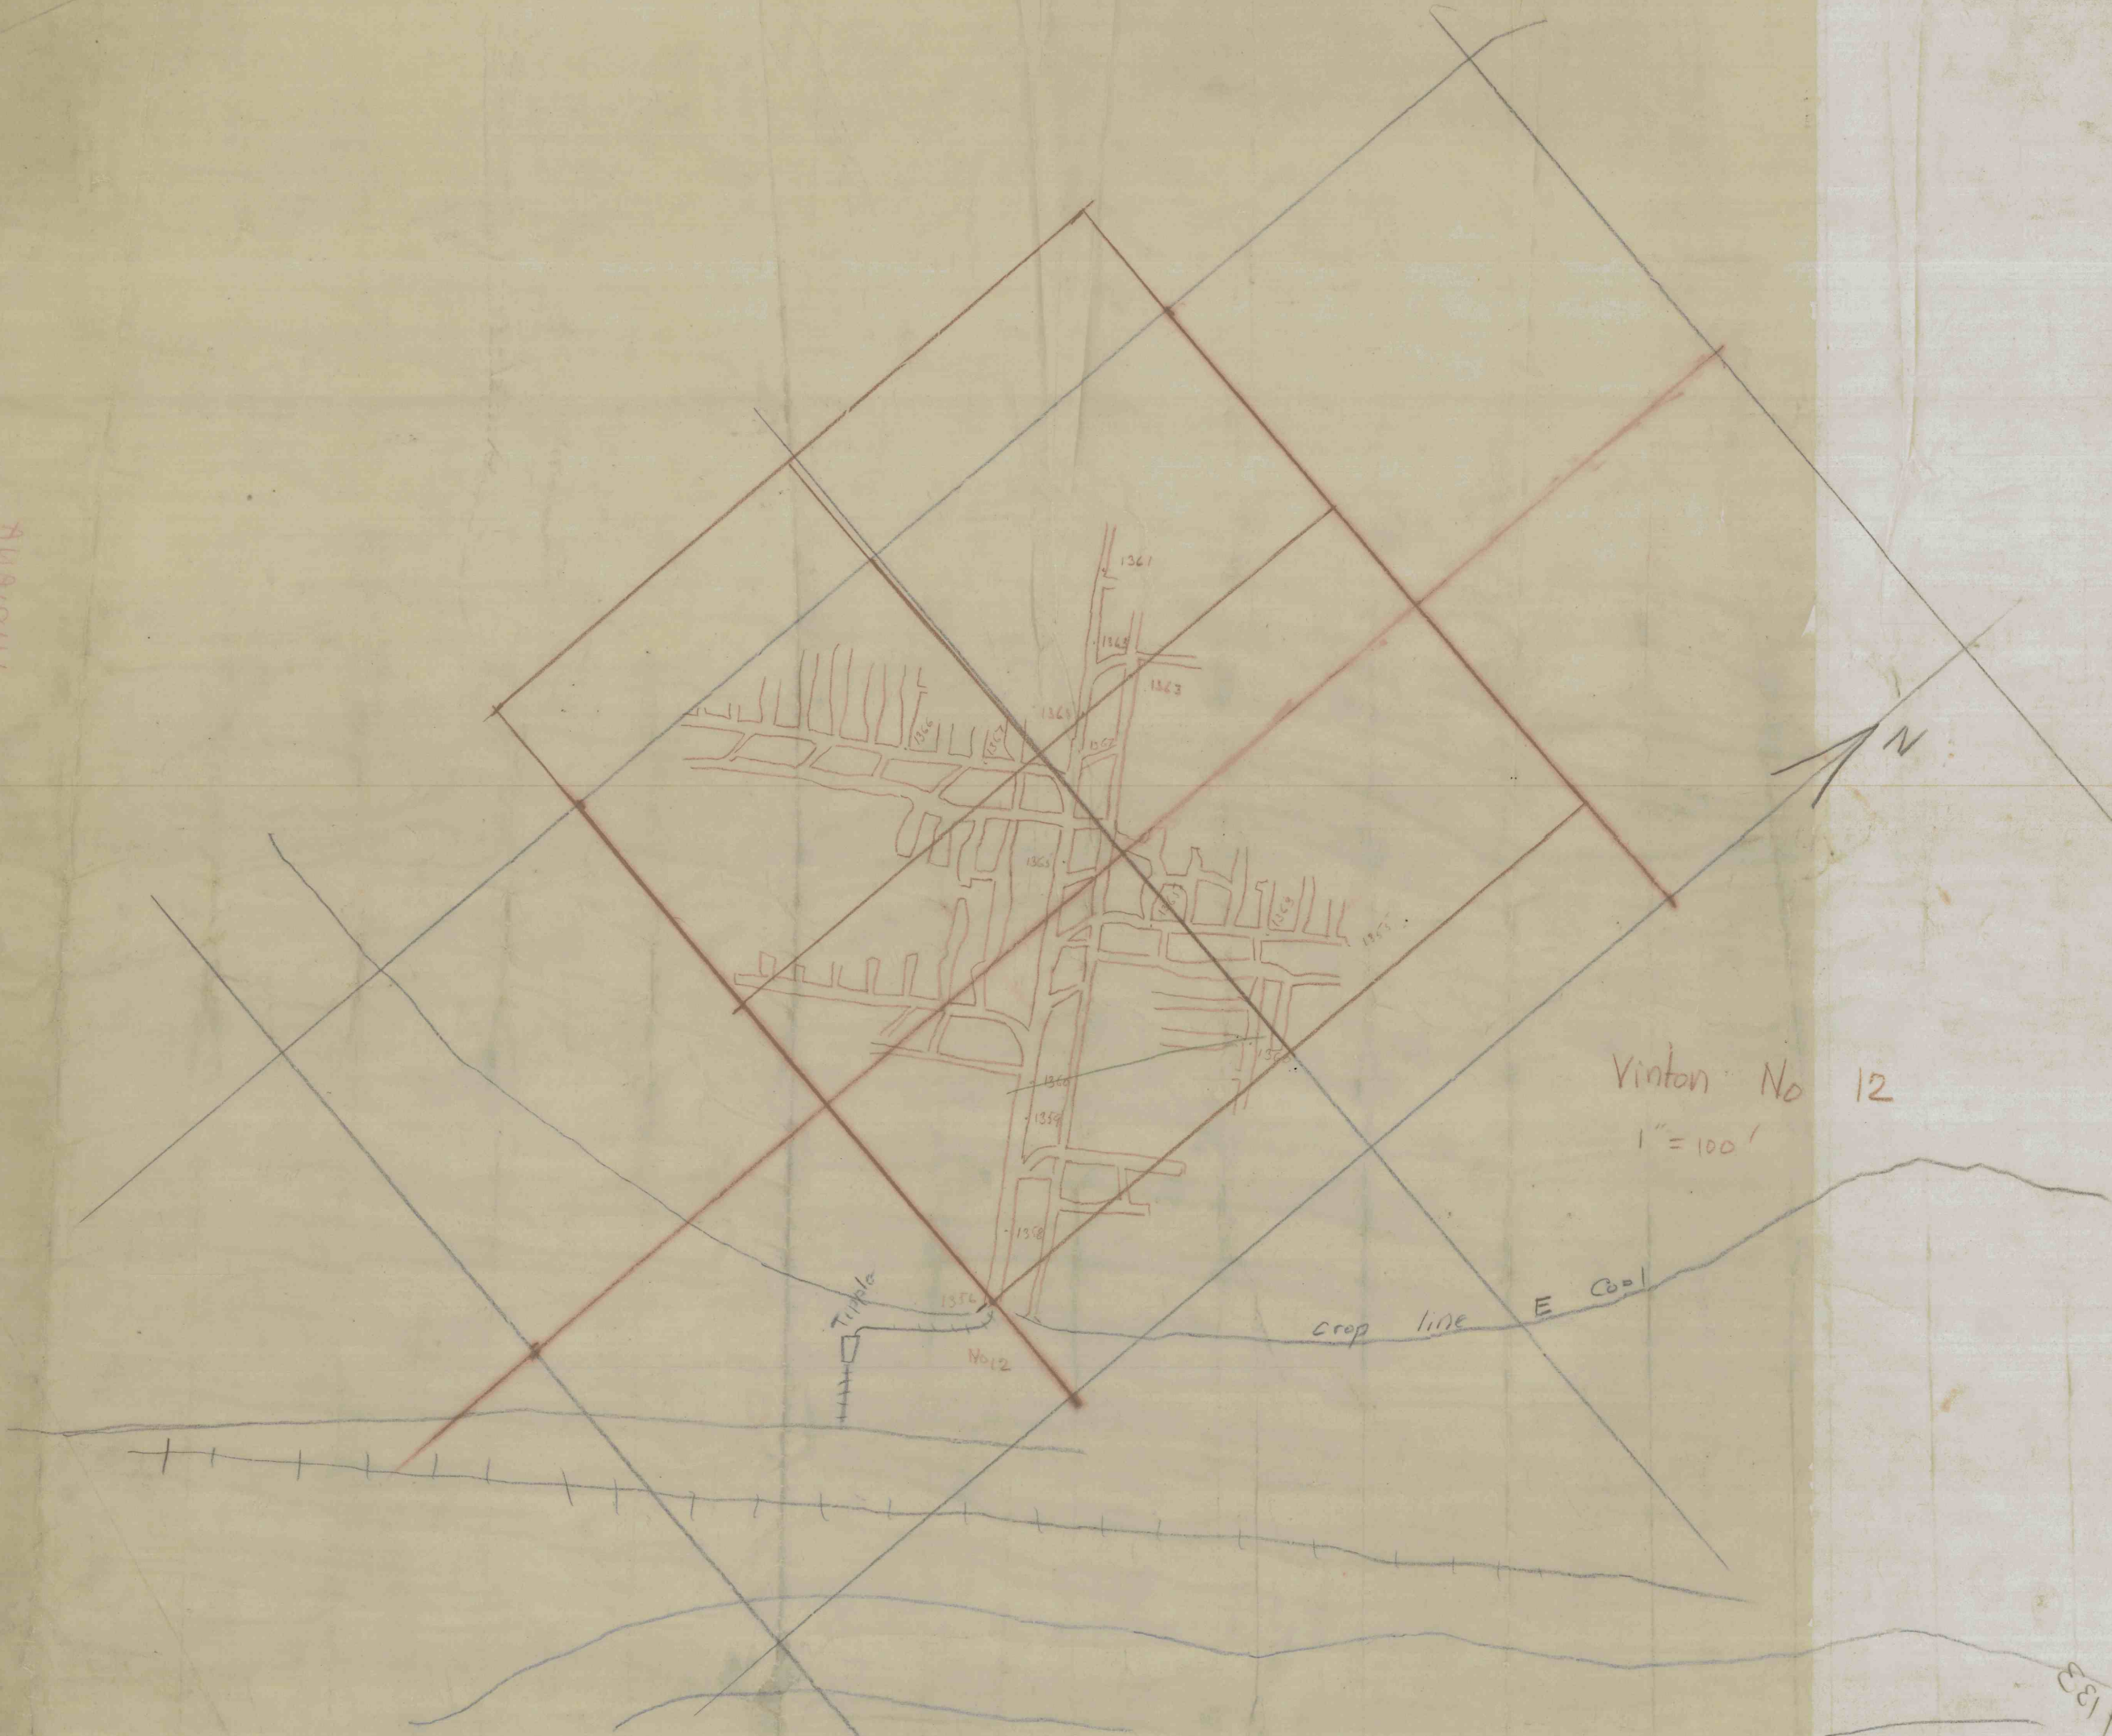

Vinton No 12
1" = 100'

crop line E Co = 1

Aug 15