


Vinton #16
 Indiana Co
 New Florence Q

1"=100'

D.D. Hole 14
 S148°
 C1411.7

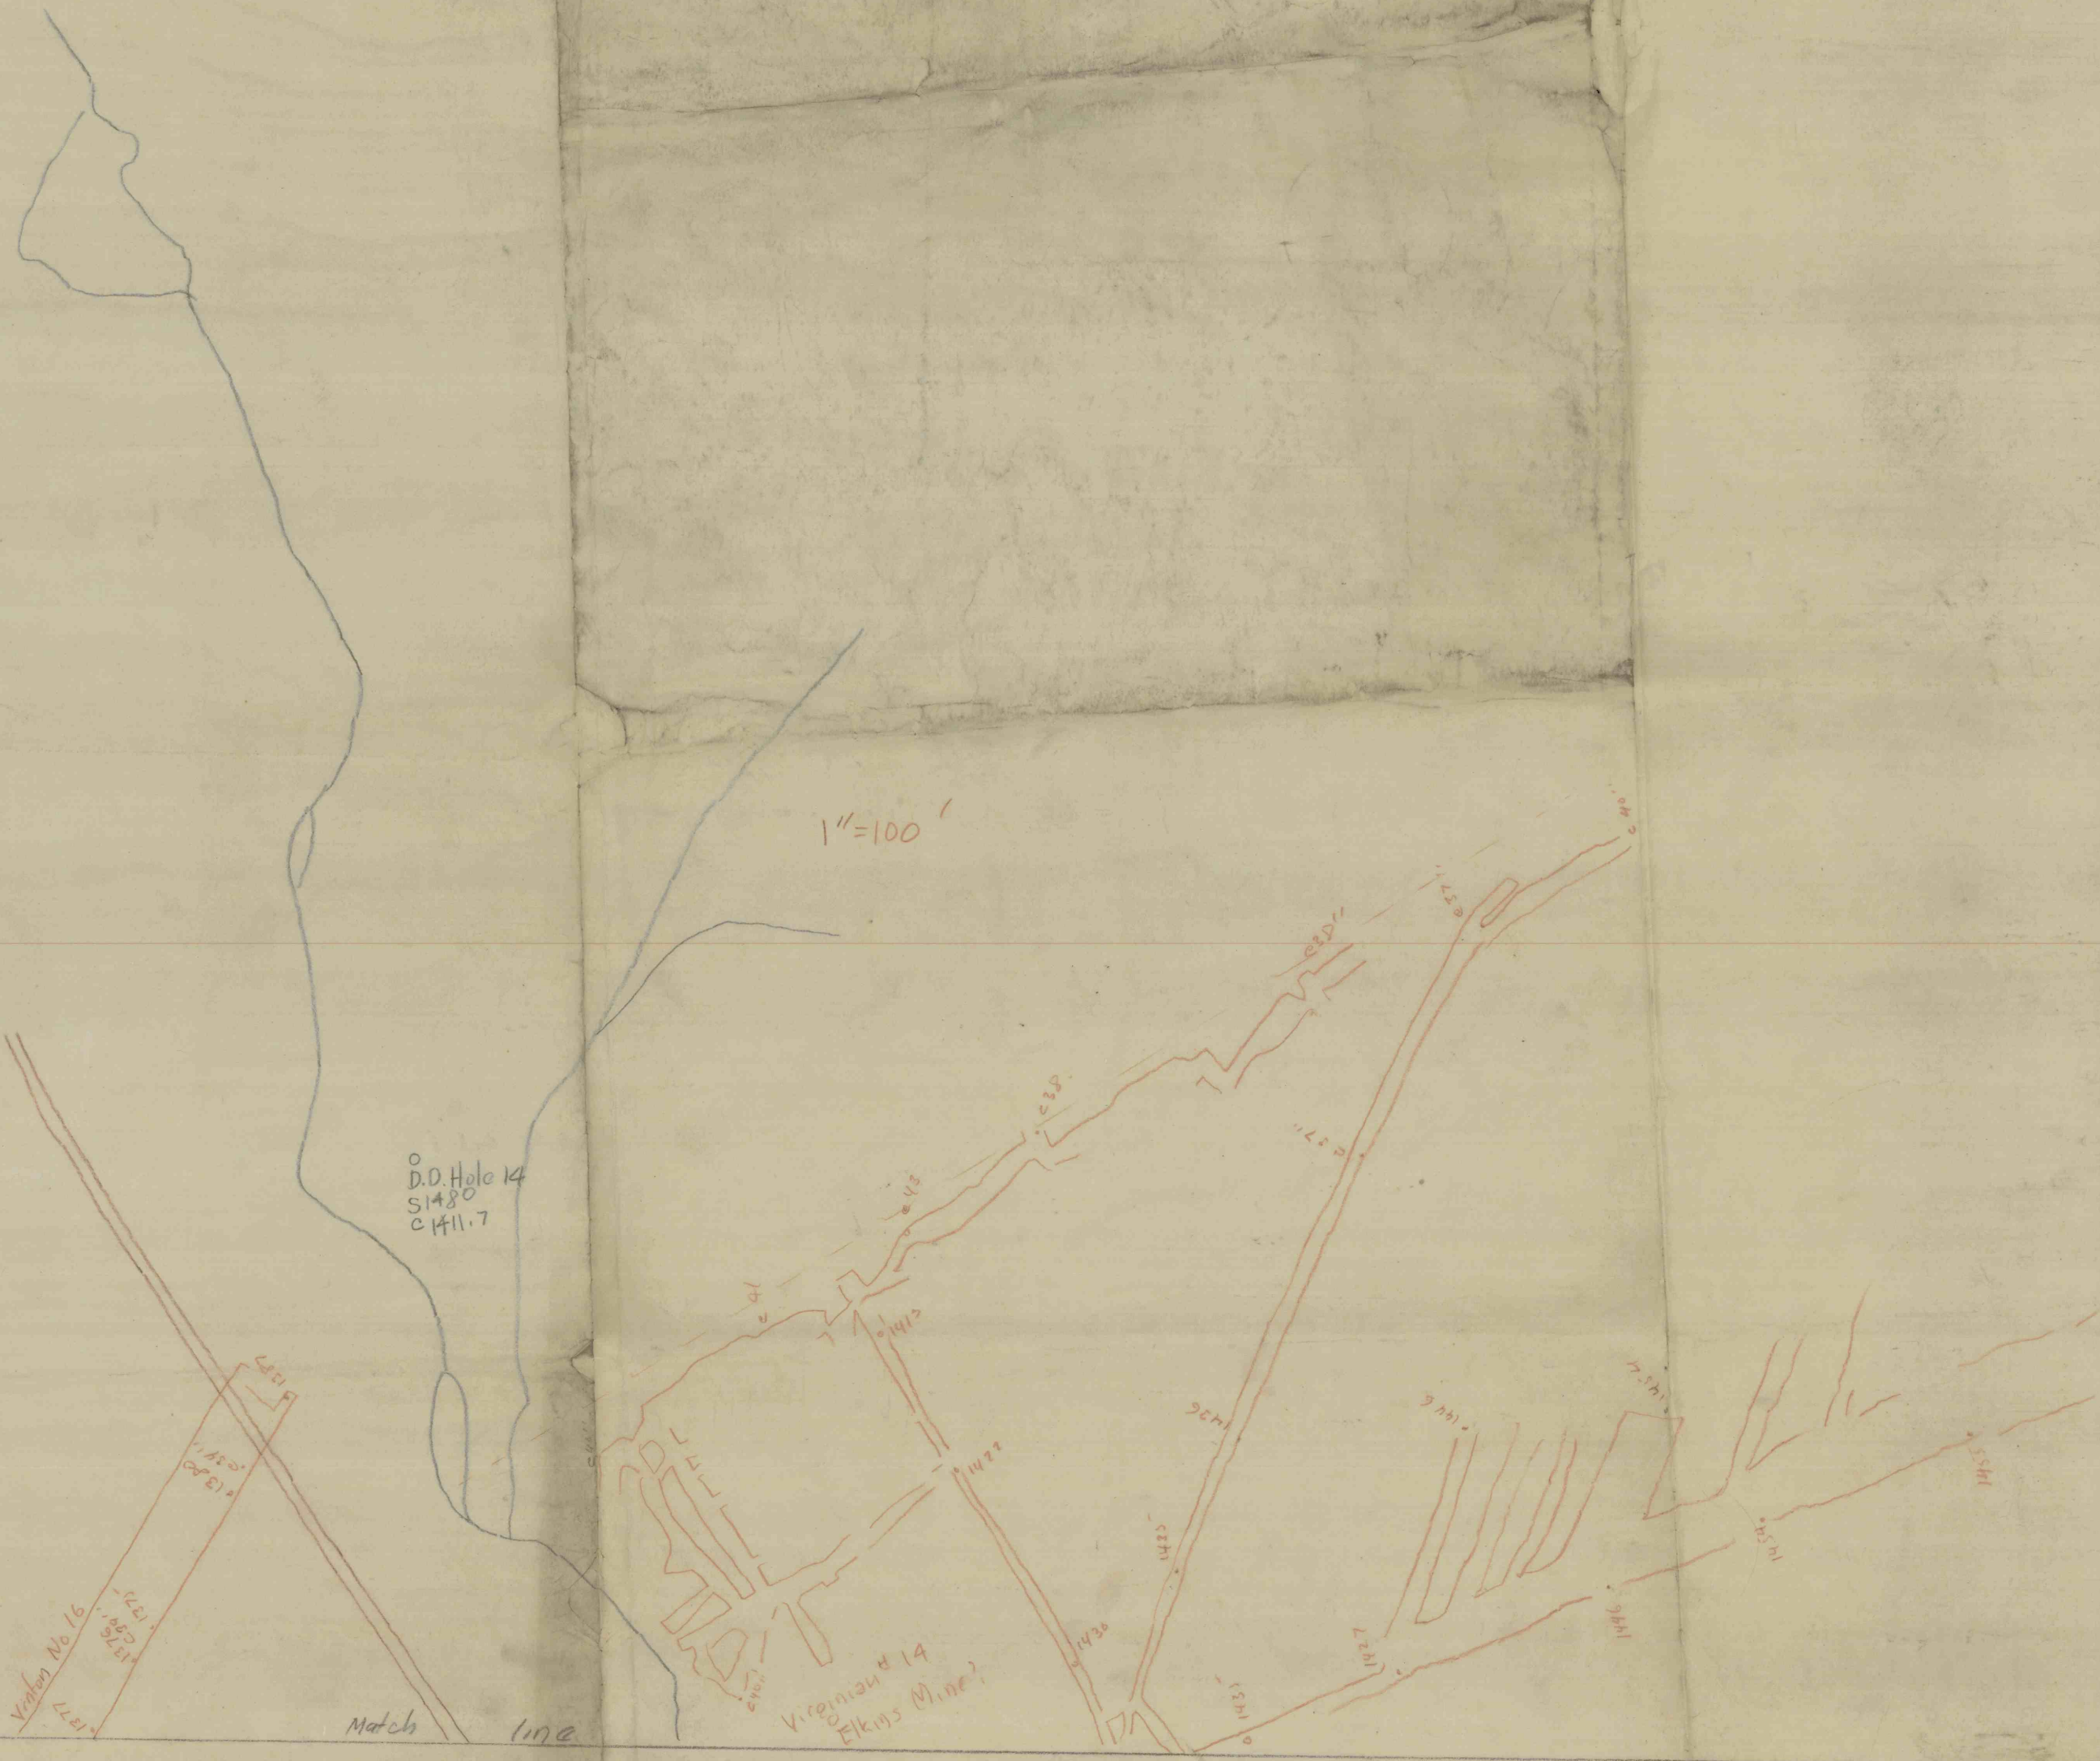

Vinton No 16

304155