
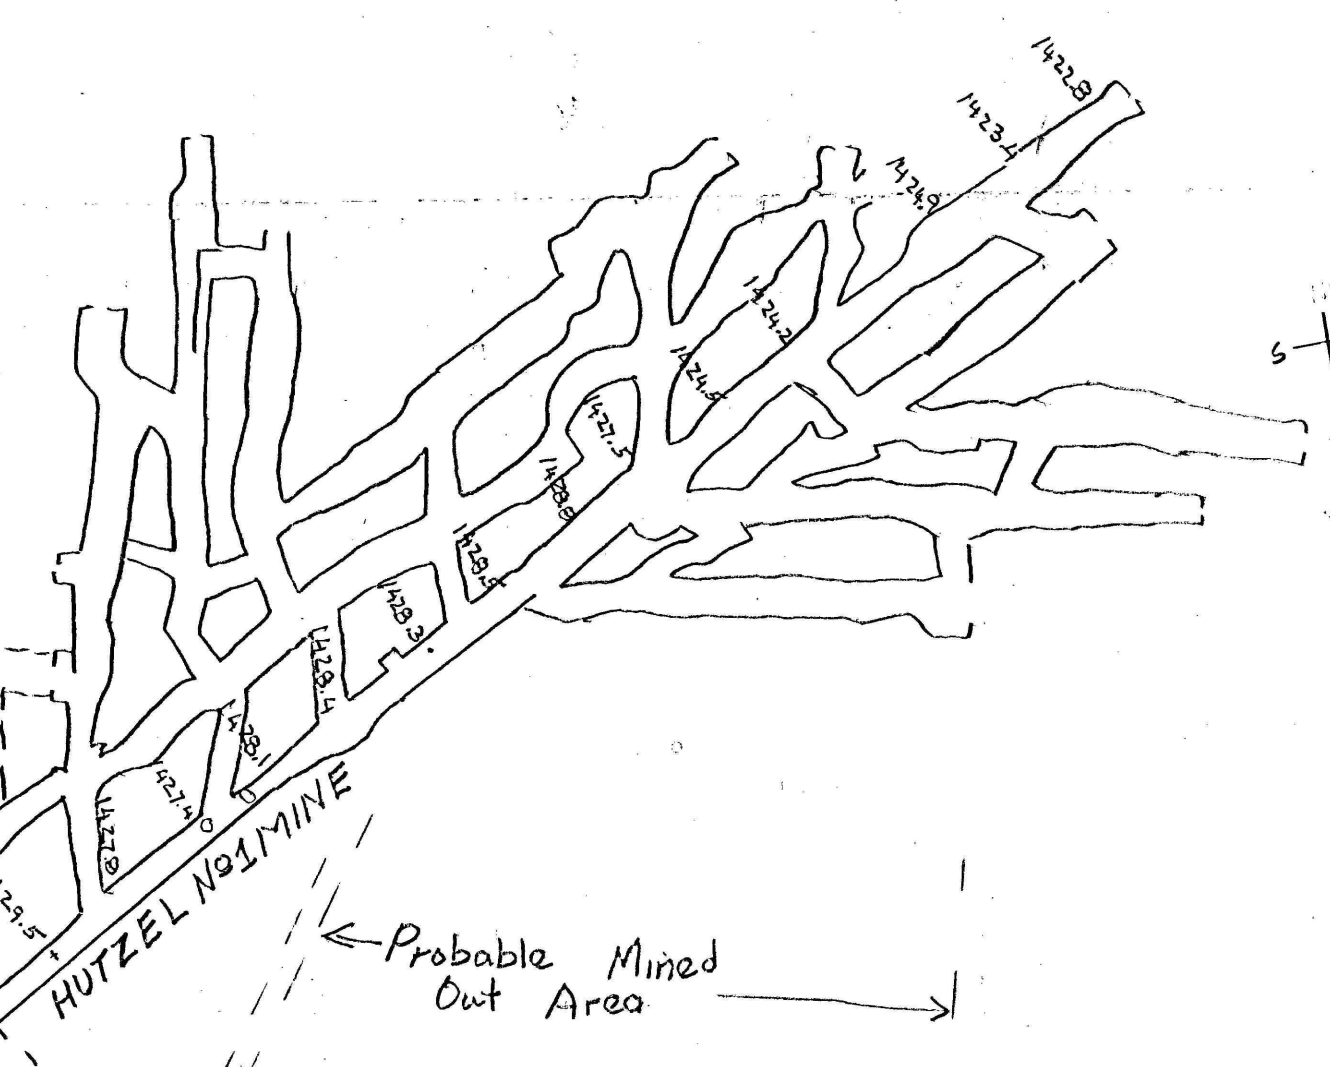
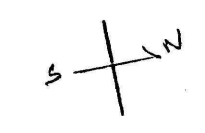
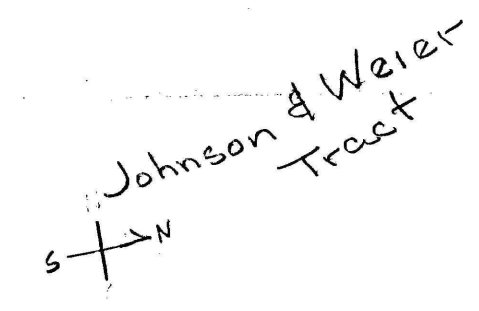


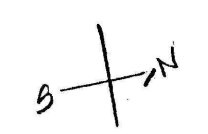


HUTZEL NO. 1 MINE

Probable Mined Out Area

STRIP - High Wall PIT

Probable Outcrop

ROUTE 1065 TO BRUSH VALLEY

BLACKLICK CREEK

Brush Valley East Wheat Field

Twp. 10 N.

A LYDICK TRACT 99.96-A

* B.M. - SIDE 16" BIRCH 1380.08

Operated By Zucco Bros.
HUTZEL COAL CO.
IN
EAST WHEAT FIELD TWP
INDIANA COUNTY, PA.
SURVEYED 8-30-48
BY H.W. MIKESELL R.P.E.
SCALE 1" = 100'

PS 1108