


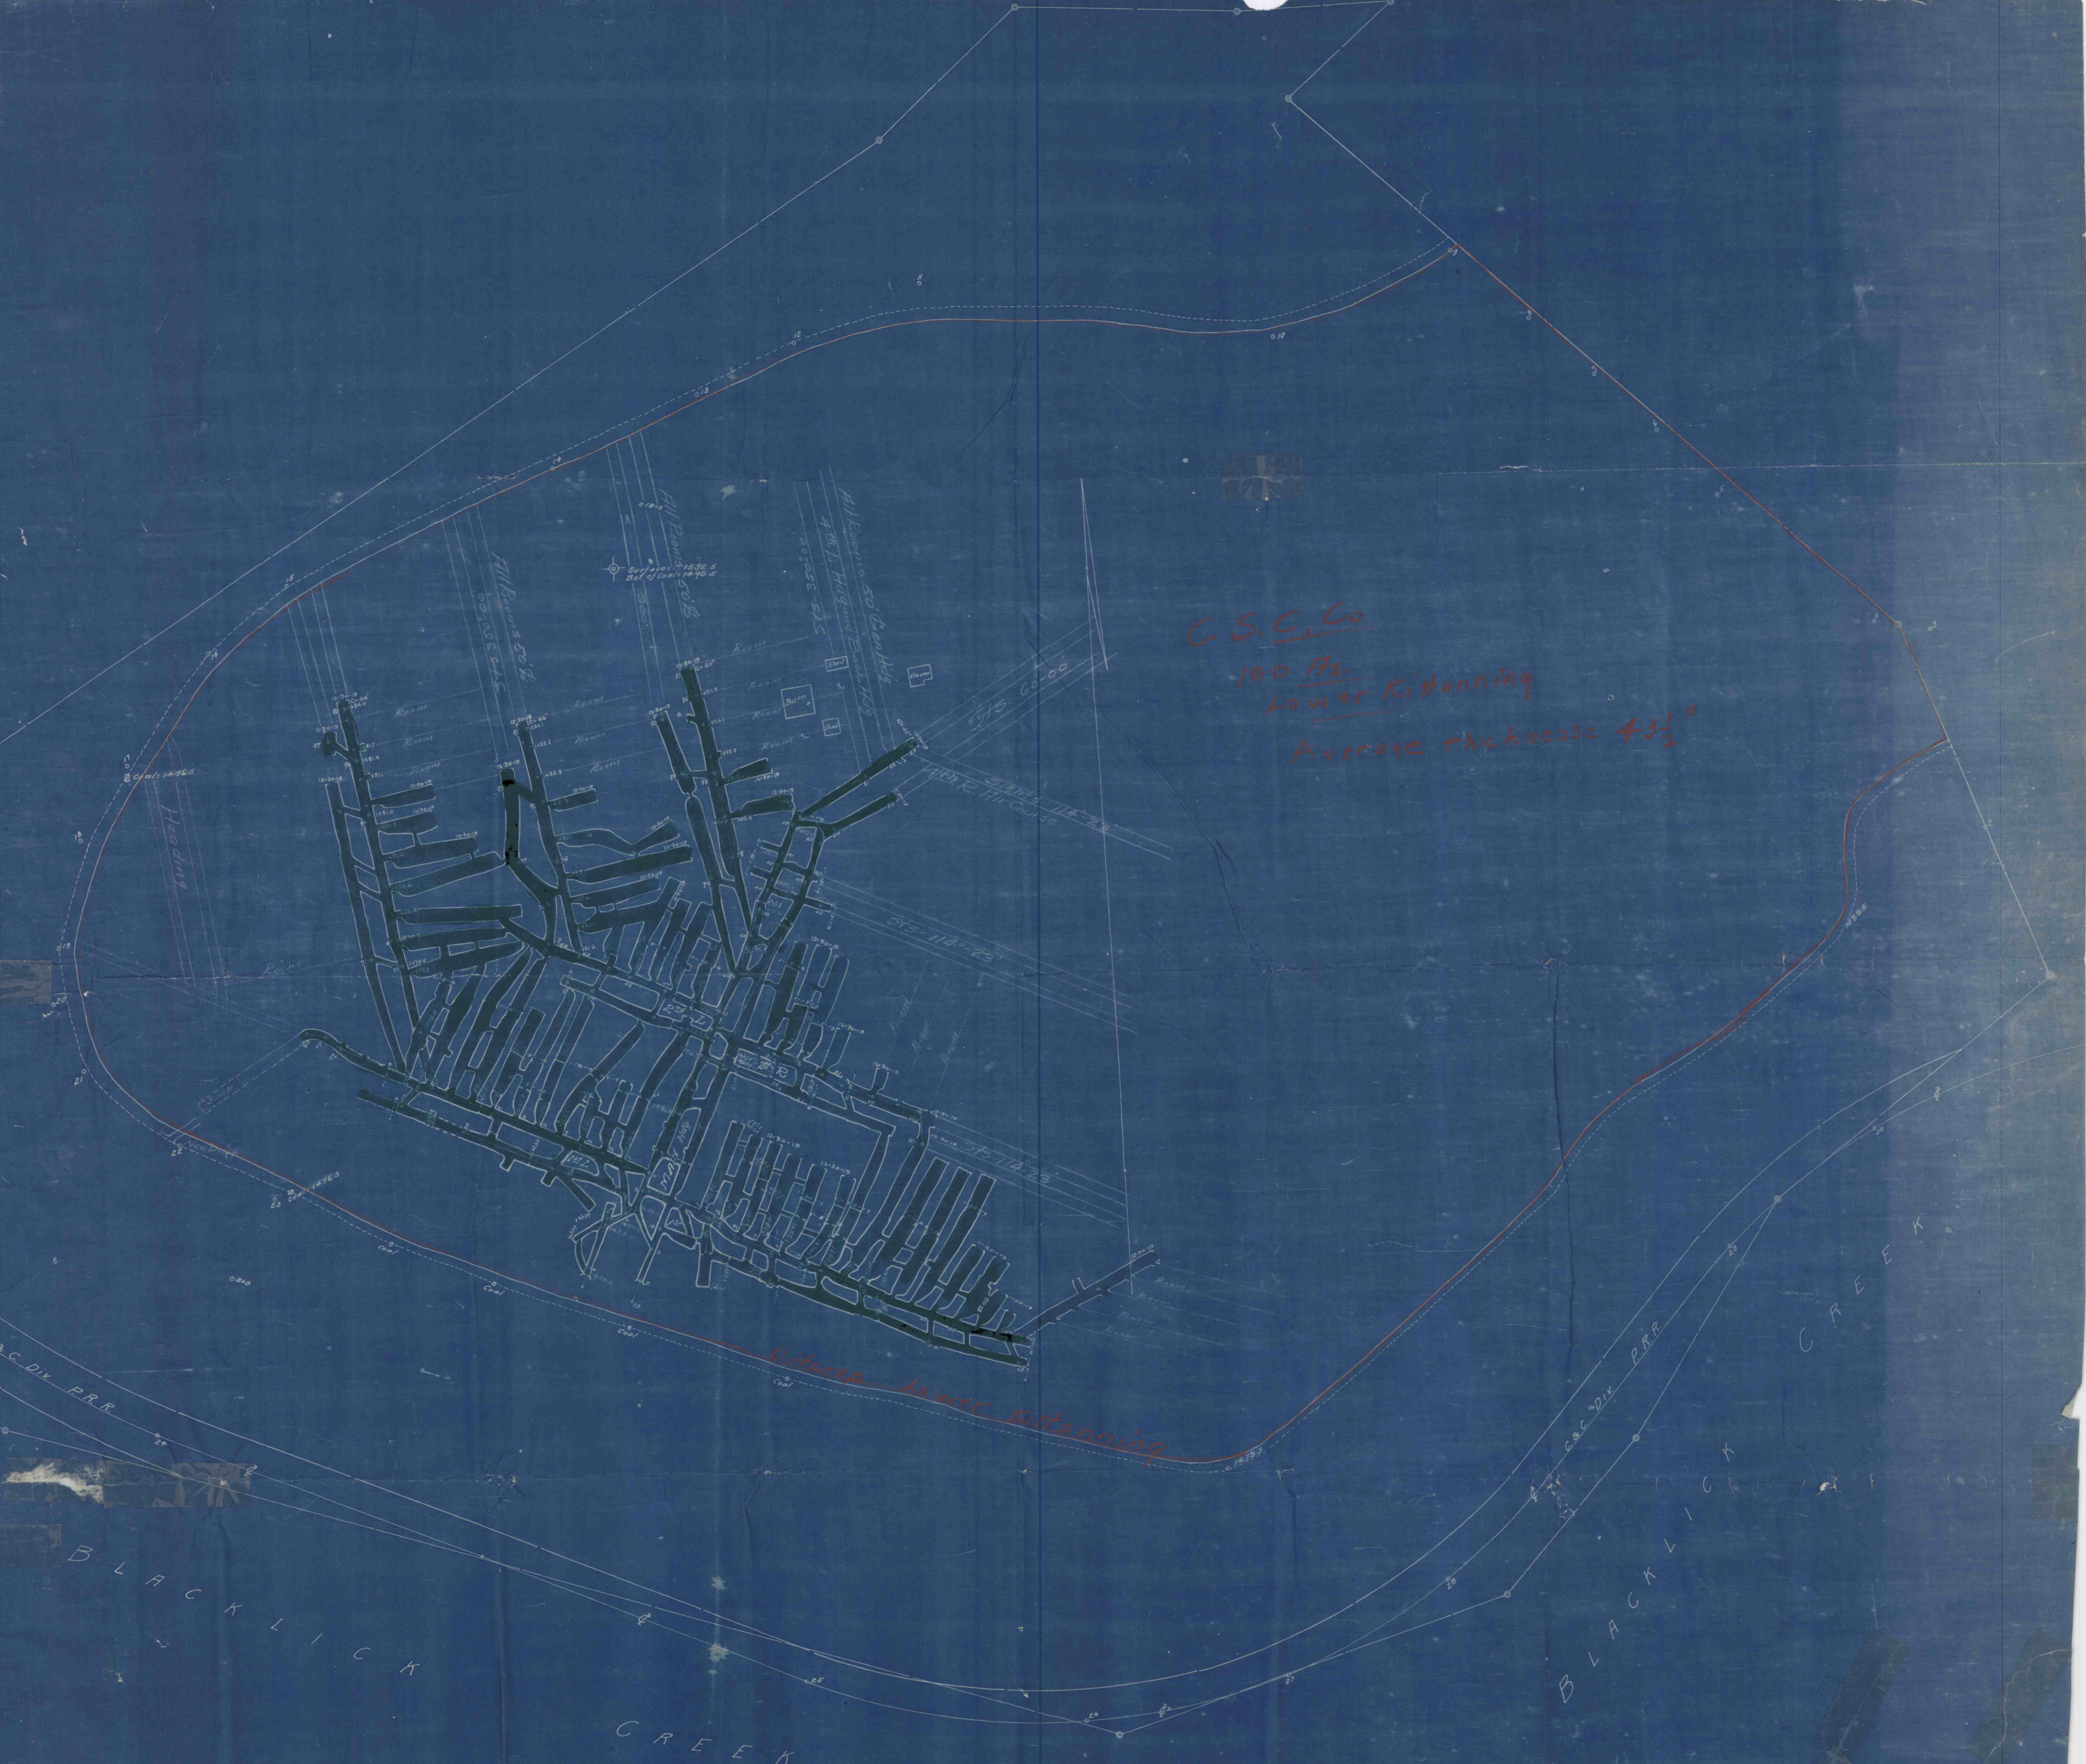

Cald-Well Smokeless Coal Company
Map of No. 1 Mine
Brushvalley Township, Indiana County, Penn'a.
Scale 1" = 100' August 1, 1917
HORNER-JONES ENGINEERING COMPANY
Indiana, Pennsylvania