
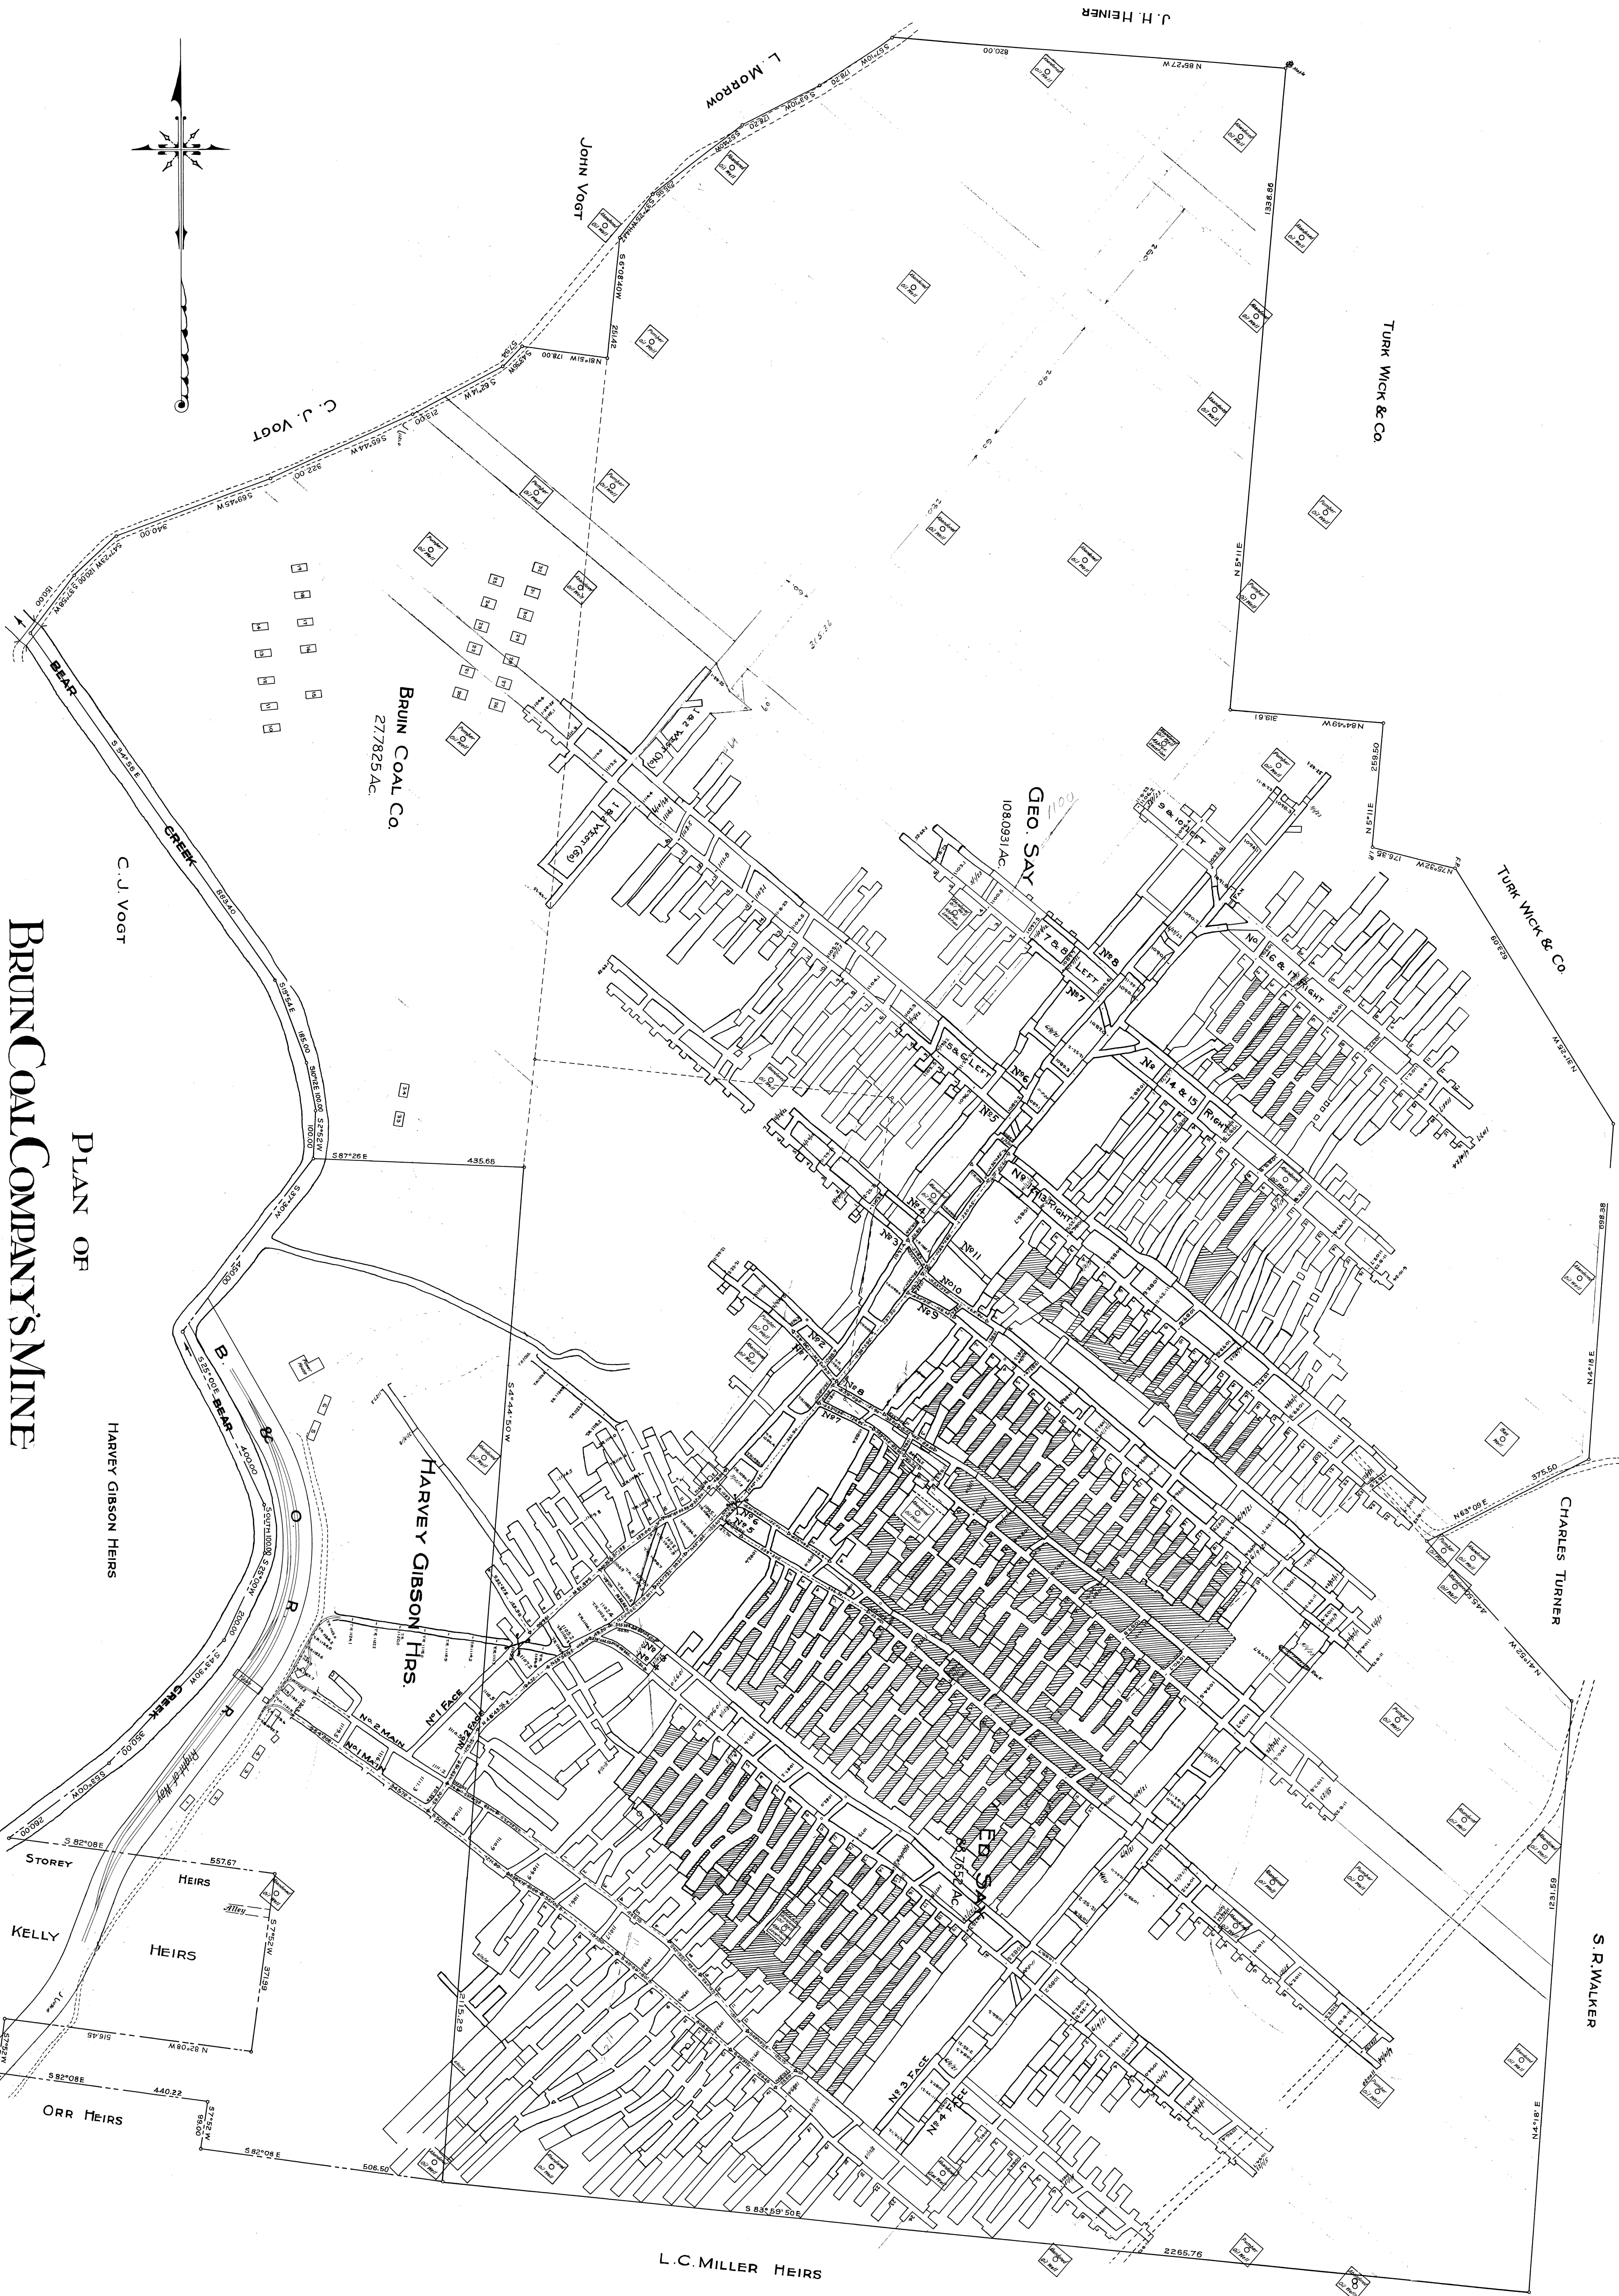


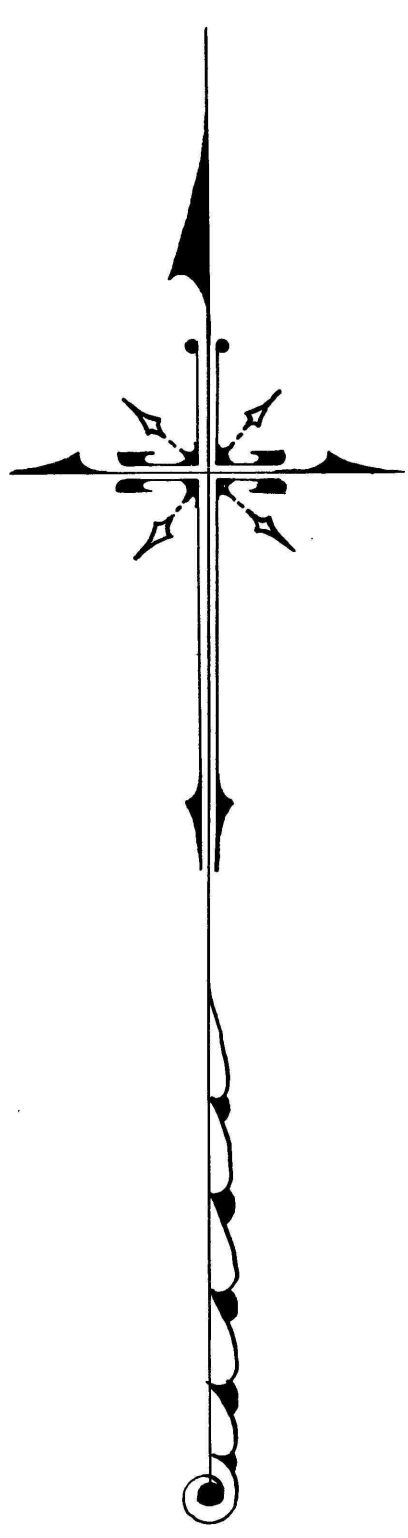

PLAN OF
BRUIN COAL COMPANY'S MINE
PARKER TOWNSHIP, BUTLER COUNTY

SCALE 1" = 100'

SEPTEMBER 1918

#281

6-17-1919

J.M. RAVENBURN