


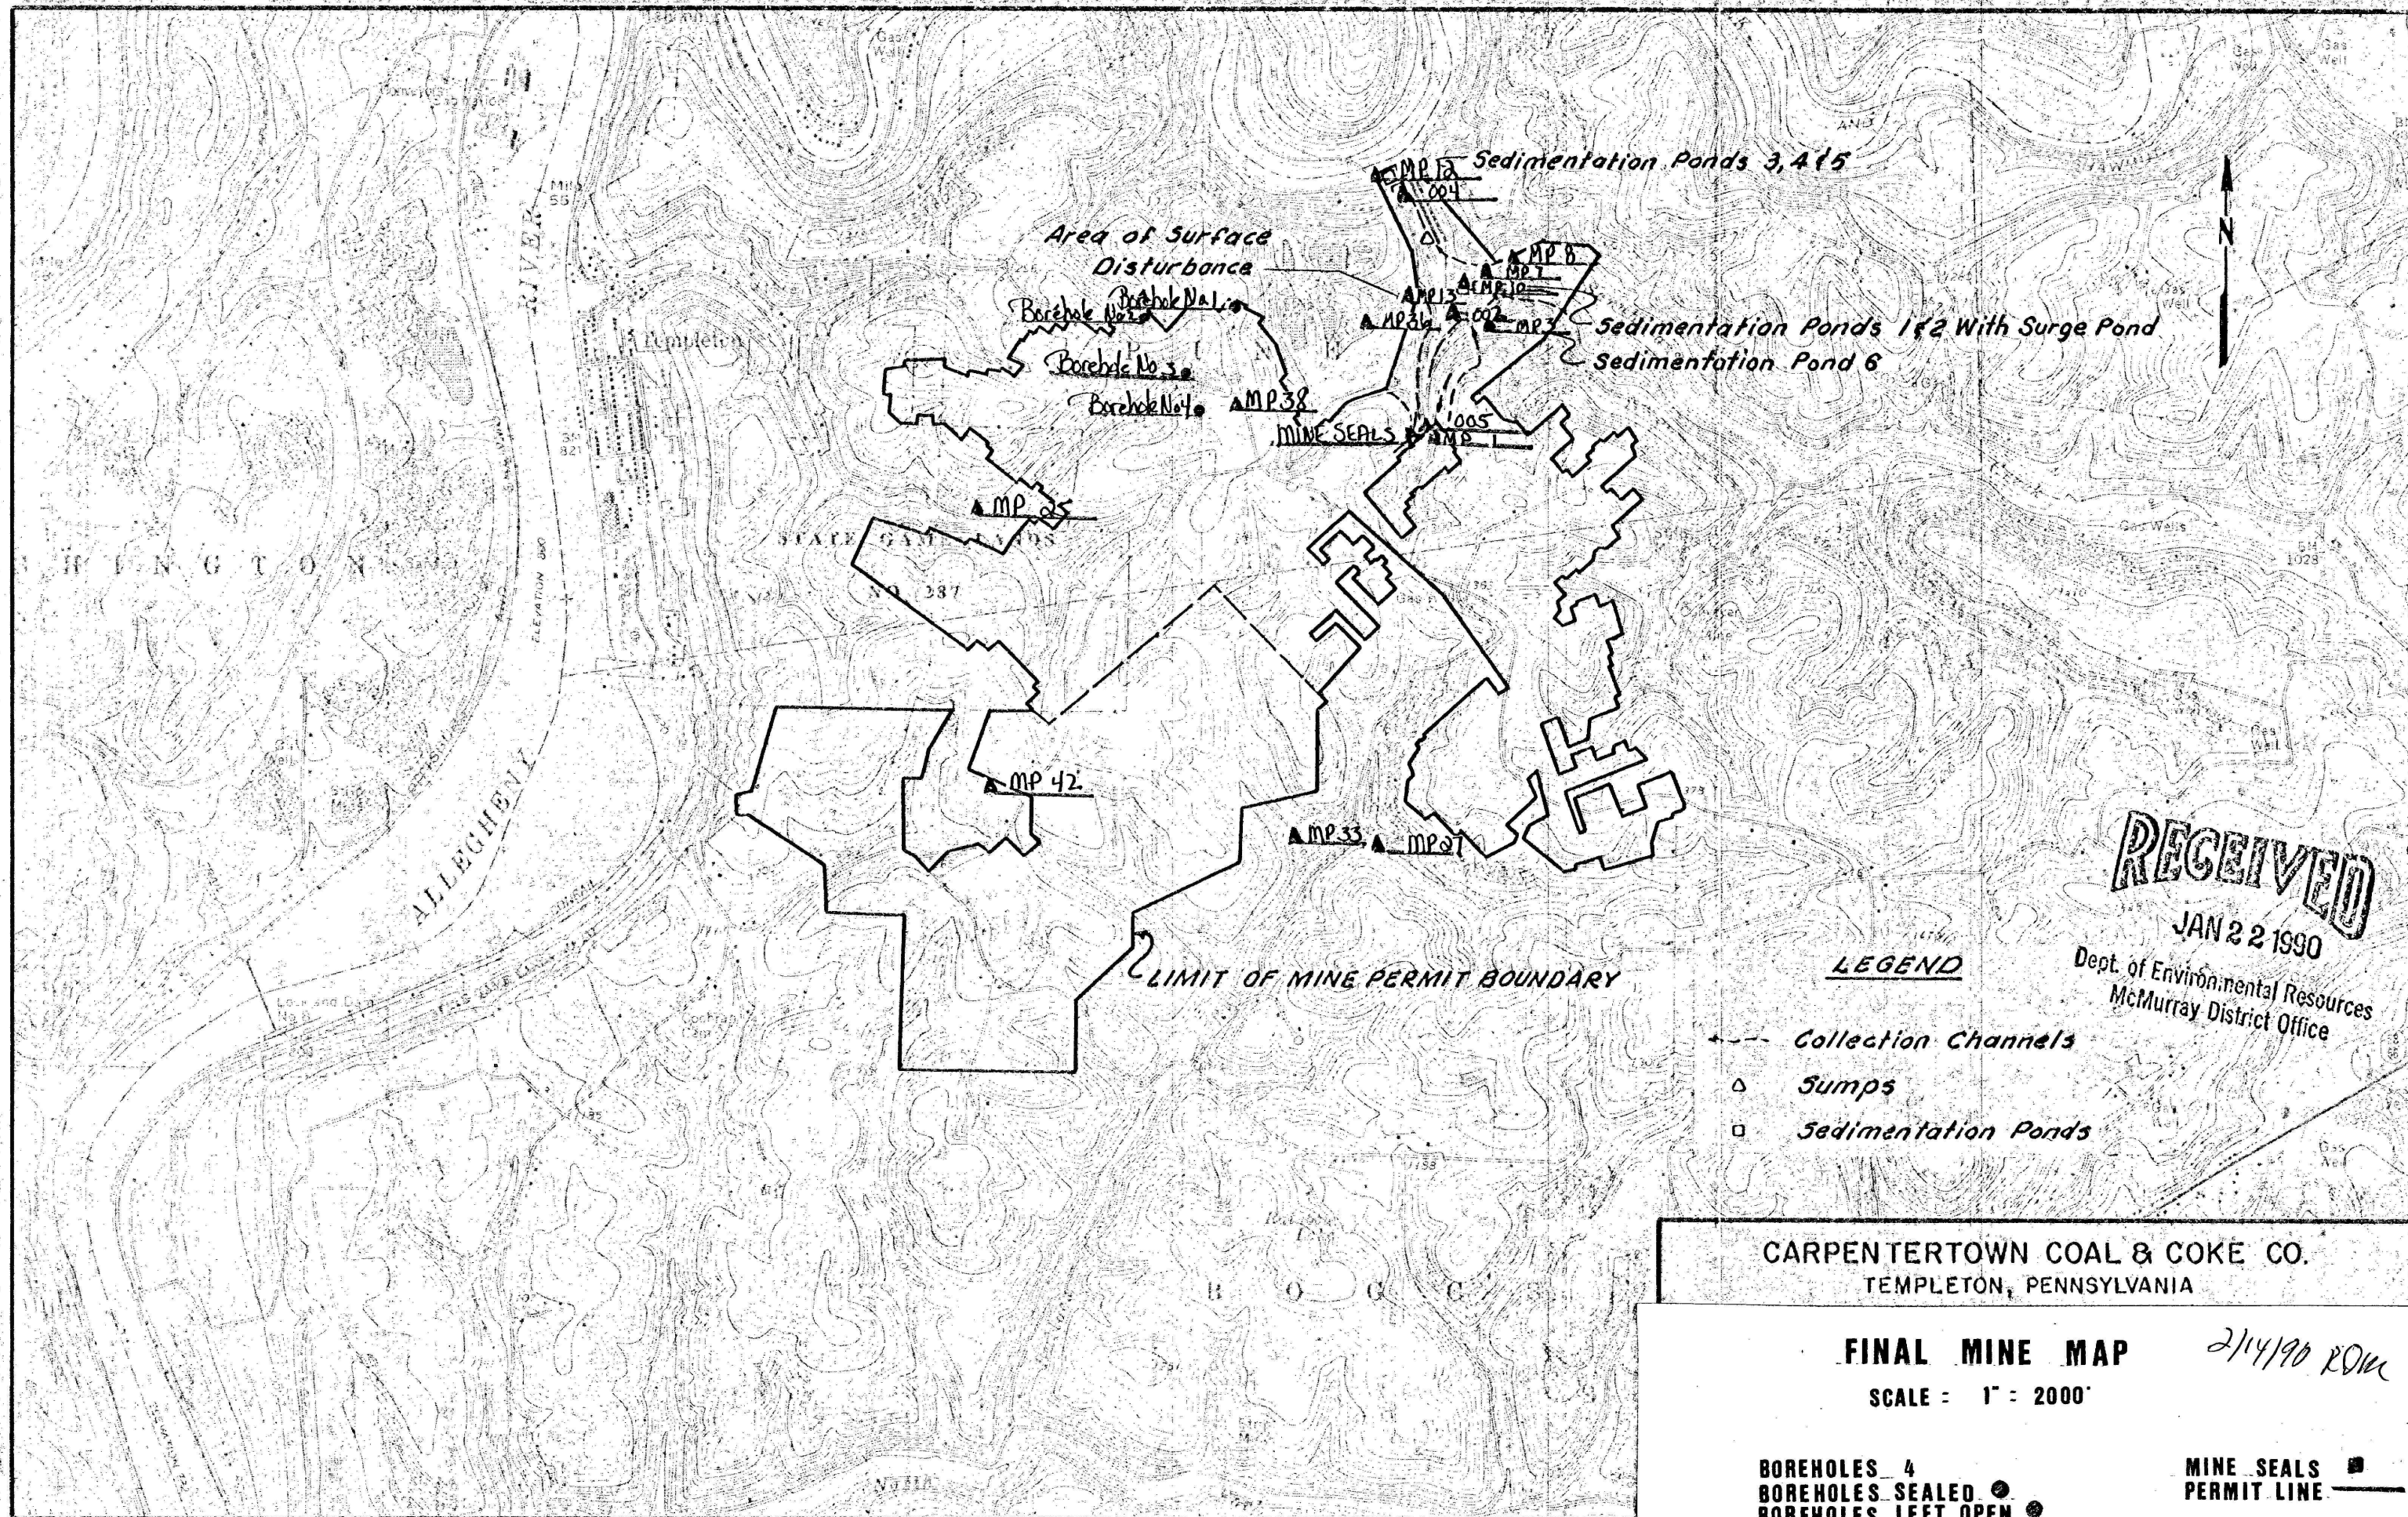

RECEIVED
JAN 22 1990

Dept. of Environmental Resources
McMurray District Office

LEGEND

- Collection Channels
- △ Sumps
- Sedimentation Ponds

CARPENTERTOWN COAL & COKE CO.
TEMPLETON, PENNSYLVANIA

FINAL MINE MAP
SCALE = 1" = 2000'

2/14/90 RDM

BOREHOLES 4
BOREHOLES SEALED ●
BOREHOLES LEFT OPEN ○
WATER MONITORING POINTS ▲

MINE SEALS ■
PERMIT LINE —