


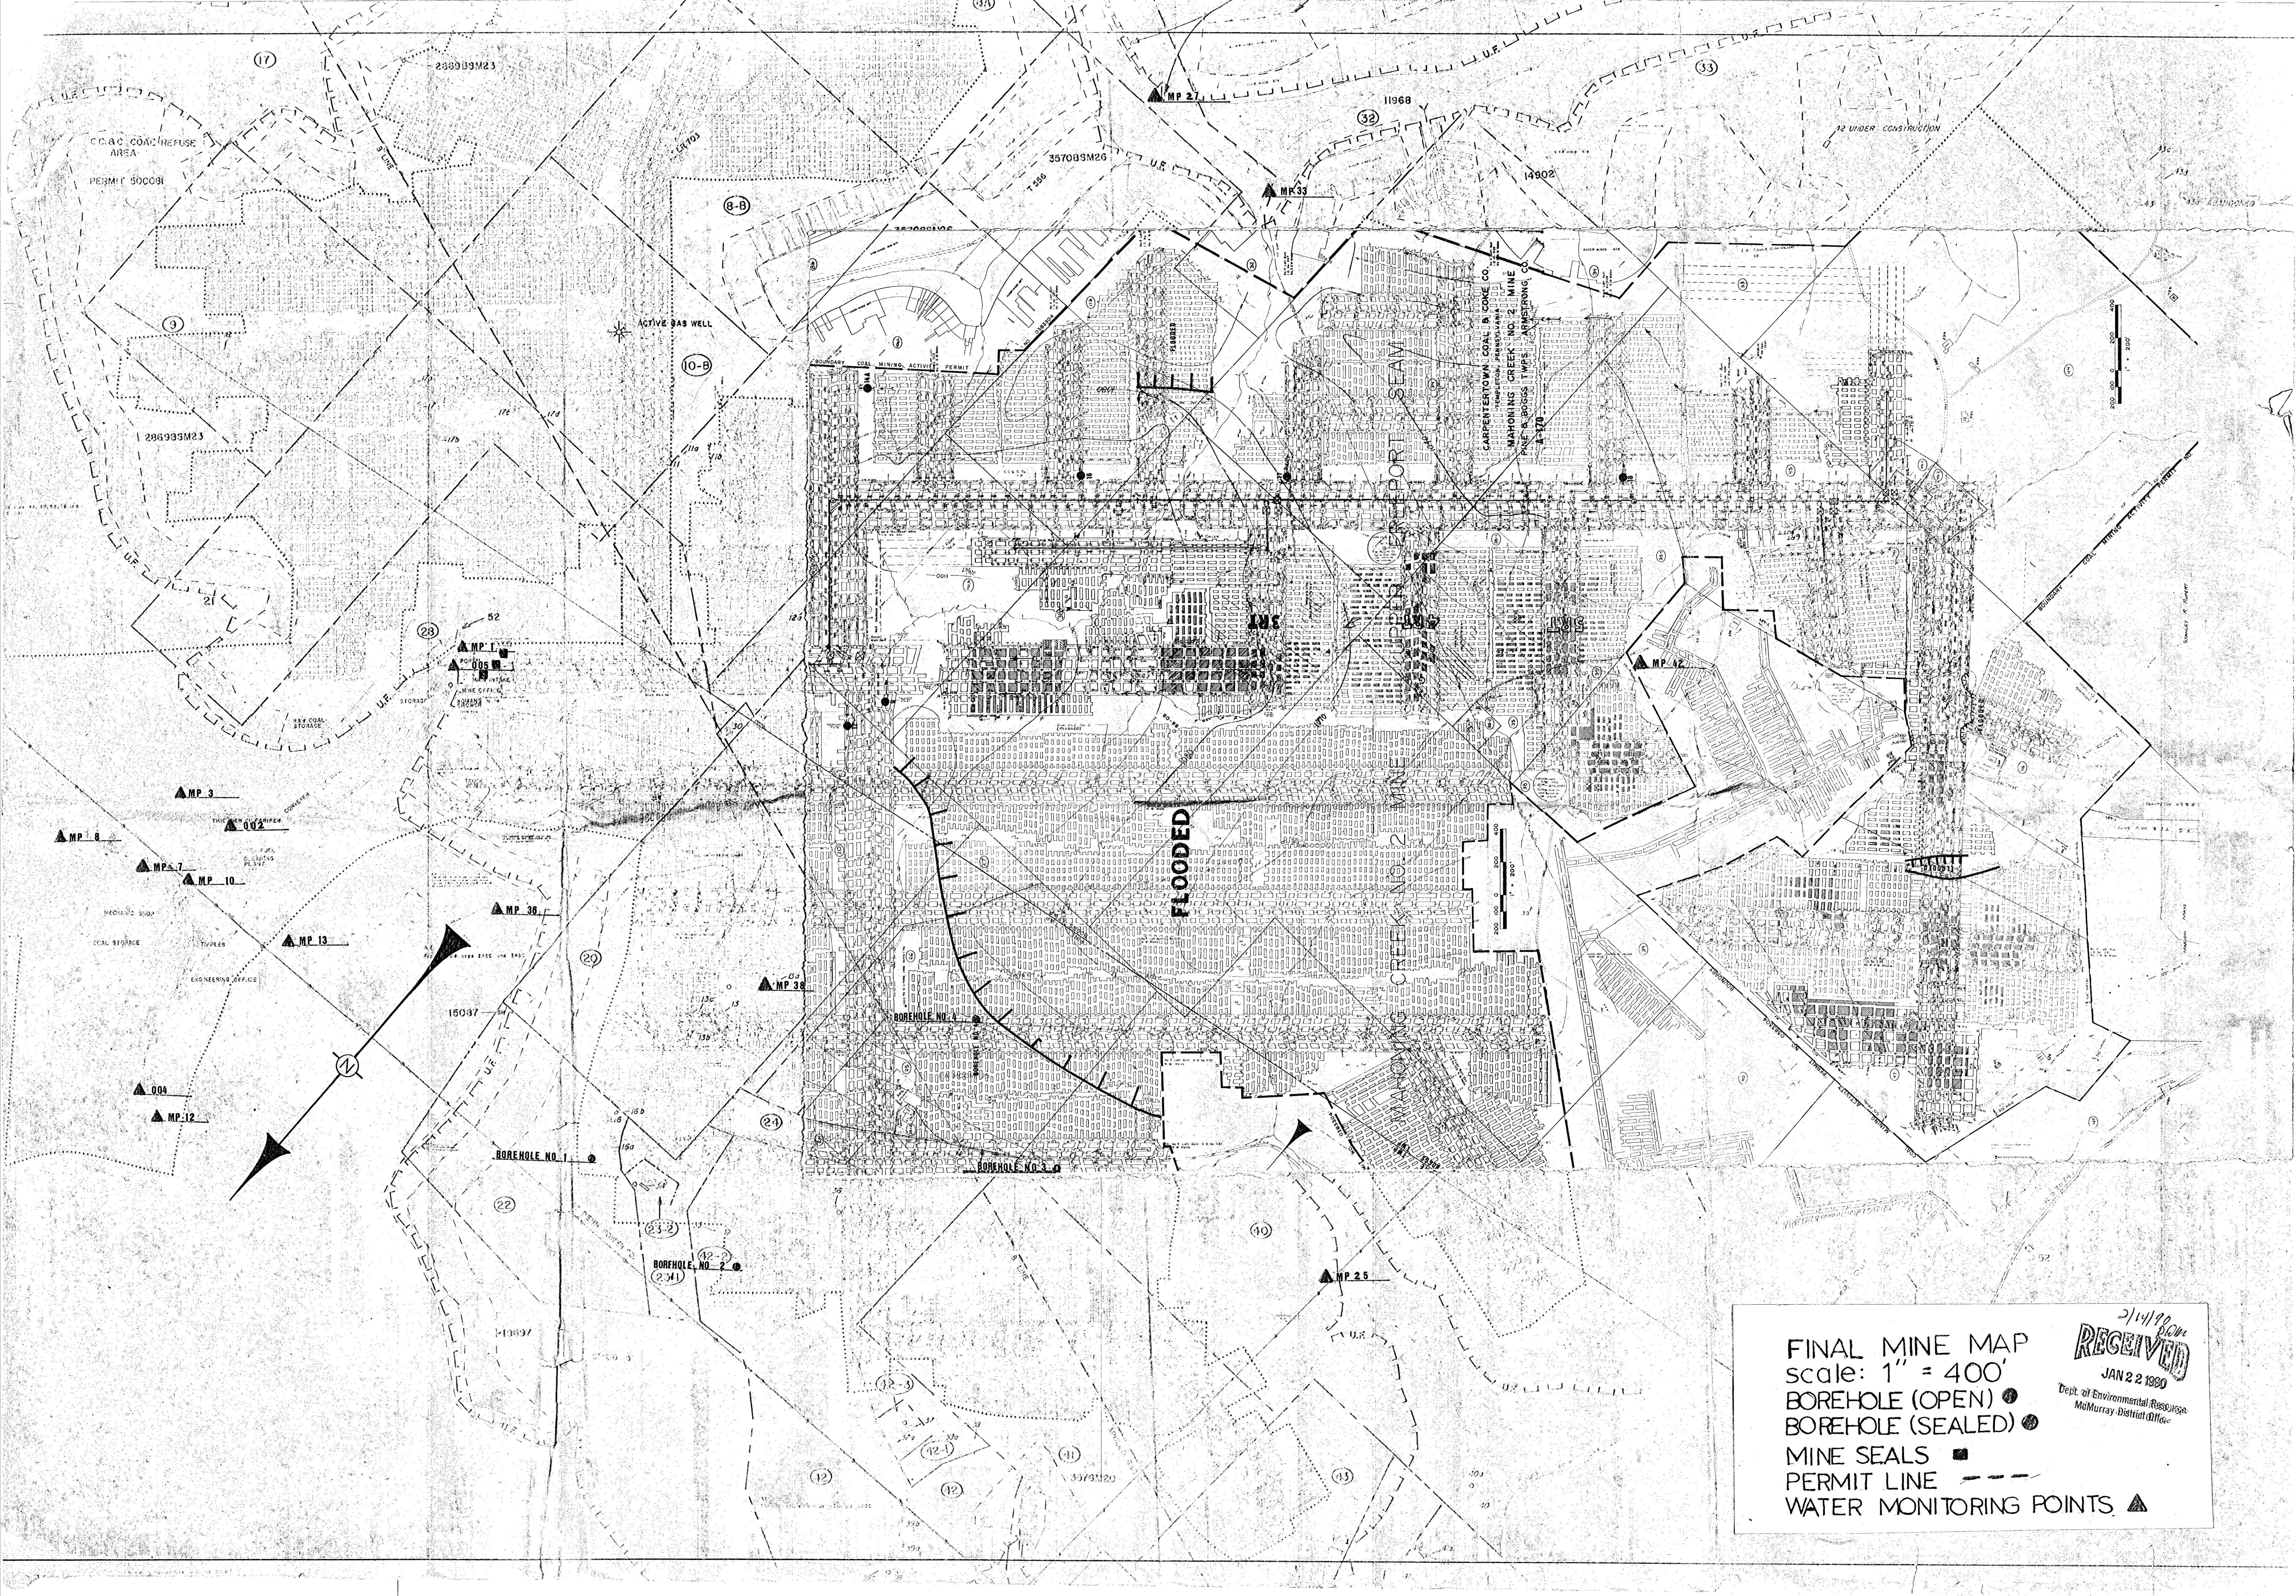

2/14/90  
**RECEIVED**  
JAN 22 1990  
Dept. of Environmental Resources  
McMurray District Office

**FINAL MINE MAP**  
scale: 1" = 400'  
BOREHOLE (OPEN) ●  
BOREHOLE (SEALED) ●  
MINE SEALS ■  
PERMIT LINE ---  
WATER MONITORING POINTS ▲