





CHERRY RUN

DIET ROAD 7 MI. TO FORCE

PROPOSED WORKINGS

BRUNELLI MINE
FORCE PA
SCALE 1" = 100 FT
Survey EXTENDED TO BY
JUNE - 18-1964
MAY - 4-1960
FEB. - 2-1966

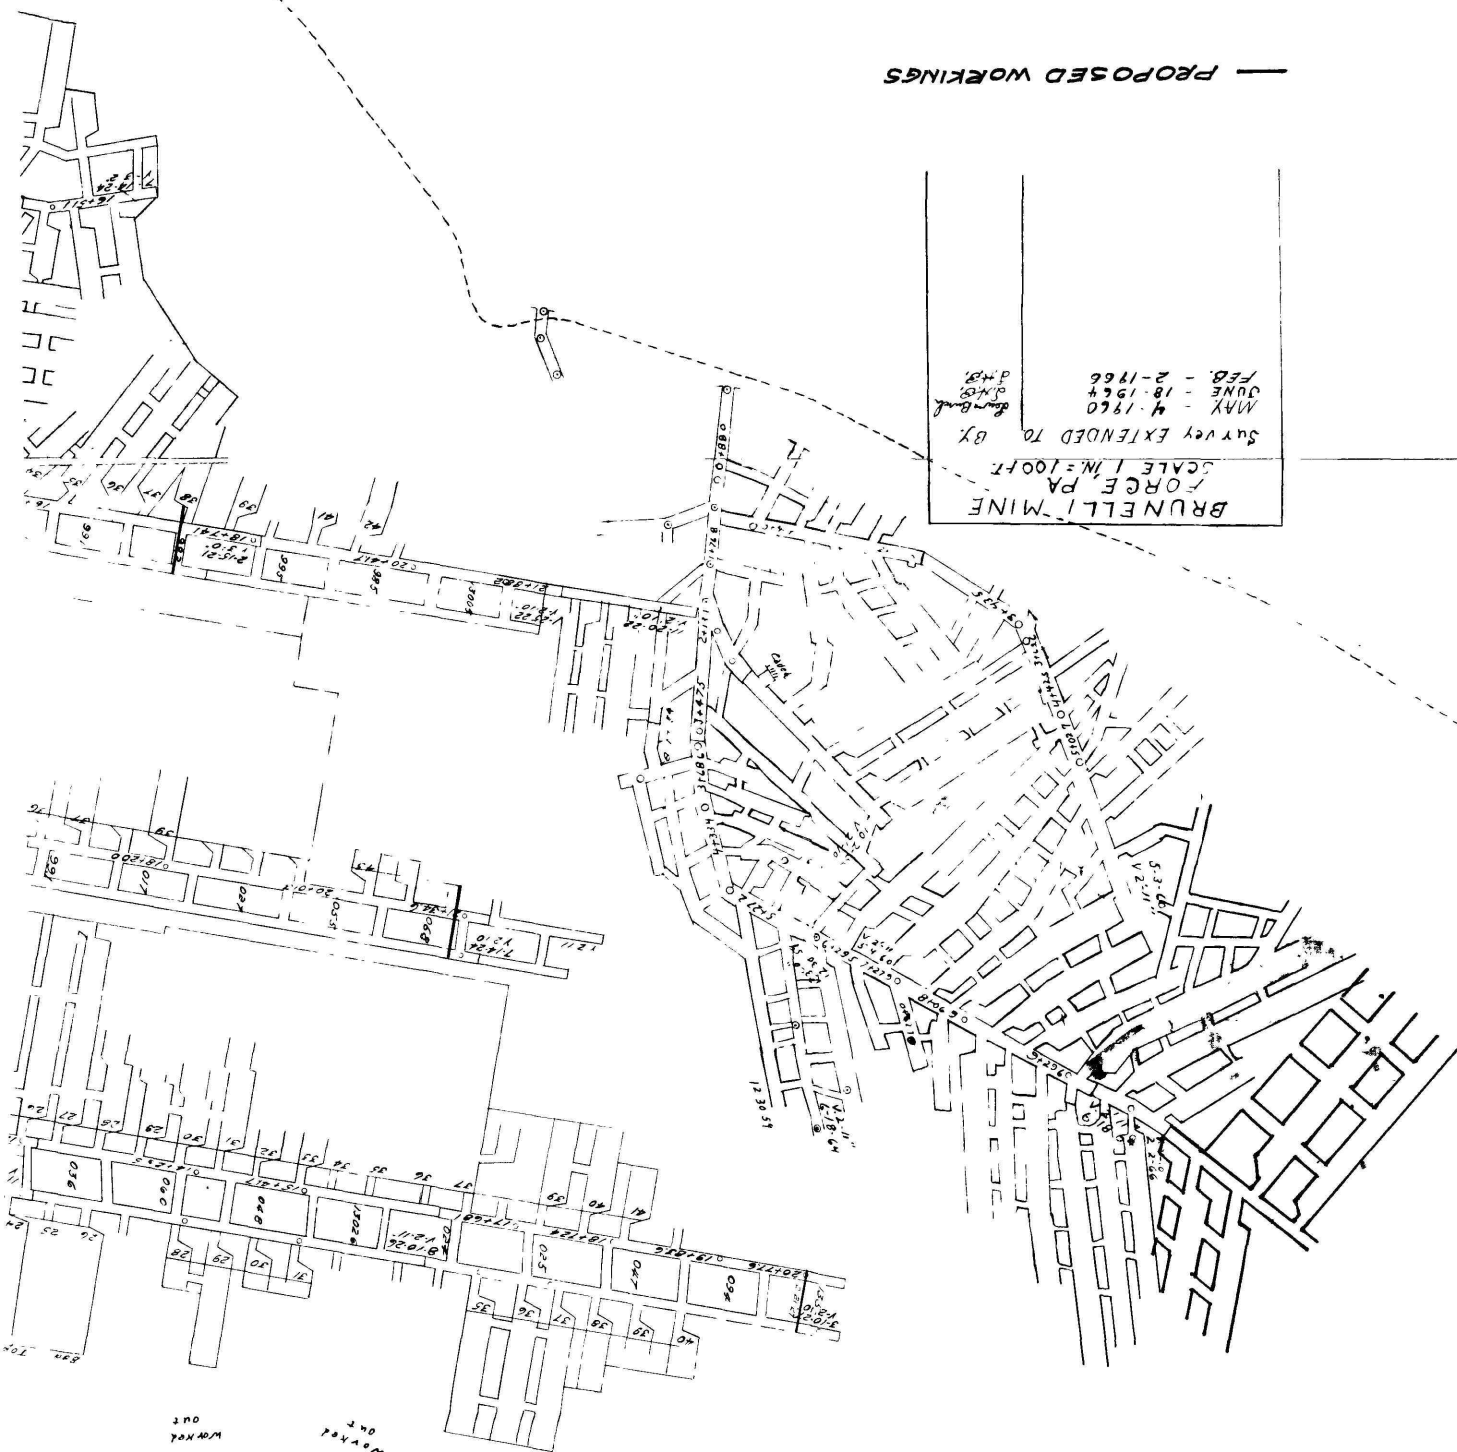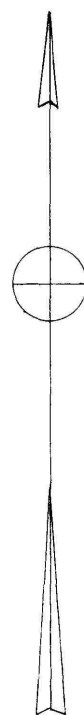

NEW SHAWMUT MINING CO.
COAL & SURFACE

DARL HEWITT

FRUMBO ESTATE