


PARKER HEIRS
JOHN HEATON

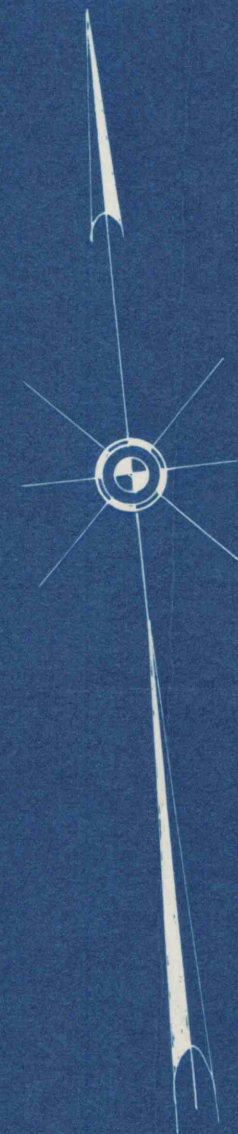

STUMP
ROAD
PROPERTY LINE
TRAVERSE LINE
N 83° 40' W 1728.5'
N 84° 35' W 1728.5'
N 89° 02' W 191.3'
N 79° 33' W 380.4'
S 0° 01' W 100.26'

222.4
S 39° 30' E
273.7
S 4° 30' E
368.7
S 35° 37' W

STRIP
PIT
S 10° 18' E
304.4
124.8'
S 12° 21' W
53.0'
STATION 0+00
S 86° 17' E
1+08.4
1+96.4
2+54.1
2+93.35
N 40° 35'

DEEP MINE

STRIP
PIT

JOHN HEATON MINE
BROAD TOP TWP., BEDFORD CO., PENNSYLVANIA

SCALE 1" = 100'

SURVEYED 8-9-1955

R. B. BEAM R.P.E.
BEDFORD, PENN.