


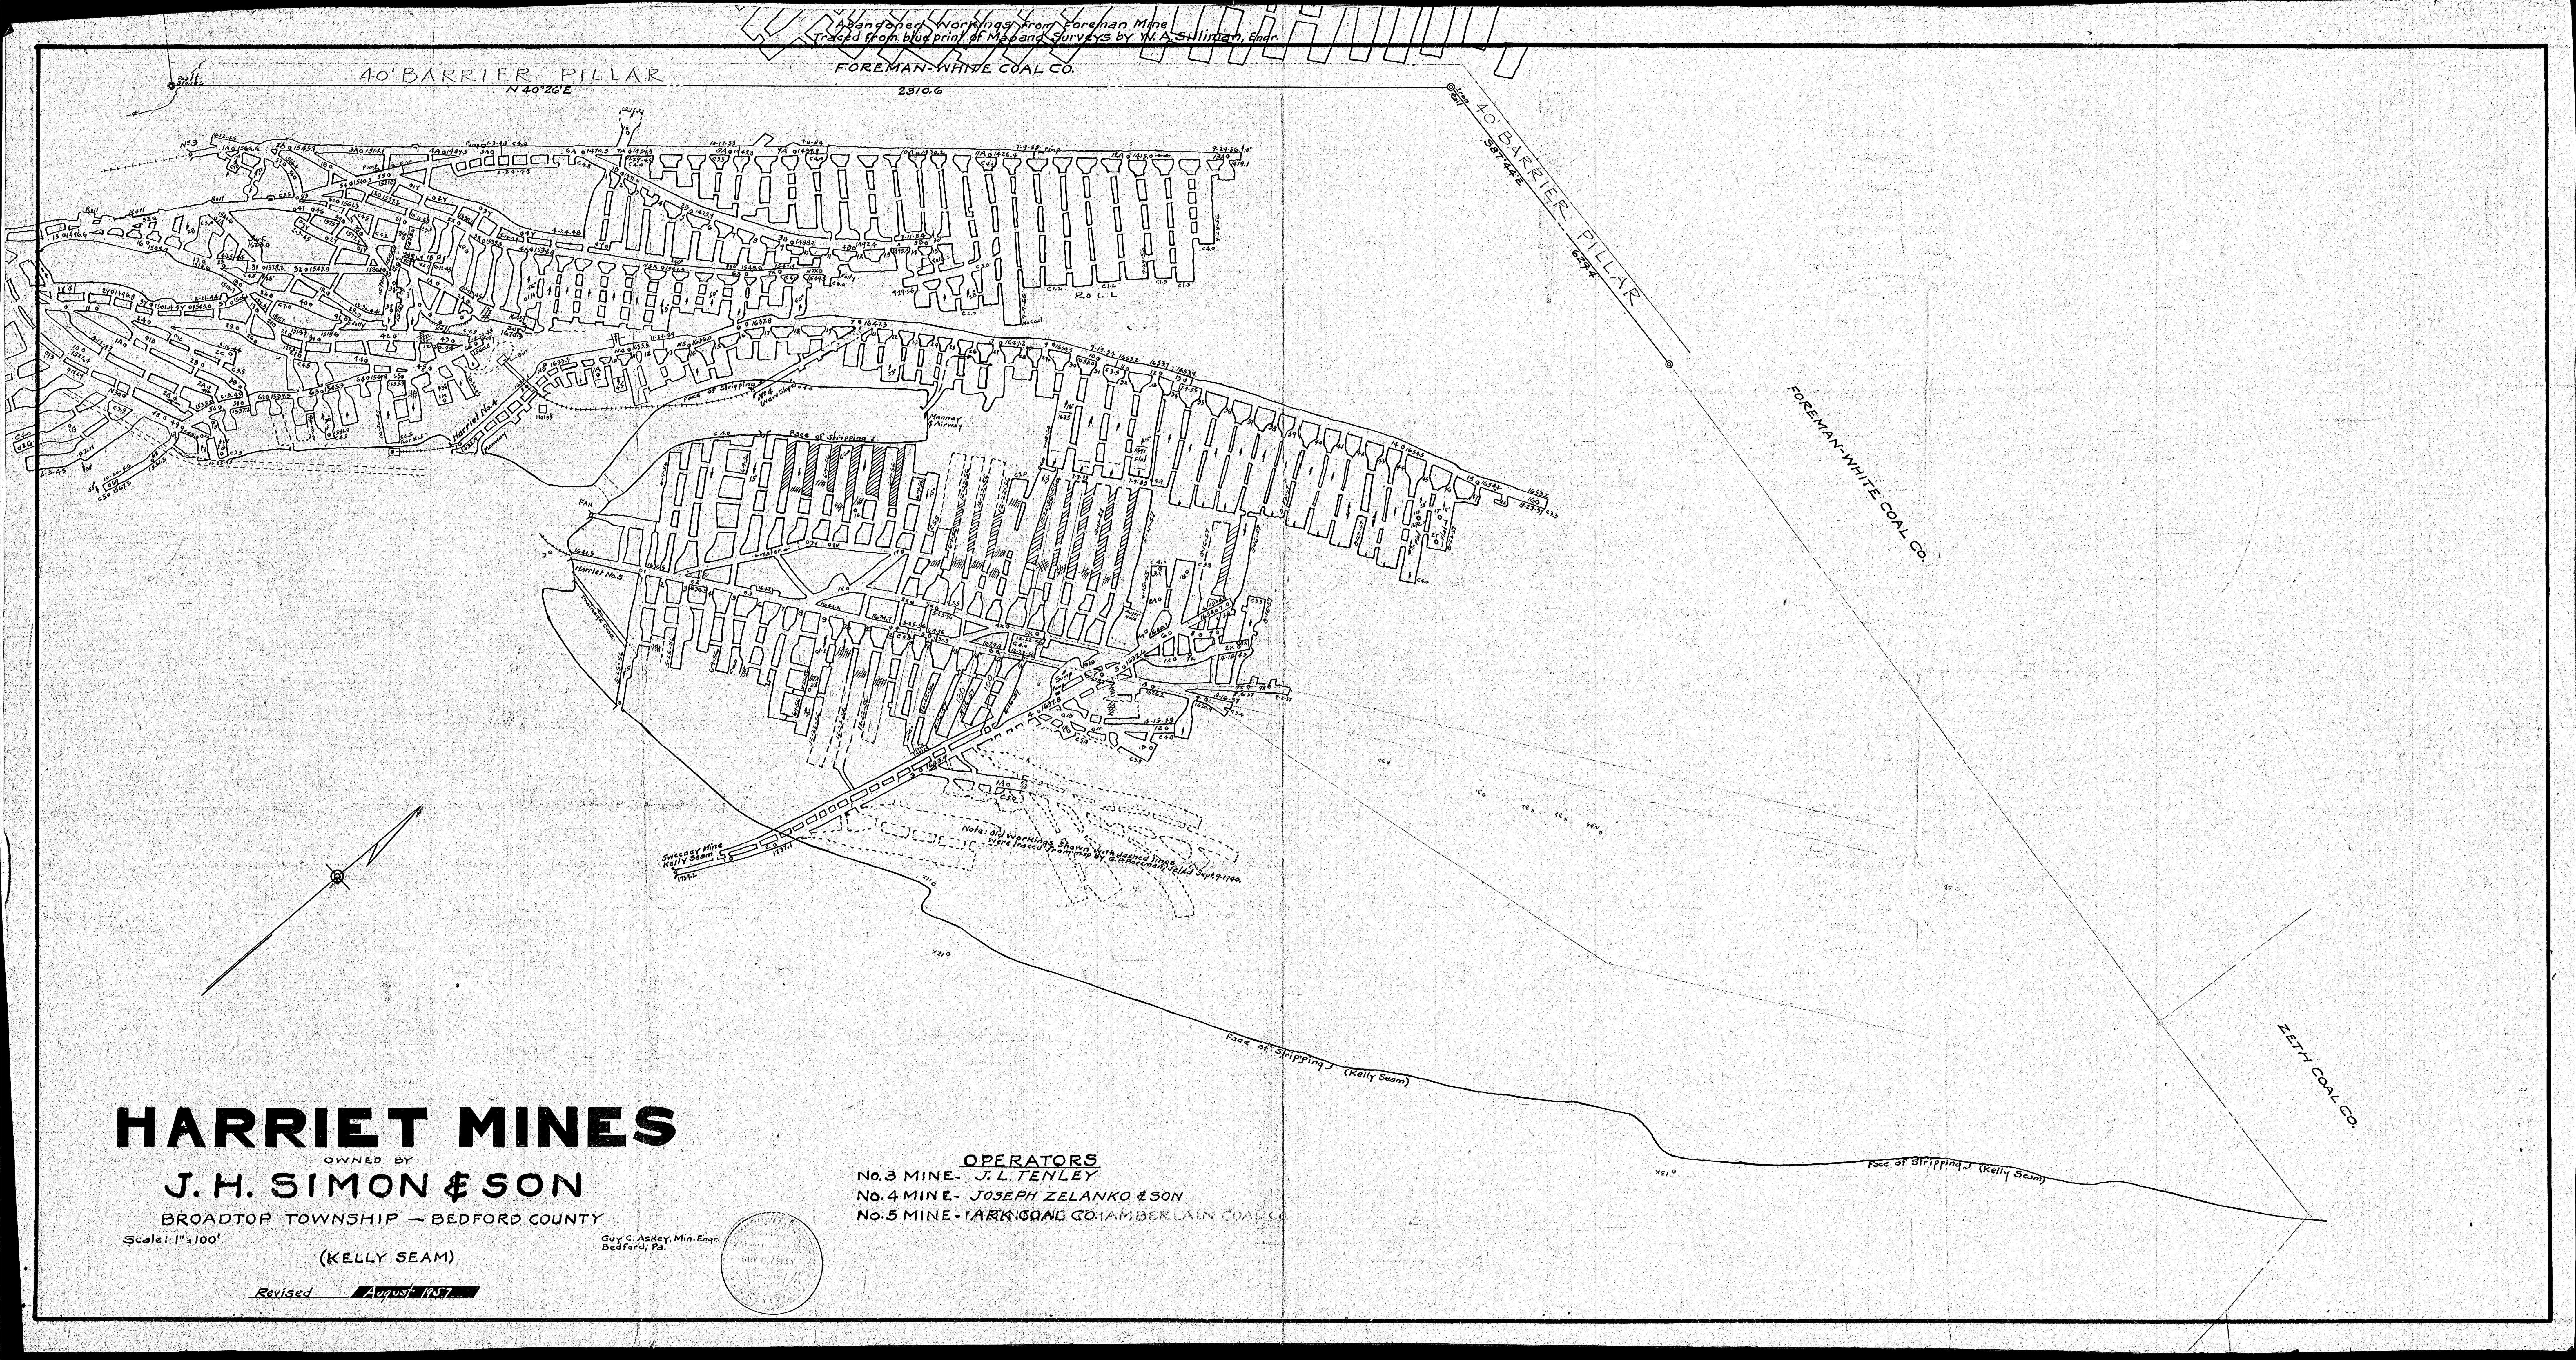

Abandoned Workings from Foreman Mine
Traced from blue print of Map and Surveys by W. A. Sullivan, Engr.

40' BARRIER PILLAR
N 40° 26' E

FOREMAN-WHITE COAL CO.
2310.6

40' BARRIER PILLAR
S 87° 42' E

FOREMAN-WHITE COAL CO.

ZETH COAL CO.

HARRIET MINES

OWNED BY

J. H. SIMON & SON


BROADTOP TOWNSHIP — BEDFORD COUNTY

Scale: 1" = 100'

(KELLY SEAM)

Revised August 1957

Guy C. Askey, Min. Engr.
Bedford, Pa.

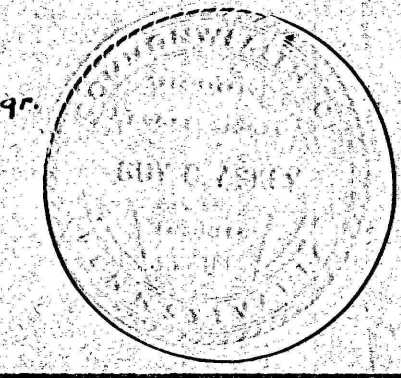

OPERATORS

No. 3 MINE — J. L. TENLEY

No. 4 MINE — JOSEPH ZELANKO & SON

No. 5 MINE — ARK COAL CO. / AMBERLAIN COAL CO.