




Gas
Surface El. 1116.0
Well
Coal El. 565.9

Beretta Bros. Coal Co.
Plumereck Twp., Armstrong Co. Pa.
Scale 1"=100' Nov. 2, 1959
Projections for Gas Well by
Craff Engineering Co.
Blairsville, Pa.
Nov. 2, 1959

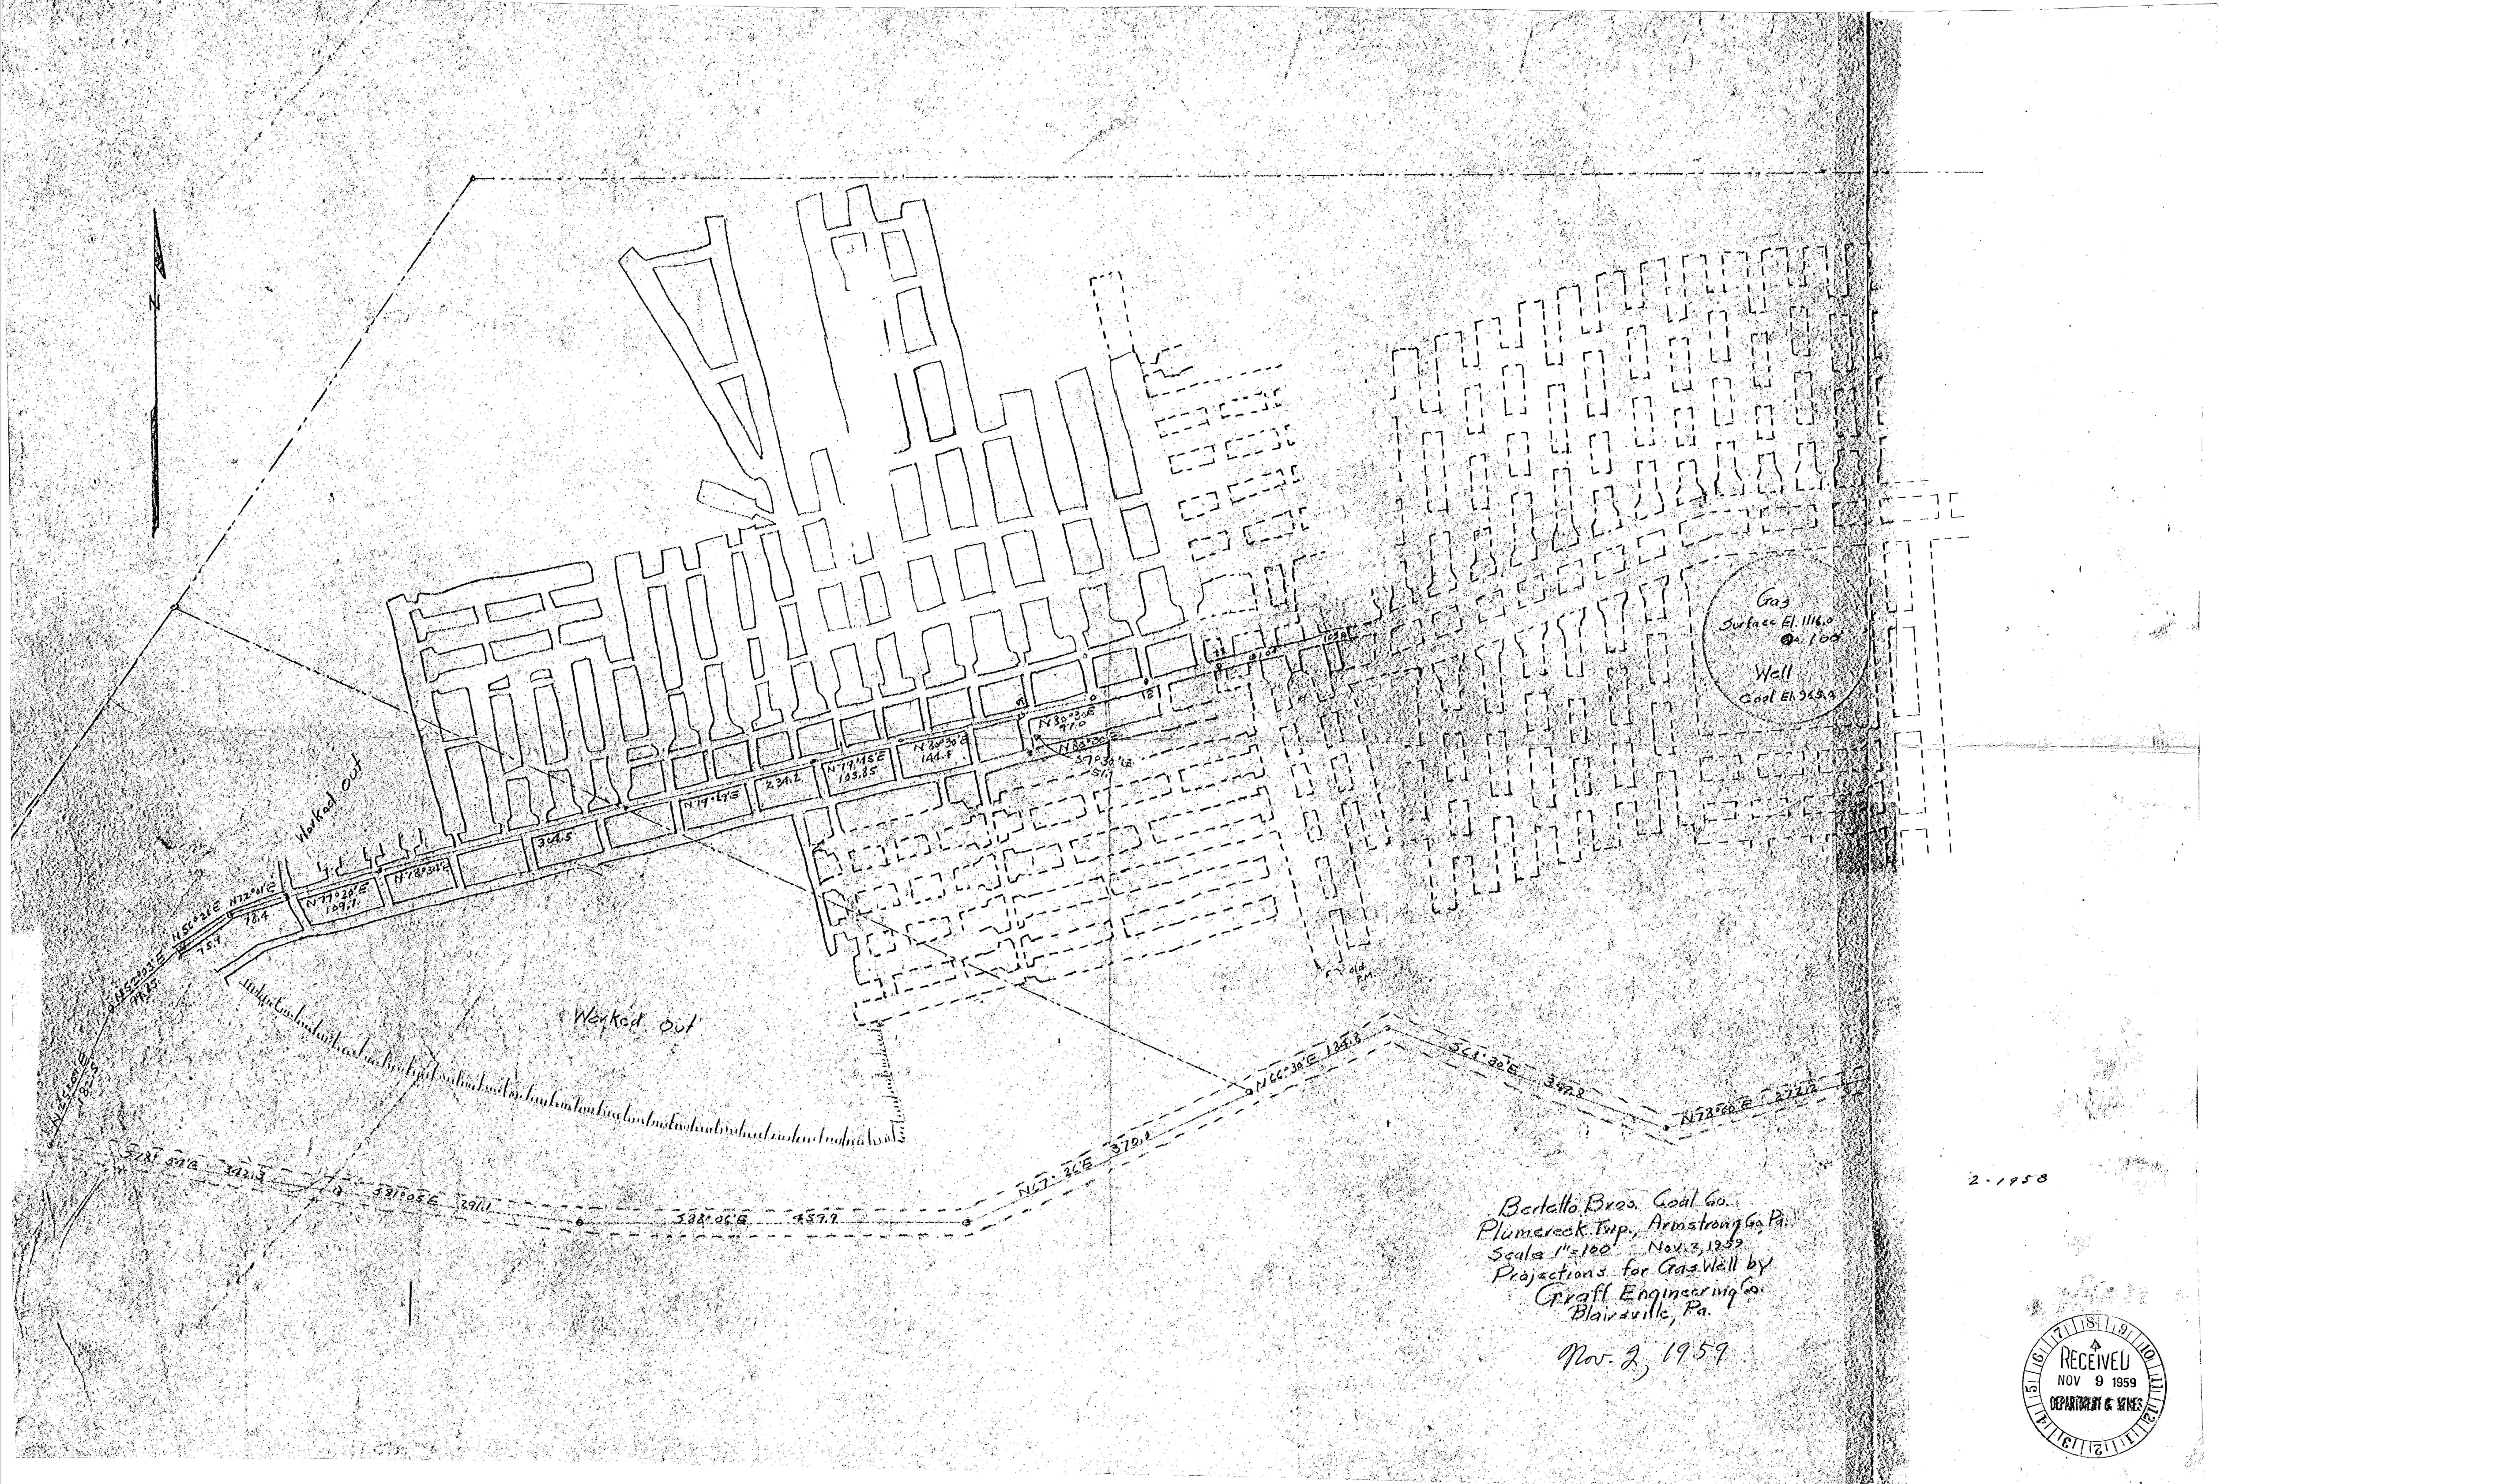