



WM. WOODFORD 114A.28P

M. WARNER
29.90A.

W.T. COWAN
50A

MINING FINISHED

SARAH E. COWAN
50A.

W.T. COWAN
38.8A

H. THREMAUSER
40.8A

MINED OUT

W.T. COWAN
38.8A

J.B. MOORE HAS
46.8A

WM. MOORE
53.65A

WM. MOORE
15A.

JOSEPHINE
WILLOCK
34.2A


MINED OUT

MINED OUT

MINED OUT

MINED OUT

UNMINED COAL OF
THE PCH. VEIN CONV BY
P.C.CO. TO J.C. MCBRIDE
9-13-38

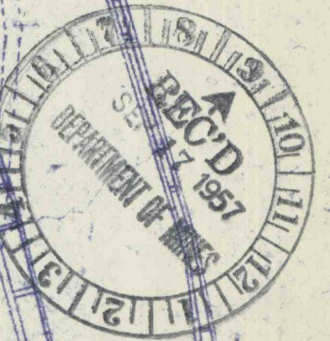

Allegheny Co.

FLECK COAL COMPANY
FLECK NO. 3 MINE
BALDWIN BOROUGH, PENNA.
INSPECTION DISTRICT NO. 22
OIL & GAS INSPECTION DISTRICT 6
SCALE: 1" = 500'
OWNER:
CHARLES J. FLECK
109 Charles Drive
Carnegie, Penna.