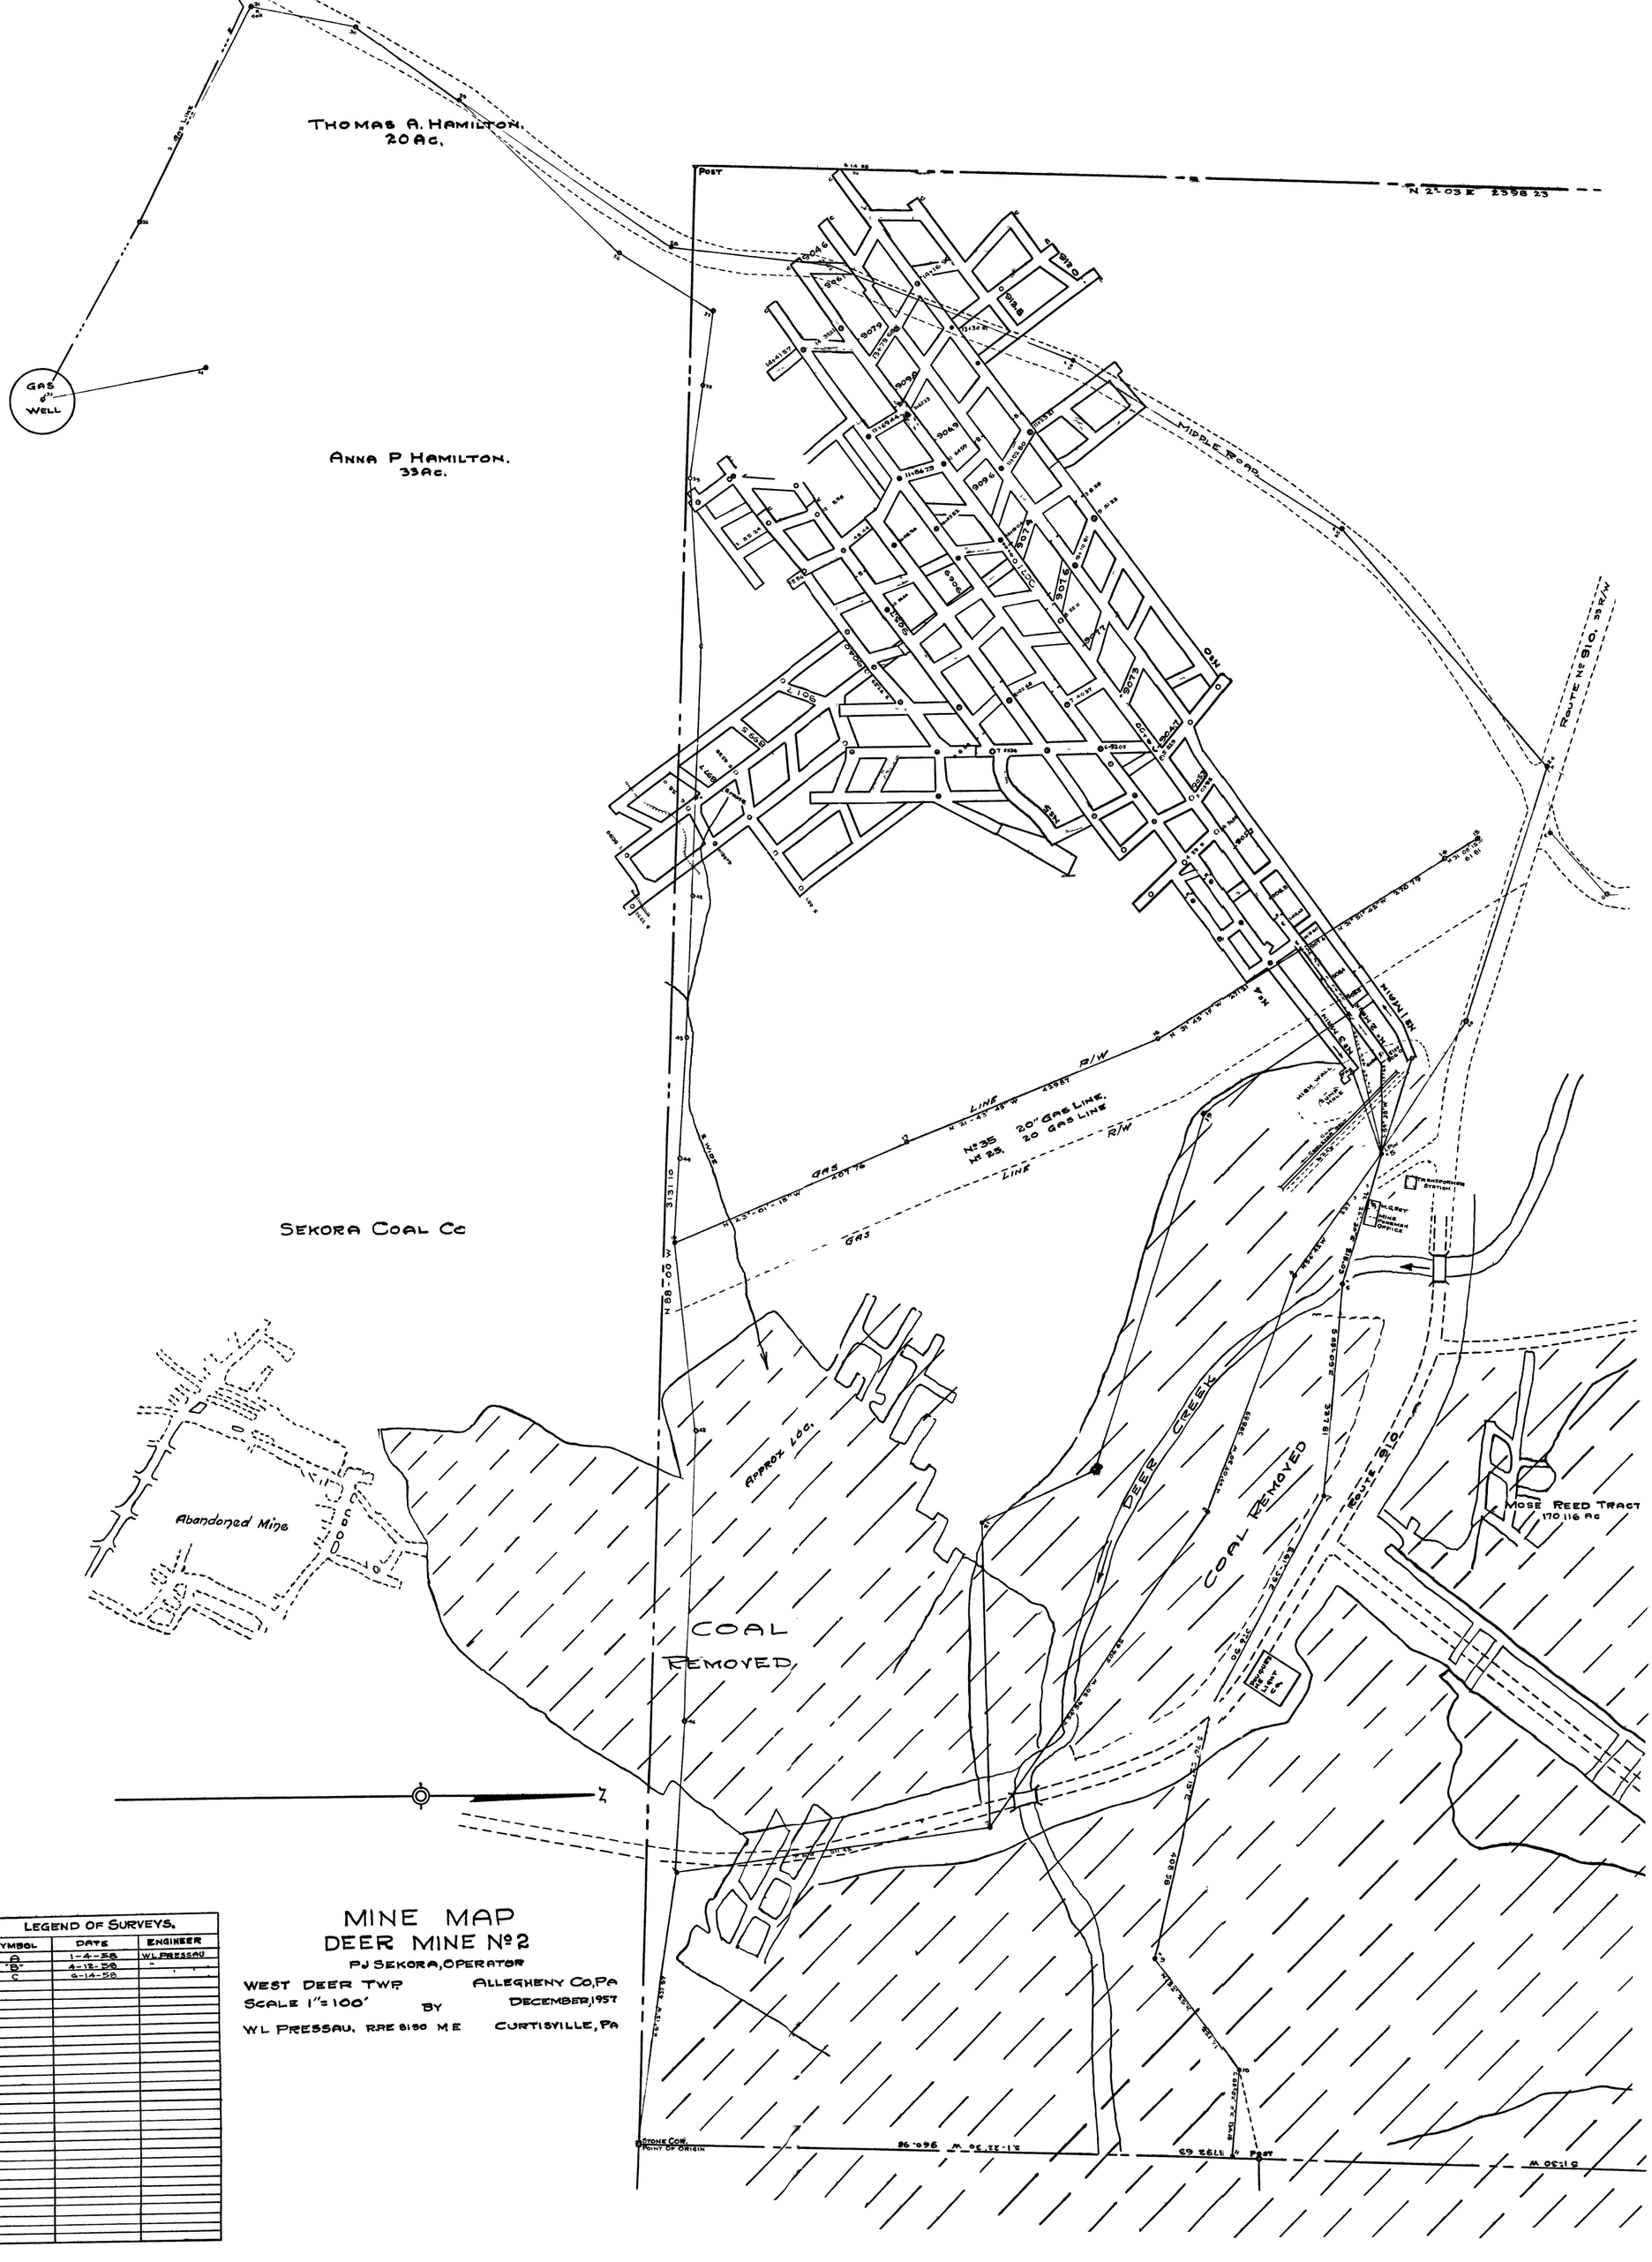
THOMAS A. HAMILTON.
20 Ac.
ANNA P HAMILTON.
33 Ac.
GAS WELL
SEKORA COAL Co
MIDDLE ROAD
ROUTE No 910, 33 R/W
HIGHWAY
20" GAS LINE
20 GAS LINE
R/W
LINE
GAS
APPROX LOC.
COAL REMOVED
DEER CREEK
ROUTE 910
MOSE REED TRACT
170.116 Ac
Abandoned Mine
N
LEGEND OF SURVEYS.
SYMBOL
DATE
ENGINEER
A
1-4-58
W.L. PRESSAU
"B"
4-12-58
C
6-14-58
MINE MAP
DEER MINE No 2
PJ SEKORA, OPERATOR
WEST DEER TWP
ALLEGHENY Co, Pa
SCALE 1" = 100'
BY
DECEMBER, 1957
W.L. PRESSAU, R.R.E. 8190 M.E.
CURTISVILLE, Pa