


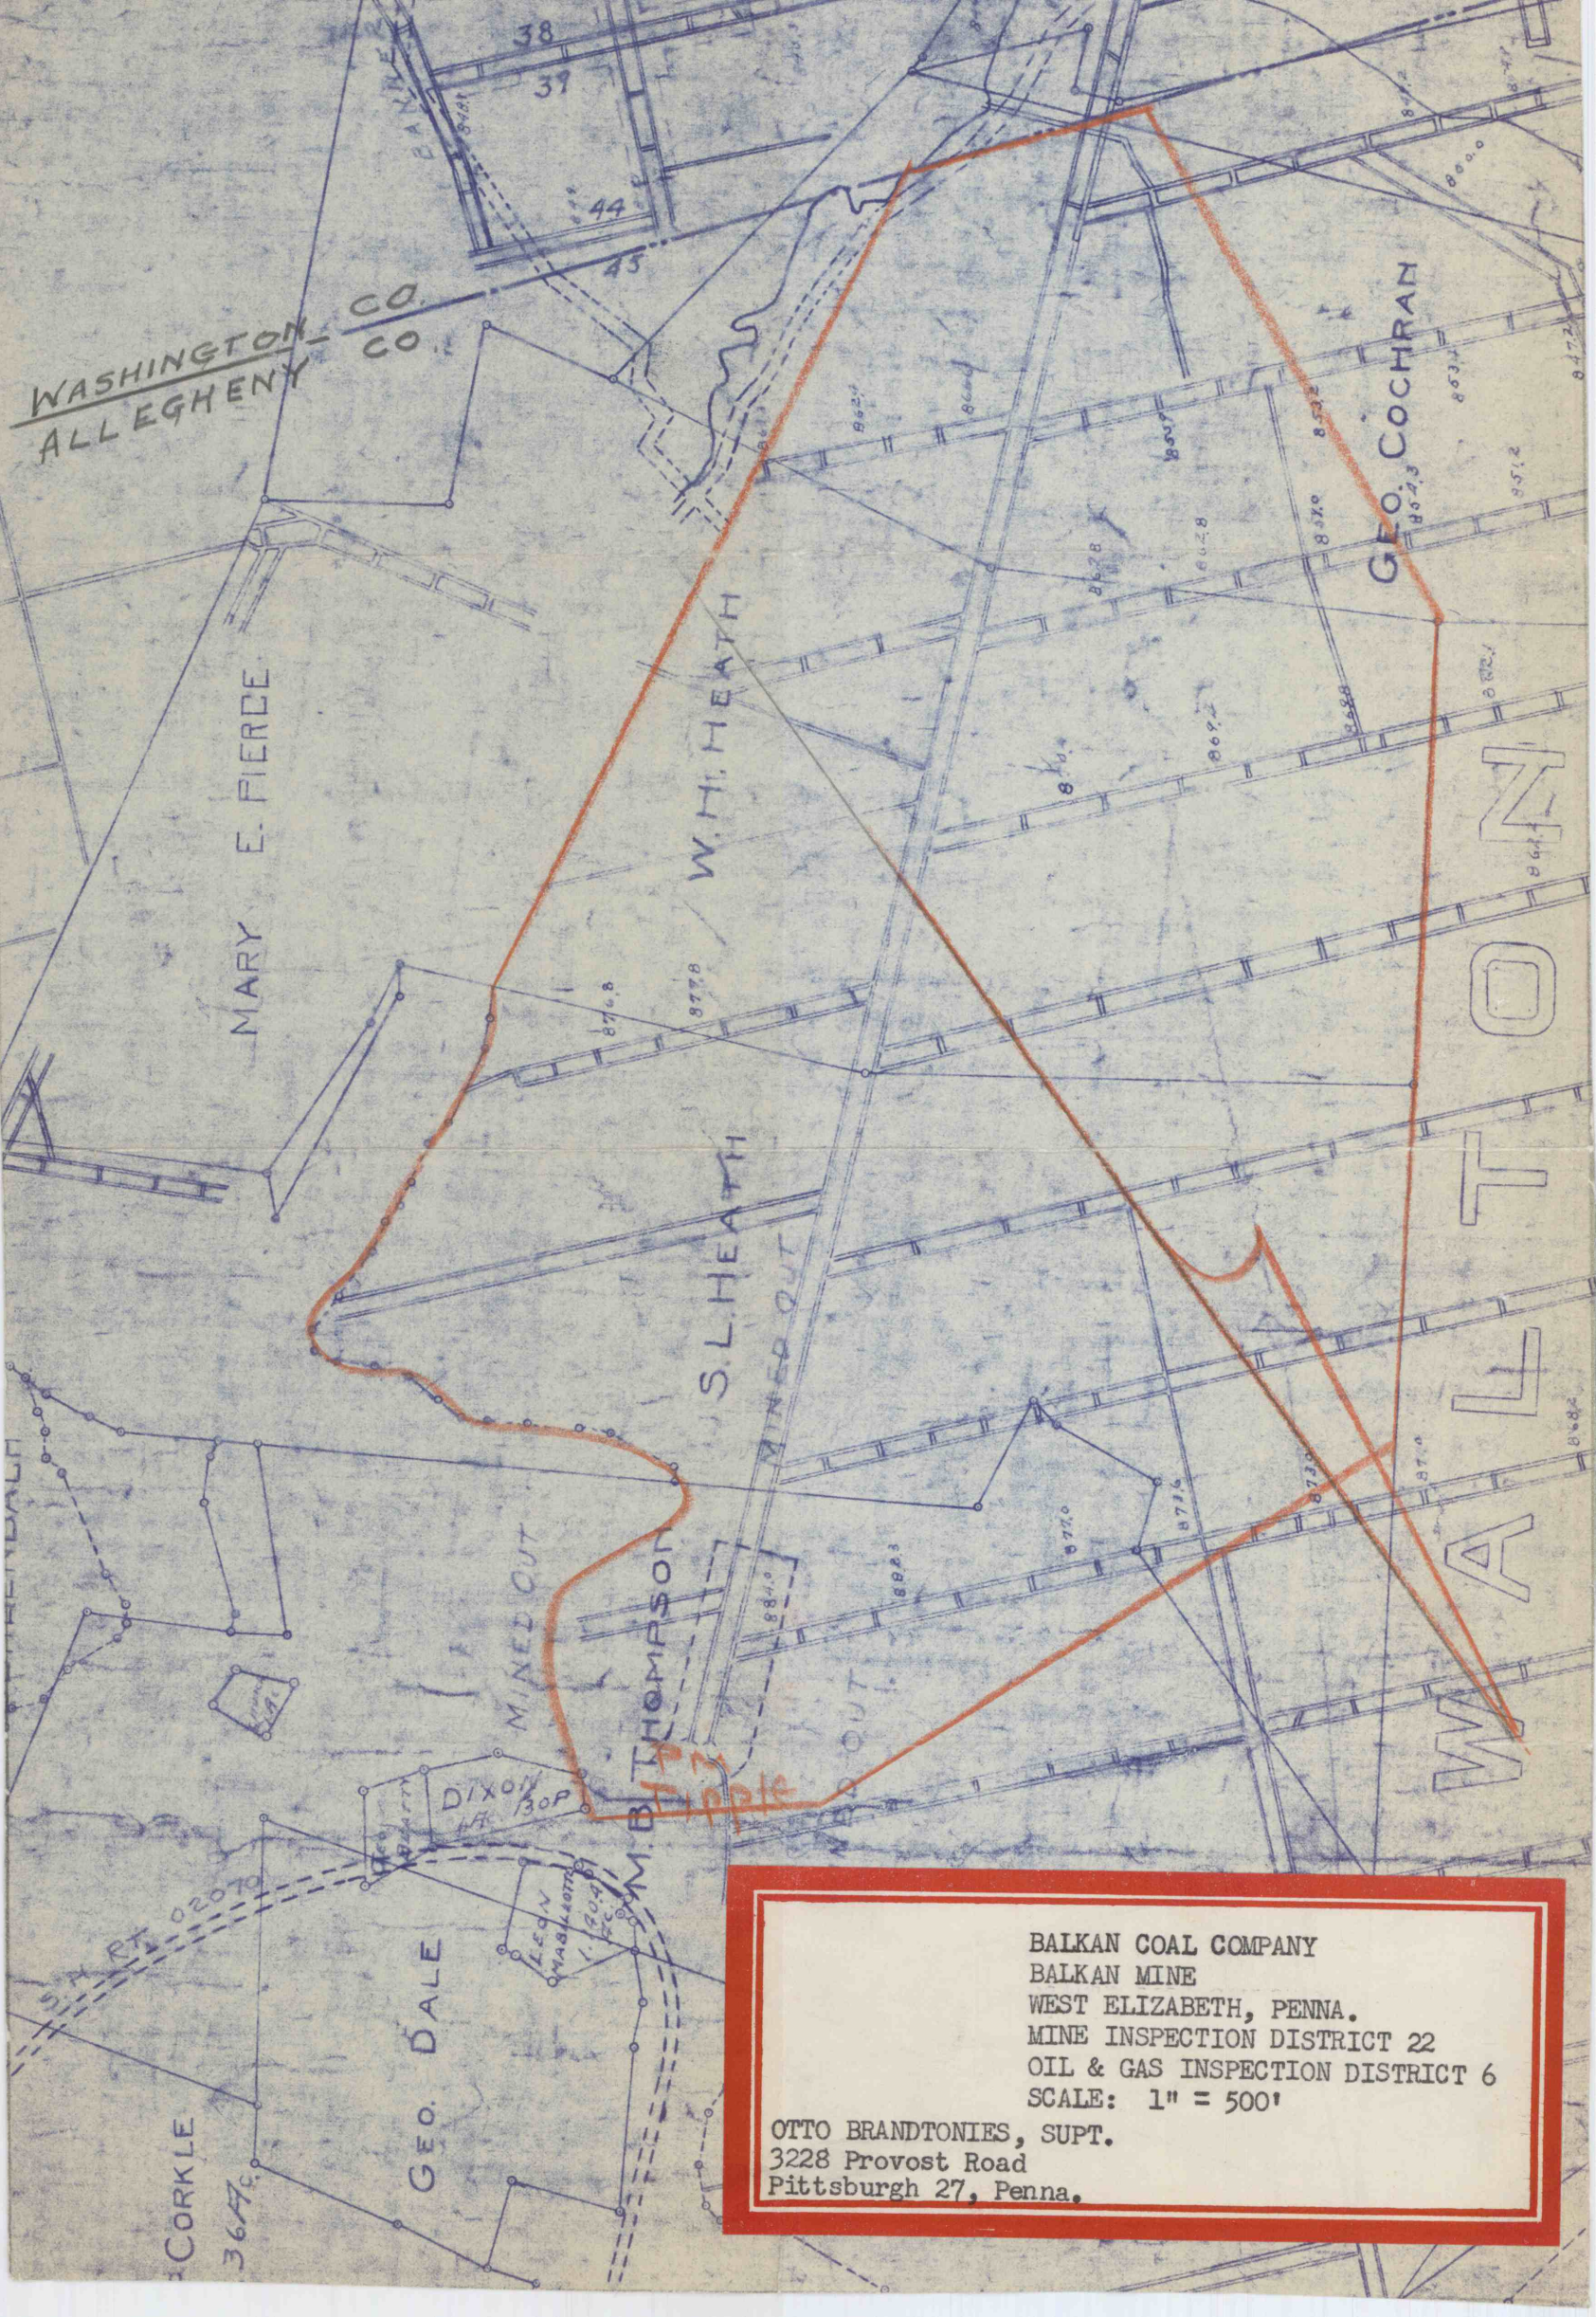

OTTO BRANDTONIES, SUPT.
3228 Provost Road
Pittsburgh 27, Penna.