


CHAS. POPE TRACT

CHAS. POPE TRACT

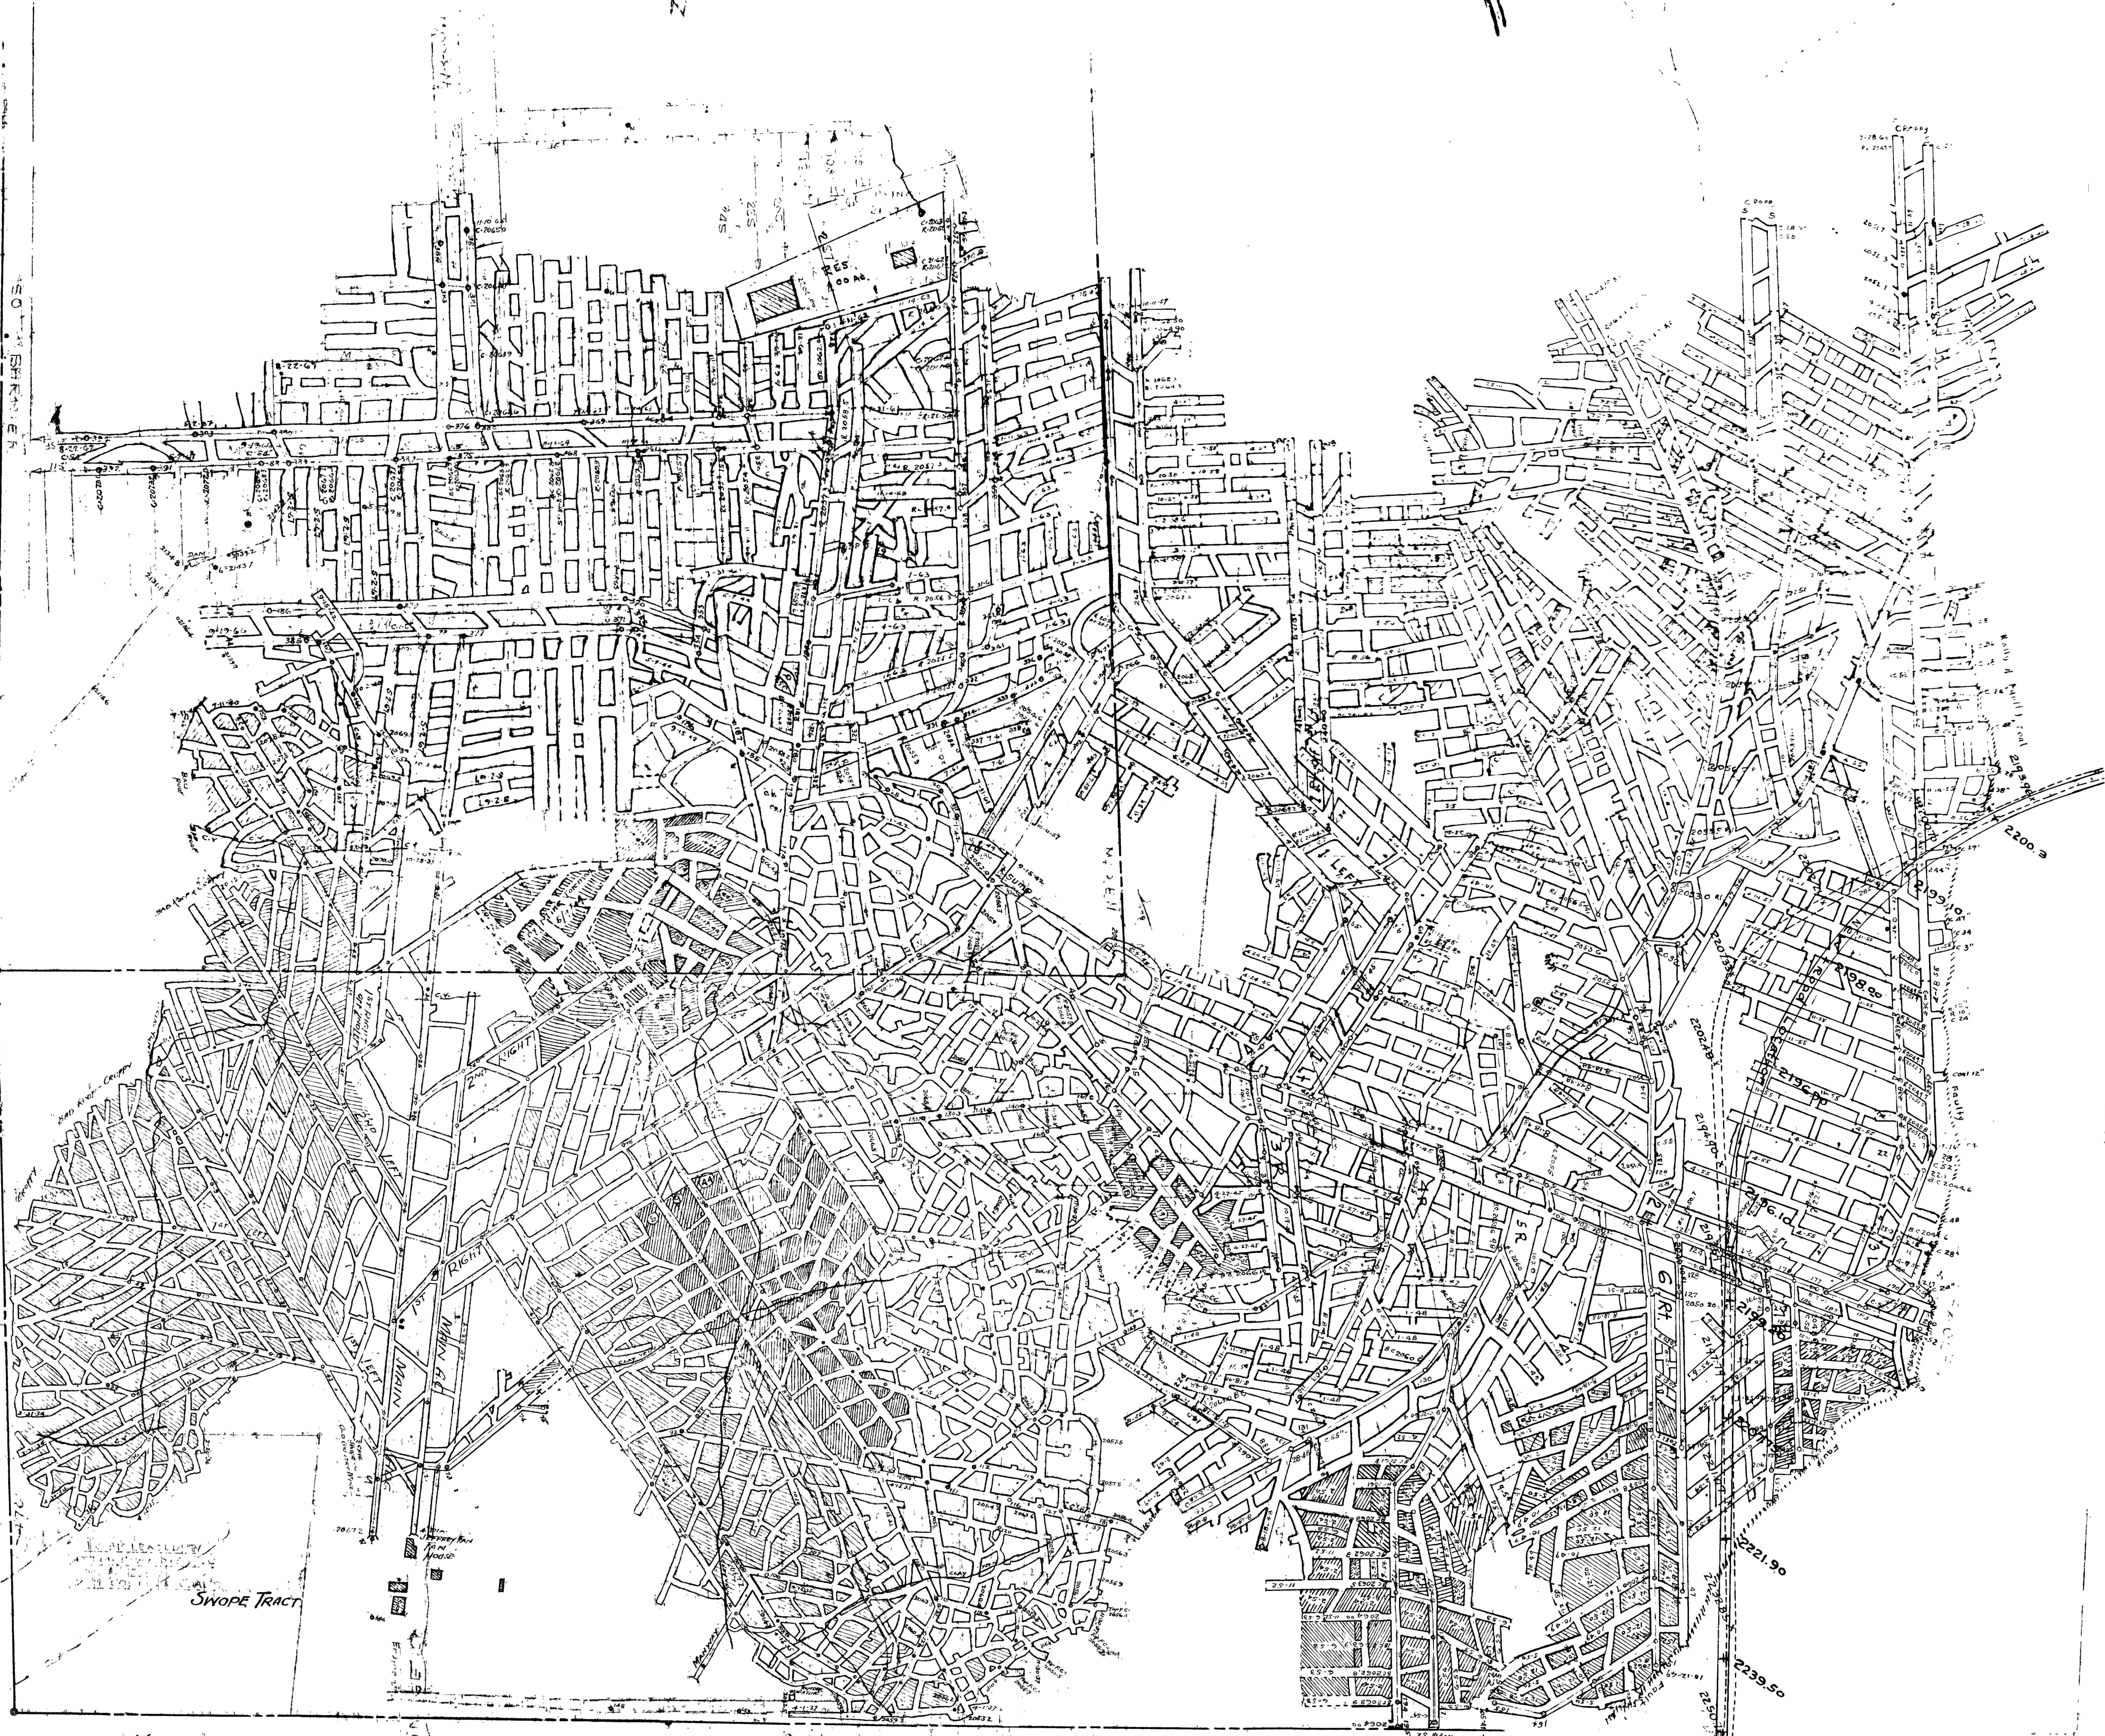

NATHAN FOSTER
(C.P.C. CORP. LEASE)

PRESENT OPERATOR JAMES HUNTER
PATTON CLAY MFG. CO.
MAP OF NO. 1 MINE

SCALE 1"=100'
C. PRIME SEAM

PATTON, PA. NOV. 1ST 1933
Marlin C. Kirsch, Engr.

STATE HIGHWAY TO PATTON
STATE HIGHWAY ROUTE 11054