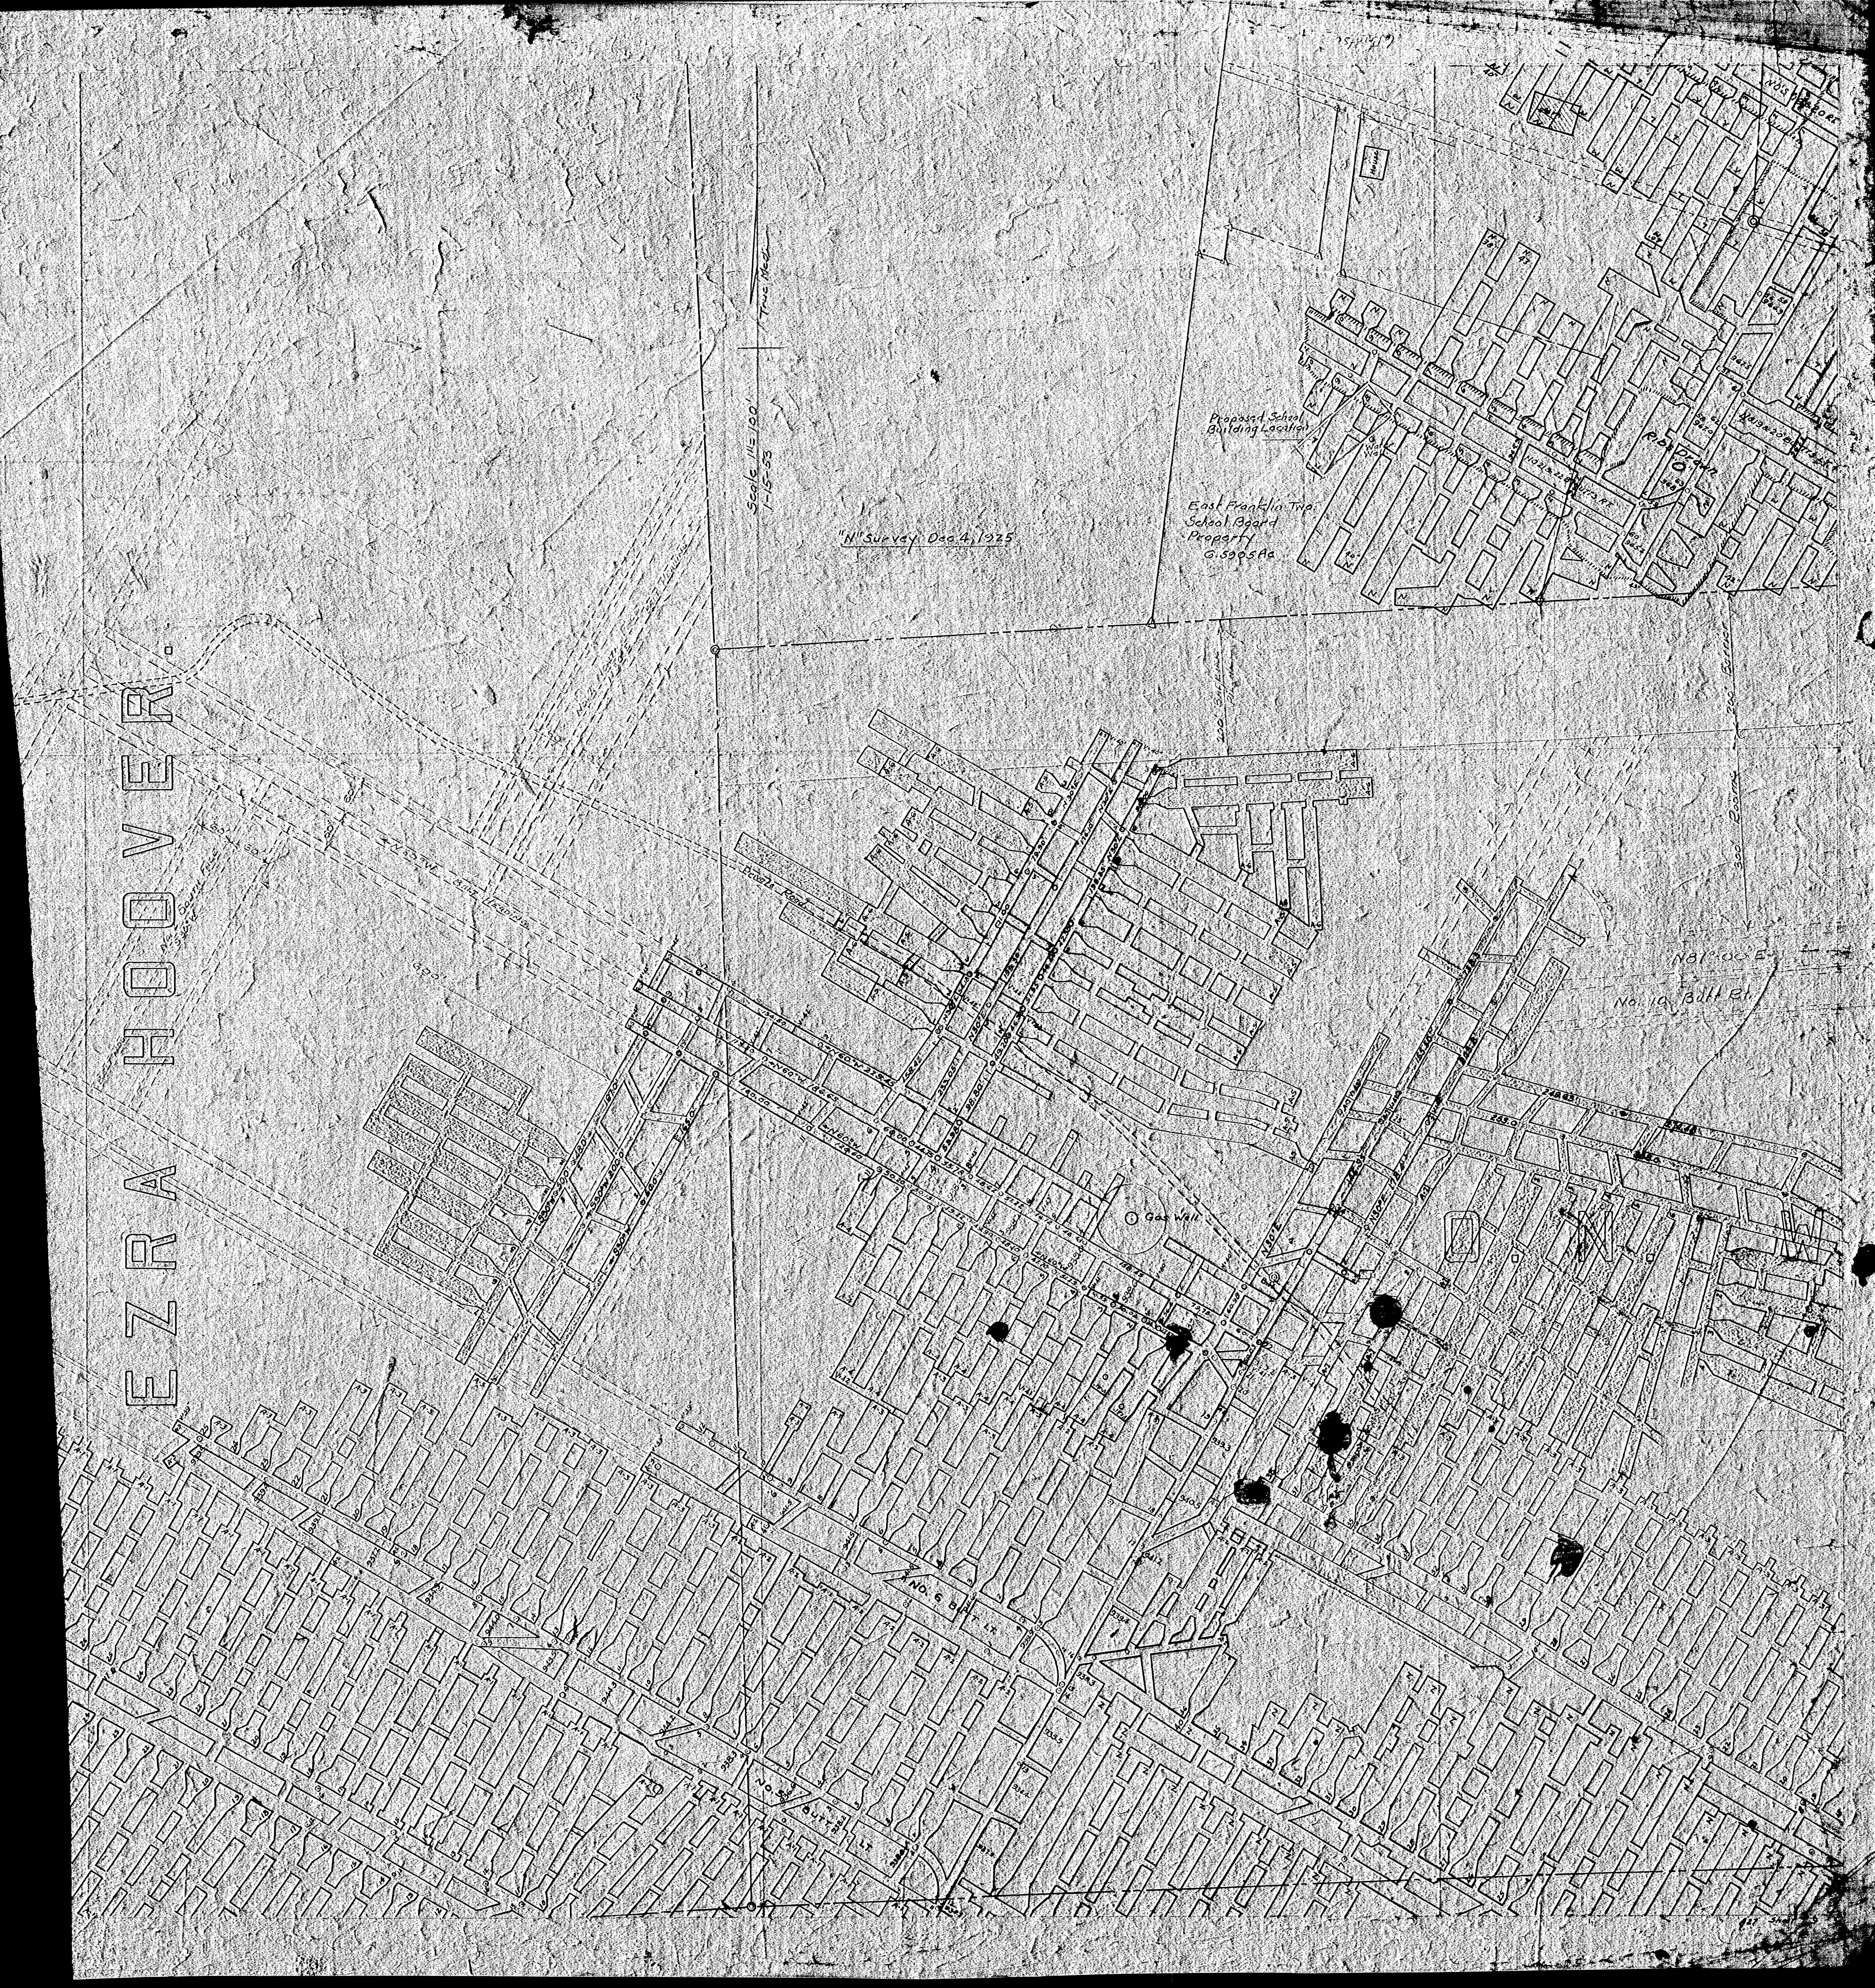
EZRA HOOVER
Scale 1"=100'
1-15-53
True Mer.
"N" Survey Dec 4, 1925
Proposed School Building Location
East Franklin Twp. School Board Property 6.5905 Ac.
Riderstown
No 19 & 20 Butts Lt.
No 21 & 22 Butts Rt.
Gas Well
N81°00'E
No. 10 Butt Rt.
NO. 6 BUTT LT.
NO. 5 BUTT LT.
390' Barrier