


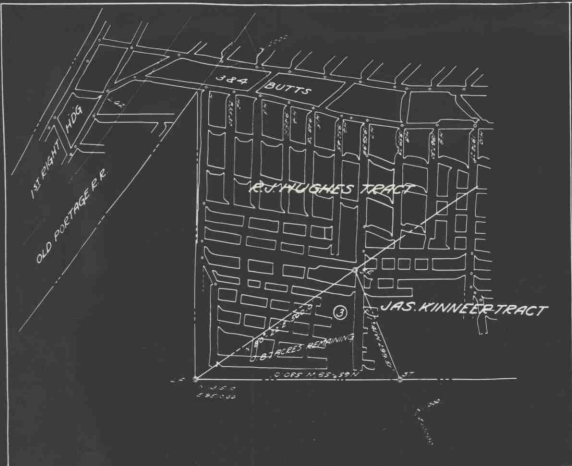

Map Showing
MINERAL IN CRESSON TWP CAMBRIA Co. PA.
CONVEYED TO THE
COMMONWEALTH OF PENNSYLVANIA
FROM THE
LILLY NO. 3 MINE "E" SEAM
OF
C. A. HUGHES & CO. CRESSON, PA.







LEASED TO STONE BRIDGE COAL CO.