


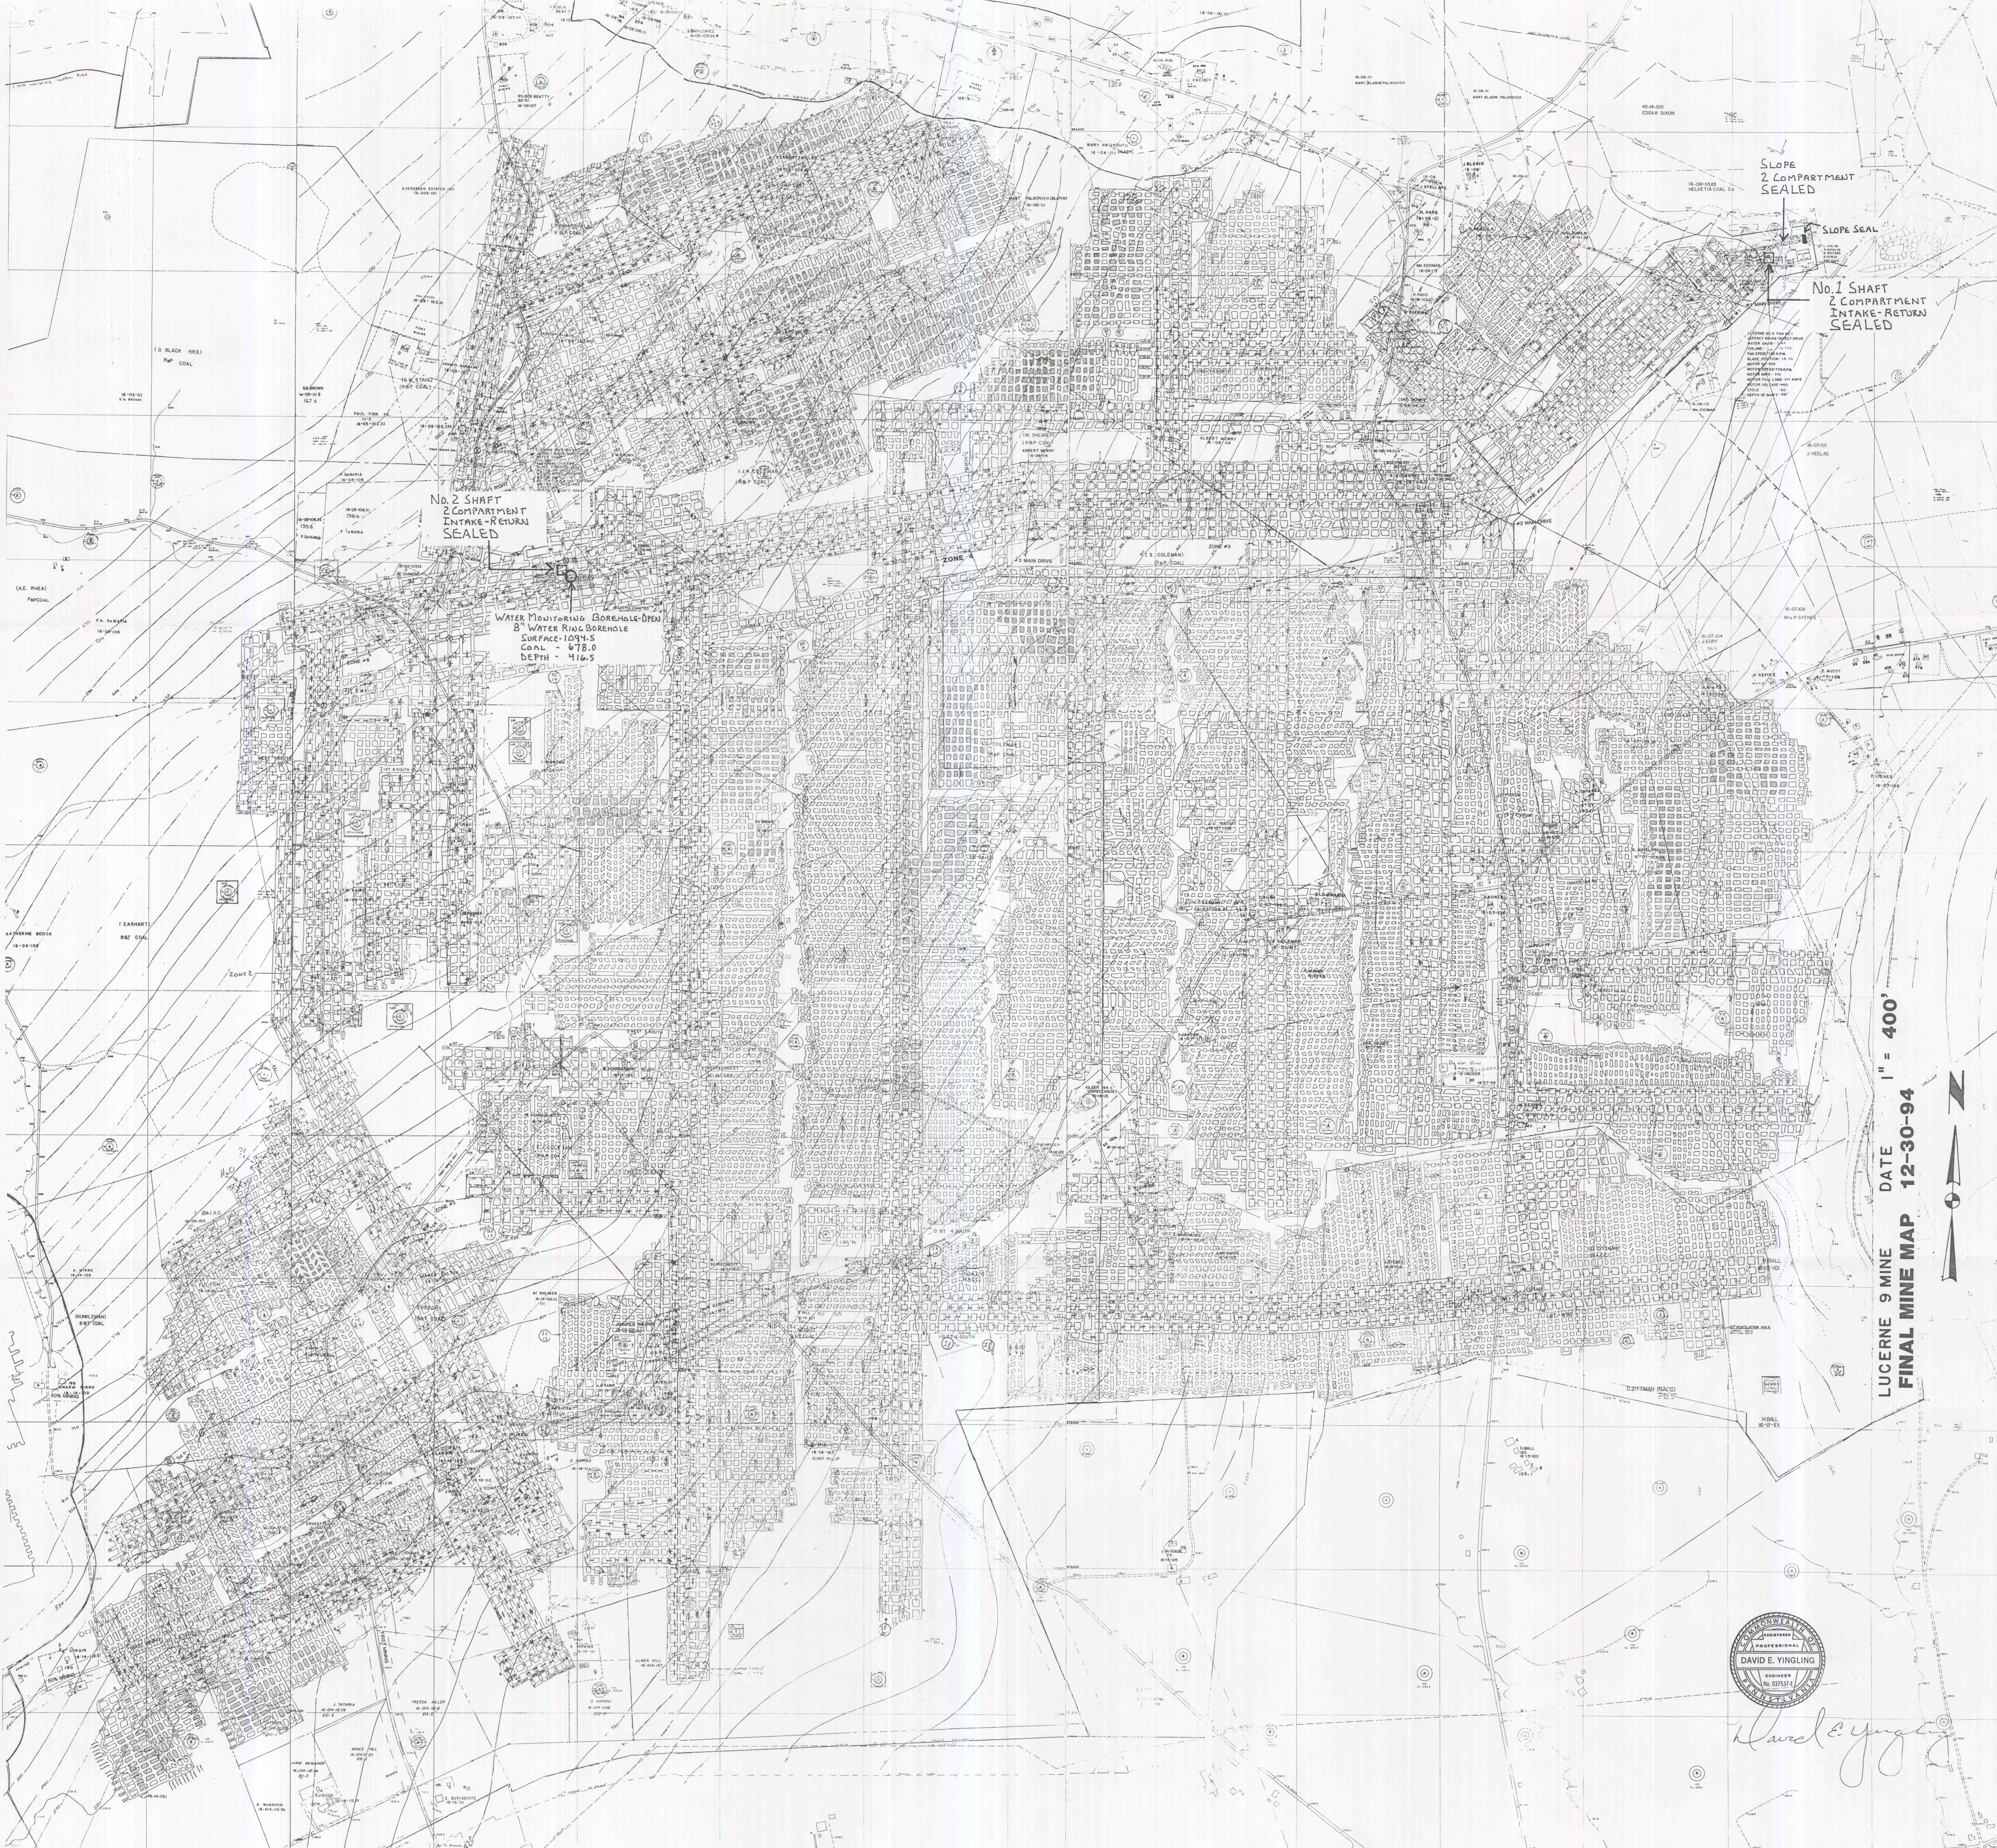



No. 2 SHAFT
2 COMPARTMENT
INTAKE-RETURN
SEALED

WATER MONITORING BOREHOLE-OPEN
8" WATER RING BOREHOLE
SURFACE-1094.5
COAL - 678.0
DEPTH - 416.5

SLOPE
2 COMPARTMENT
SEALED

No. 1 SHAFT
2 COMPARTMENT
INTAKE-RETURN
SEALED

LUCERNE 9 MINE DATE 12-30-94
FINAL MINE MAP 12-30-94

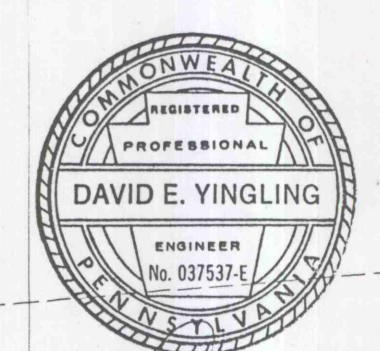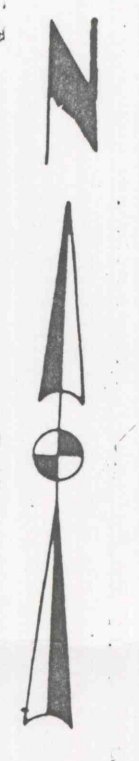

David E. Yingling