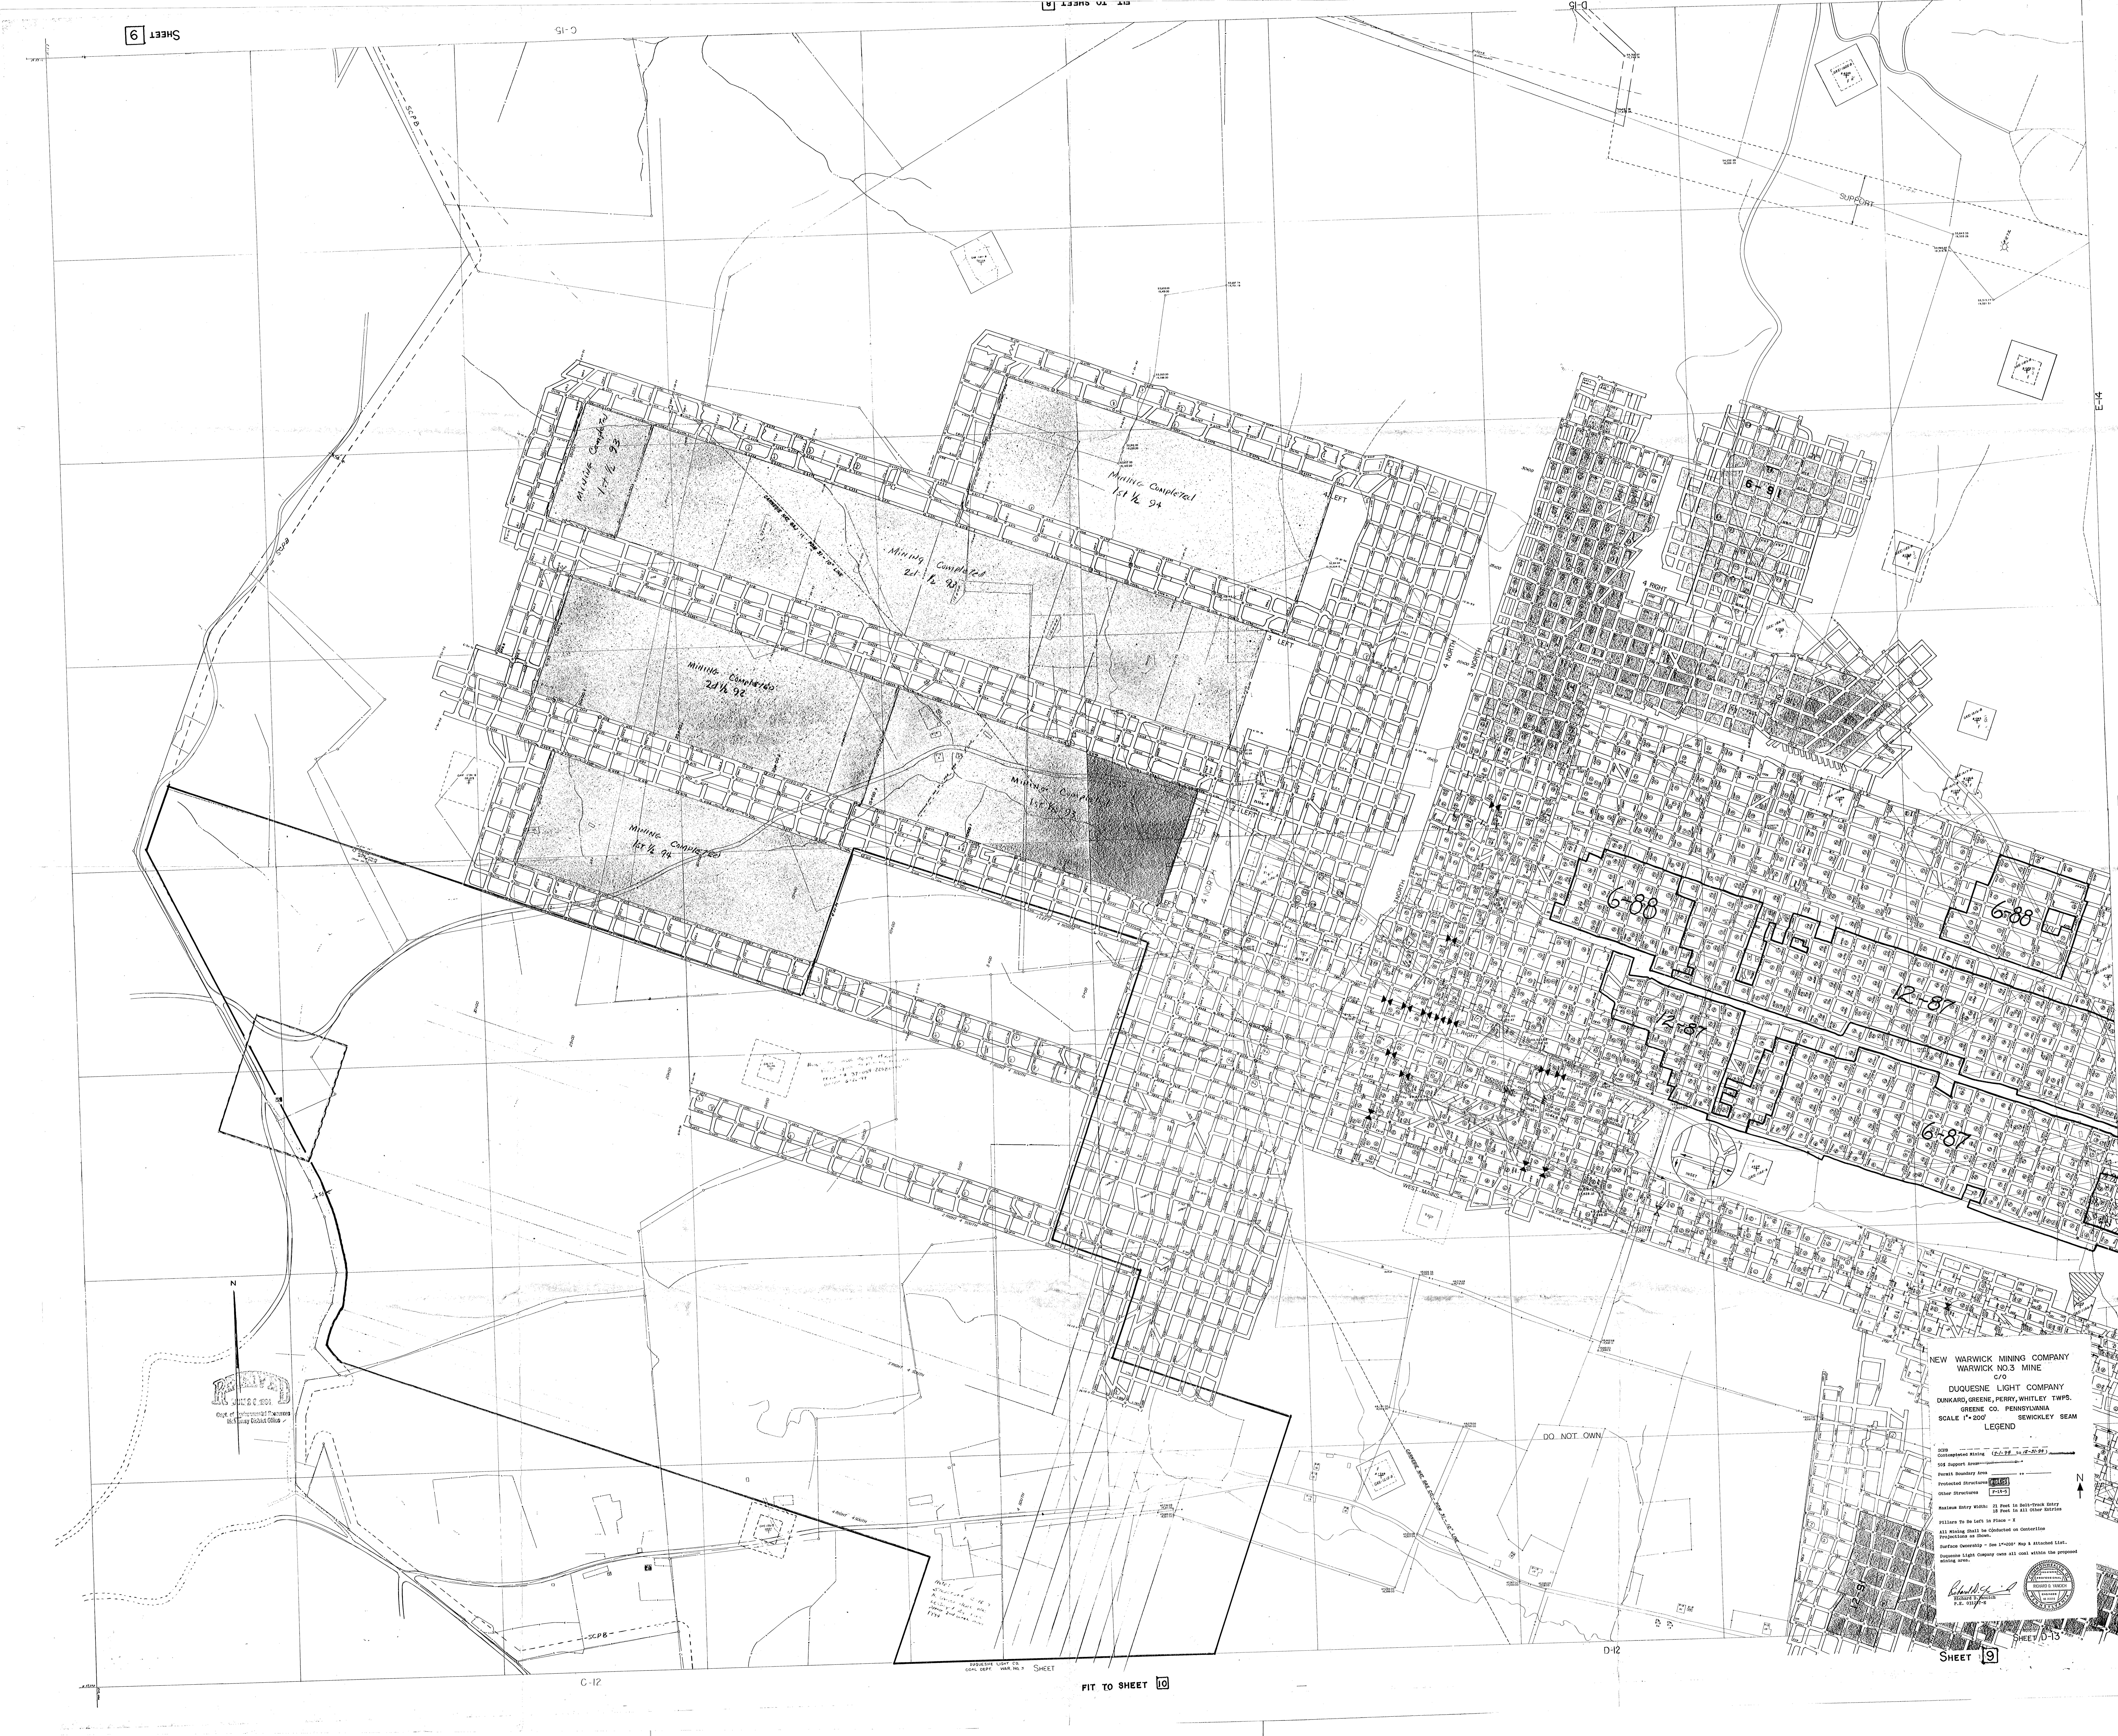
SHEET 9
C-15
FIT TO SHEET 8
D-15
E-14
SCPB
SUPPORT
Mining Completed 1st ½ 93
Mining Completed 2d ½ 93
Mining Completed 1st ½ 94
Mining Completed 2d ½ 92
Mining Completed 1st ½ 93
Mining Completed 1st ½ 94
CARNEGIE NAT. GAS CO. - PDM 31 - 10" LINE
4 LEFT
3 LEFT
2 LEFT
1 LEFT 4 NORTH
4 NORTH
3 NORTH
4 RIGHT
6-91
12-91
6-92
6-88
6-88
12-87
12-87
6-87
12-91
1 RIGHT
ROCKDUST BOREHOLE
NORTH SHAFT
TOP OF COPING 1044.8
SEE INSET
WATER BOREHOLE
INSET
ESCAPEWAY
WEST MAINS
BELT-TRACK
"SEE CHECKLINE BOOK SHEETS 22-23"
1 RIGHT 4 SOUTH
2 RIGHT 4 SOUTH
3 RIGHT 4 SOUTH
4 RIGHT 4 SOUTH
4 SOUTH
Permit # 37-059-2258 ... Dated 6-26-94
DO NOT OWN
CARNEGIE NAT. GAS CO. - PDM 31 - 10" LINE
Note: Structure 2-13-9 ... was destroyed by fire approx 2nd week May 1994
DUQUESNE LIGHT CO. COAL DEPT. WAR. NO. 3 SHEET
FIT TO SHEET 10
C-12
D-12
SHEET D-13
N
RECEIVED JUL 26 1994 Dept. of Environmental Resources McMurray District Office

NEW WARWICK MINING COMPANY
WARWICK NO.3 MINE
C/O
DUQUESNE LIGHT COMPANY
DUNKARD, GREENE, PERRY, WHITLEY TWPS.
GREENE CO. PENNSYLVANIA
SCALE 1" = 200' SEWICKLEY SEAM

LEGEND

SCPB
~~Contemplated~~ Contemplated Mining (7-1-94 to 12-31-94)

50% Support Area

Permit Boundary Area ——— ++ ———

Protected Structures F-14-3

Other Structures F-14-5

N

Maximum Entry Width:	21 Feet in Belt-Track Entry 18 Feet in All Other Entries

Pillars To Be Left in Place - X

All Mining Shall be Conducted on Centerline Projections as Shown.

Surface Ownership - See 1"=200' Map & Attached List.

Duquesne Light Company owns all coal within the proposed mining area.

Richard D. Yancich

Richard D. Yancich
P.E. 031247-E

RICHARD D. YANCICH
NO. 31247-E

SHEET 9