


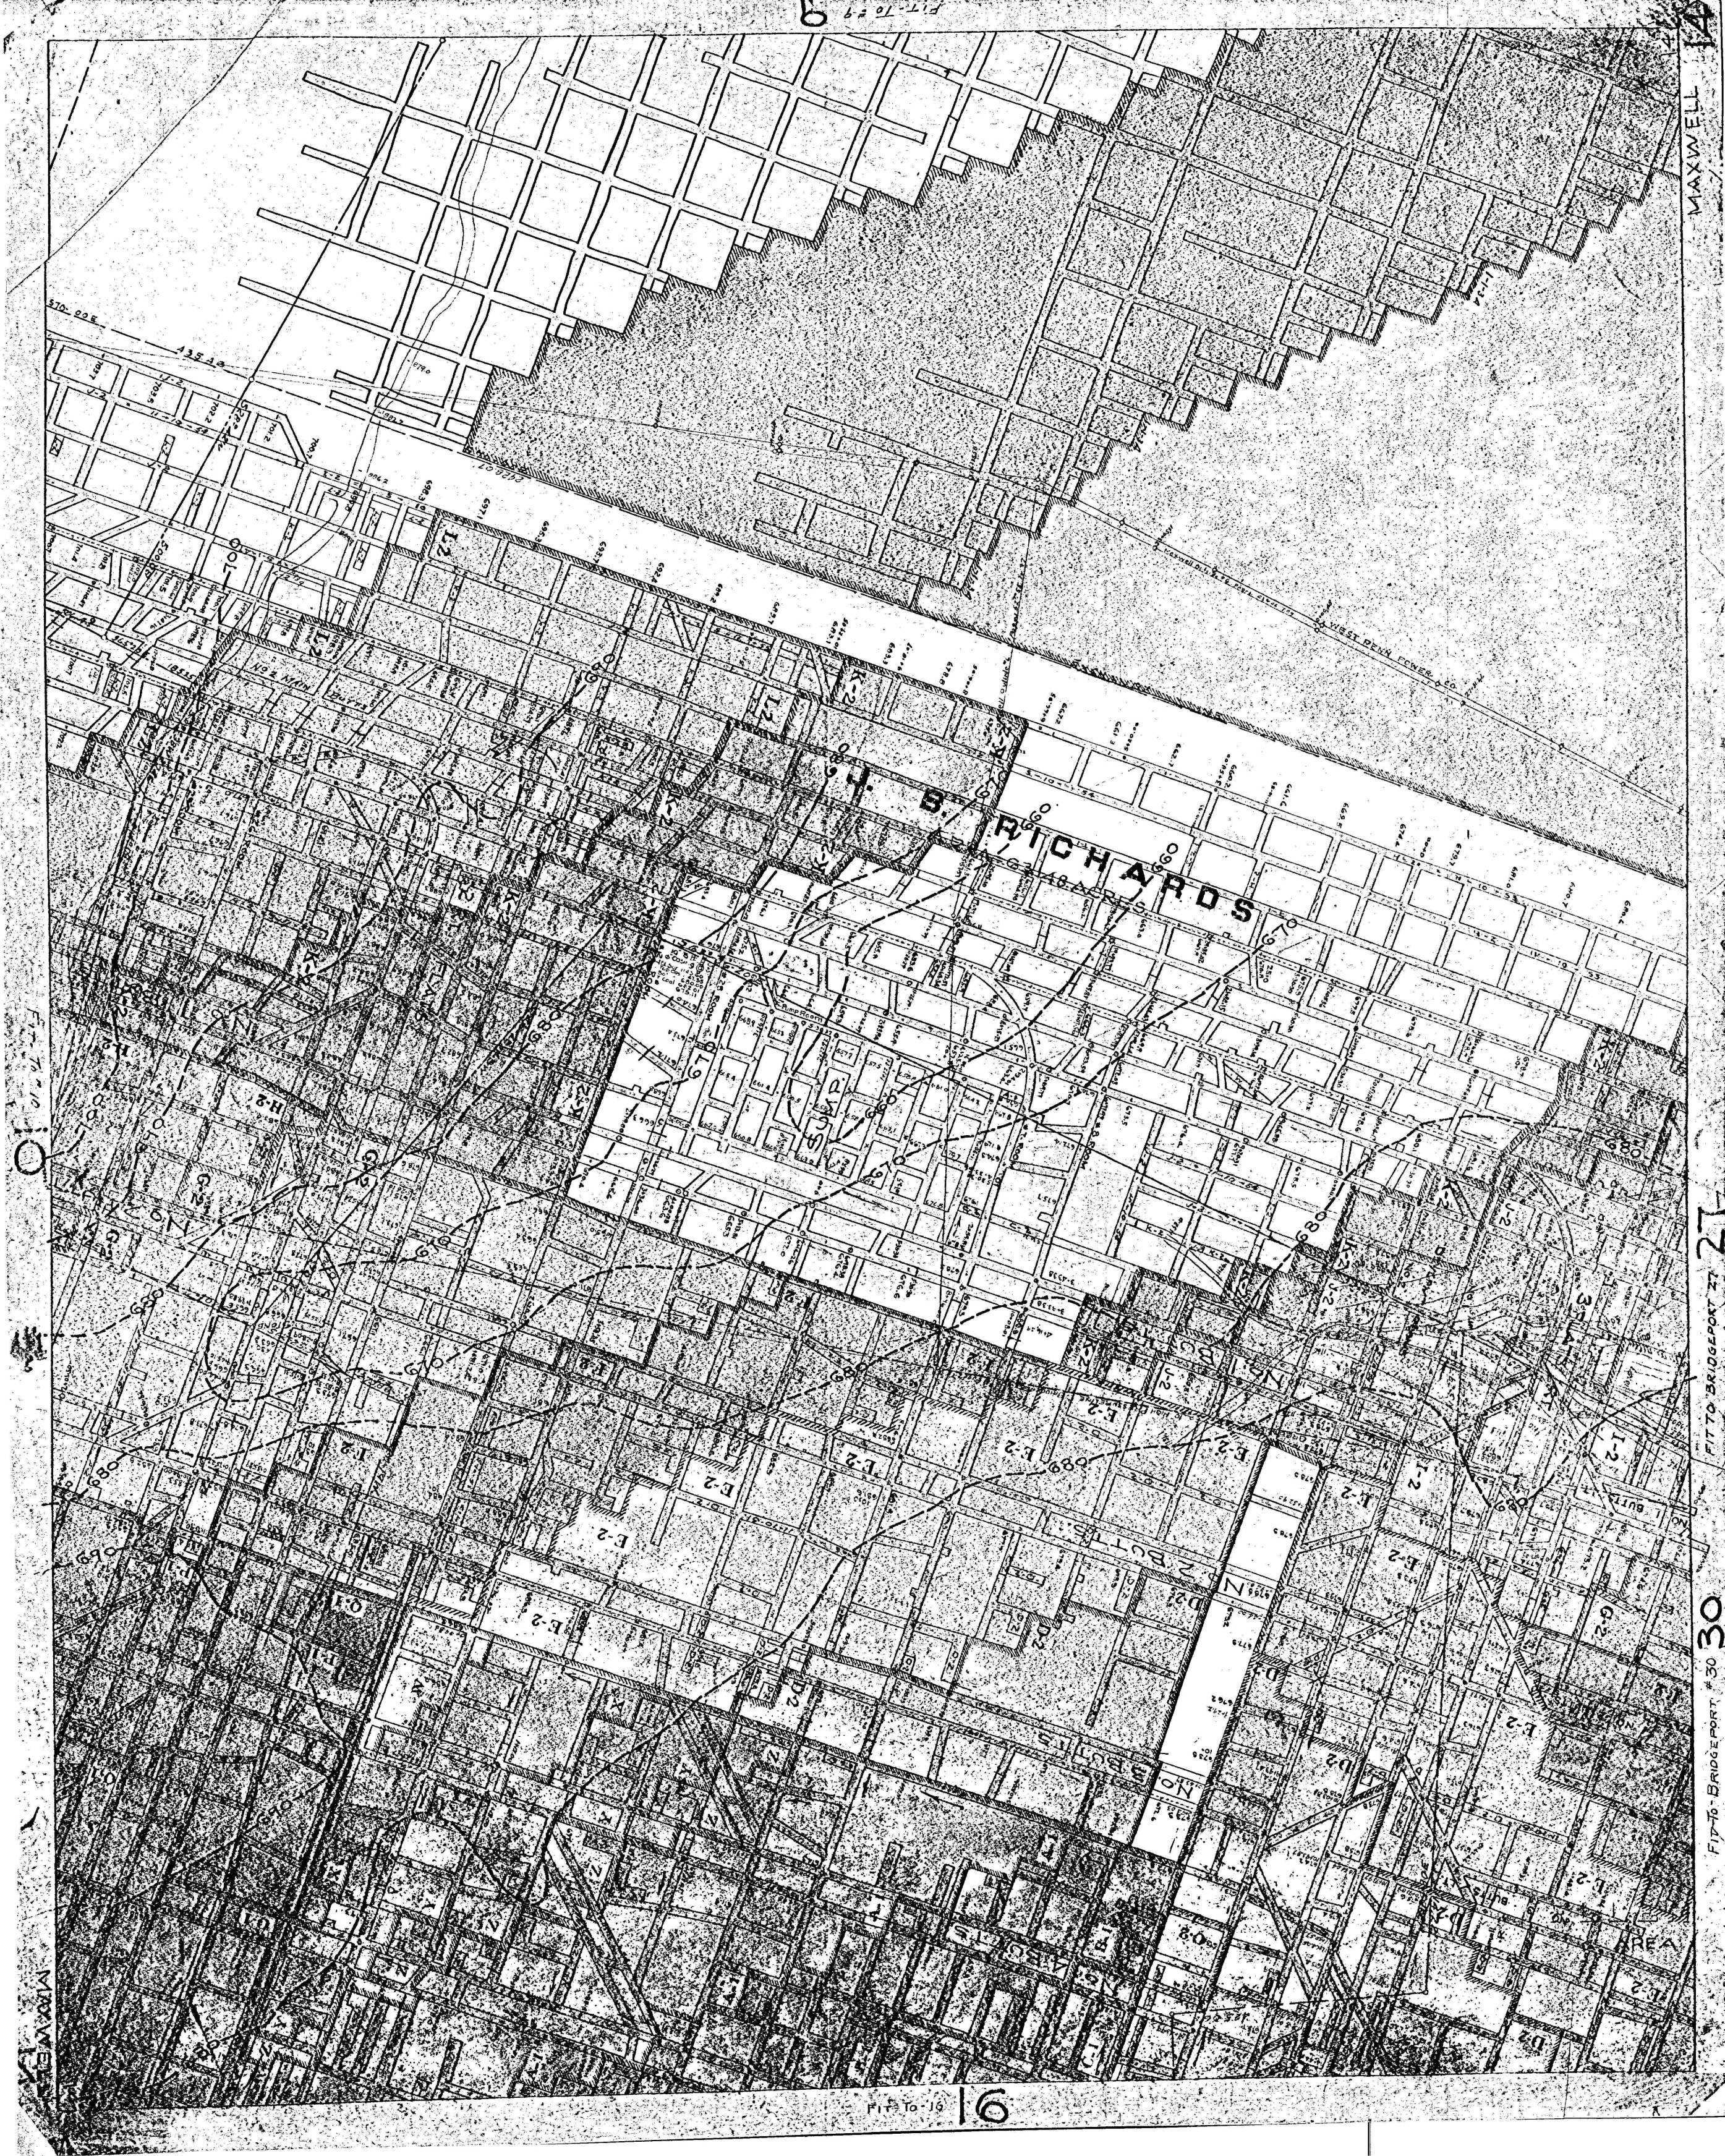

MAXWELL

FIT TO BRIDGEPORT 27

FIT TO BRIDGEPORT # 30

MAXWELL