

MINE MAP
GEORGE SOLTIS & SONS COAL CO.
COAL MINE

Banks Township, Indiana County, Pa.
Scale 1"=200'


August 28, 1957
Walter J. Zimmerman Surveyor Engineer Punxsutawney, Pa.
12-1961

GEORGE SOLTIS
(Coal and Surface)

GILBERT MERRLING
(Surface)
GEORGE SOLTIS
(Coal)

AUGUST SAULSTROM

J.O. CLARK Heirs.

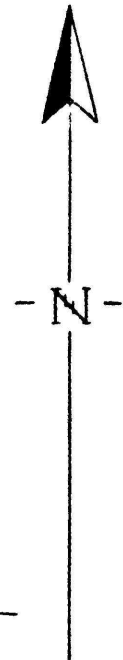

SARAH JOHNSTON

JAMES RADCLIFFE

TOWNSHIP ROAD 972

ROSSITER

State Route L.R. 573
Concrete Pavement

Traffic Route 336

TOGEN CAMPBELL

OLD WORKING

OLD WORKING

OLD WORKING

COAL

OUT-CR-P

STRIPPED
-A SMALL-