


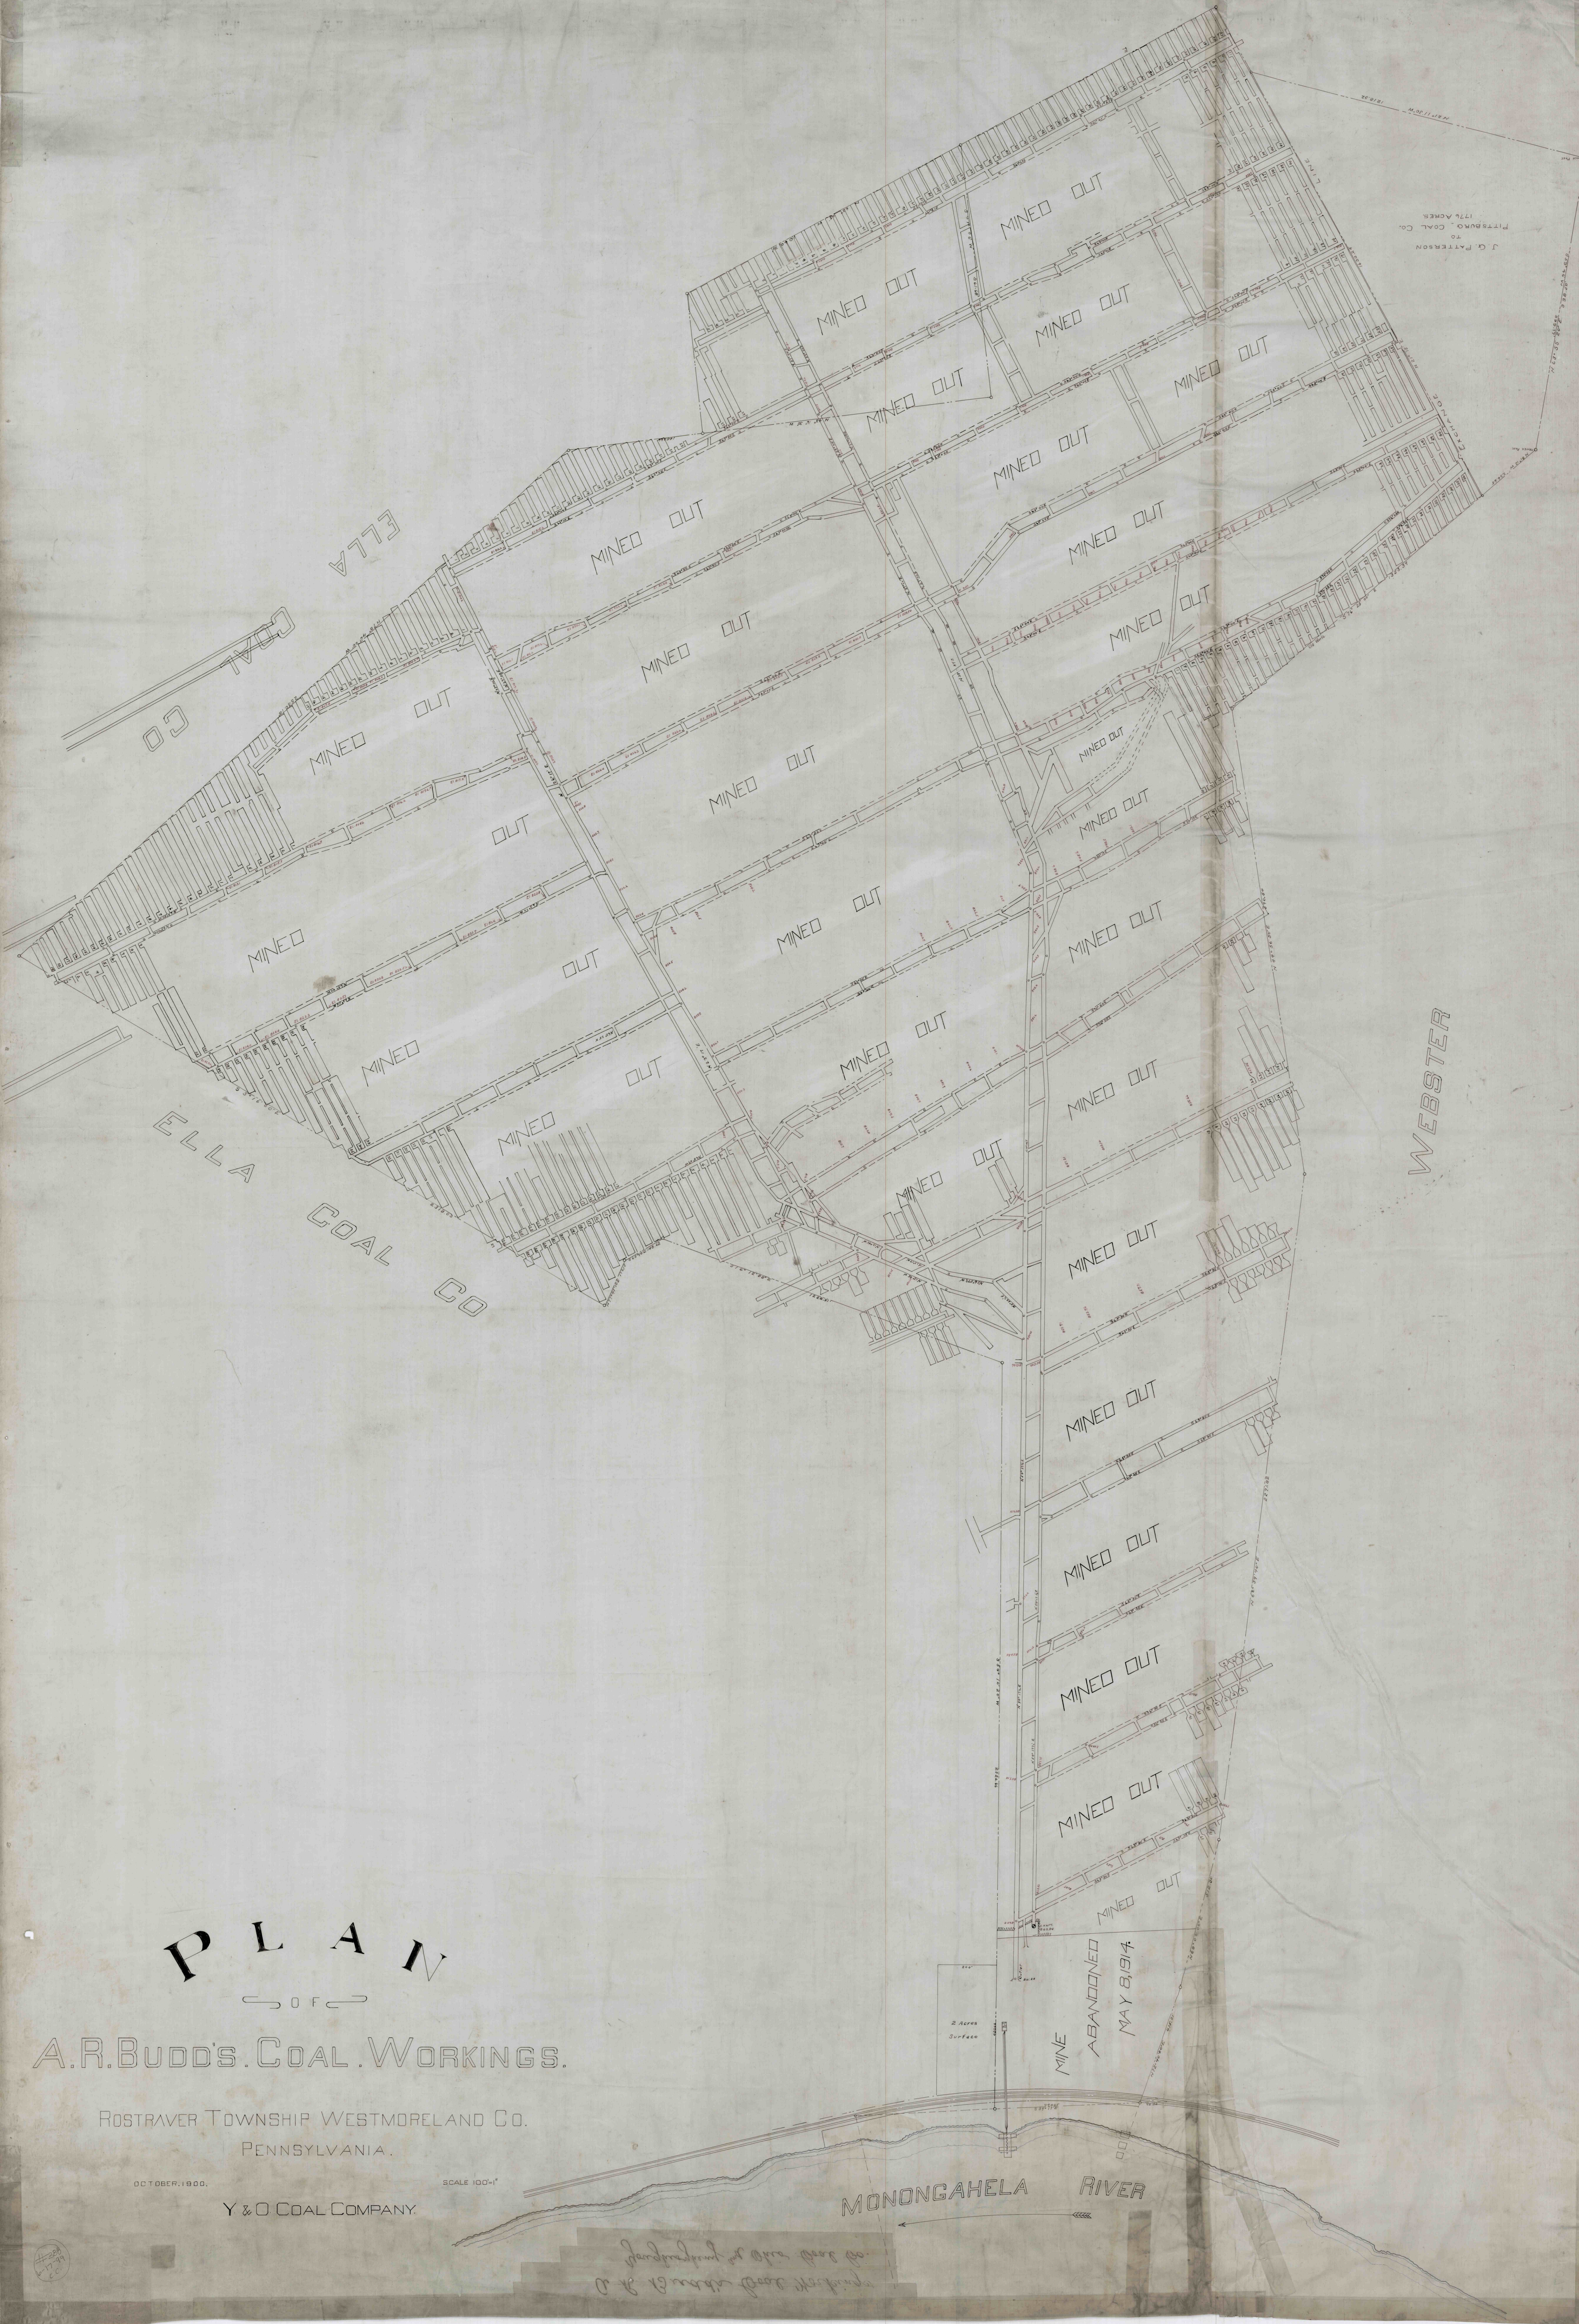

J. G. PATTERSON
TO
PITTSBURGH COAL CO.
1776 ACRES

WEBSTER

PLAN OF

A.R. BUDD'S COAL WORKINGS.

ROSTRAVER TOWNSHIP WESTMORELAND CO.
PENNSYLVANIA.

OCTOBER, 1900.

Y & O COAL COMPANY.

SCALE 100'-1"

MONONGAHELA RIVER

MINE
ABANDONED
MAY 8, 1914

2 Acres
Surface

Handwritten note:
The mine was abandoned
on 13th May 1914