




- LEGEND:
- MINE PERMIT BOUNDARY, 5 YEAR MINING AREA AND SUBSIDENCE CONTROL PLAN BOUNDARY
 - PROPERTY BOUNDARY
 - EXISTING DEED MINE
 - DOMESTIC WATER WELL
 - GAS WELL
 - DRILL HOLE LOCATION
 - UK - OUTCROP - UPPER KITTANNING SEAM
 - BELT CONVEYOR
 - PERMANENT STOPPINGS
 - TRACK

- MINE SUBSIDENCE PLAN LEGEND:
PROJECTION NO. 7
- PROPOSED SIX MONTH PROJECTION 4/21/95 THRU 10/21/95
 - COAL BARRIER
 - 50% EXTRACTION AREA
 - NO MINING AREA
 - PREVIOUS SURFACE MINED AREA
 - SUBSIDENCE CONTROL PLAN BOUNDARY
 - CMAP PERMIT BOUNDARY
 - STRUCTURES EXIST. PRIOR TO APR. 27, 1966
 - SURFACE SUPPORT AREA 24.2 AC.

NOTE:
THERE ARE NO UNDERGROUND MINE WORKINGS LOCATED ABOVE OR BELOW THE SEAM BEING MINED.

MAP SHOWING FINAL MINE WORKINGS AS PER FINAL SURVEY CONDUCTED 12/13/95.

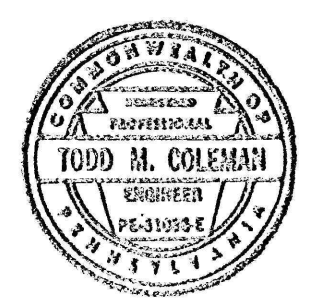

RED OAK MINING COMPANY
SOUTH MINE
CMAP #11851302
SITUATE
CHEST TWP., CAMBRIA CO., PA.

SCALE: 1"=200'
DATE: MAR 24 1997

MINETECH ENGINEERS
ALTOONA, PENNSYLVANIA