


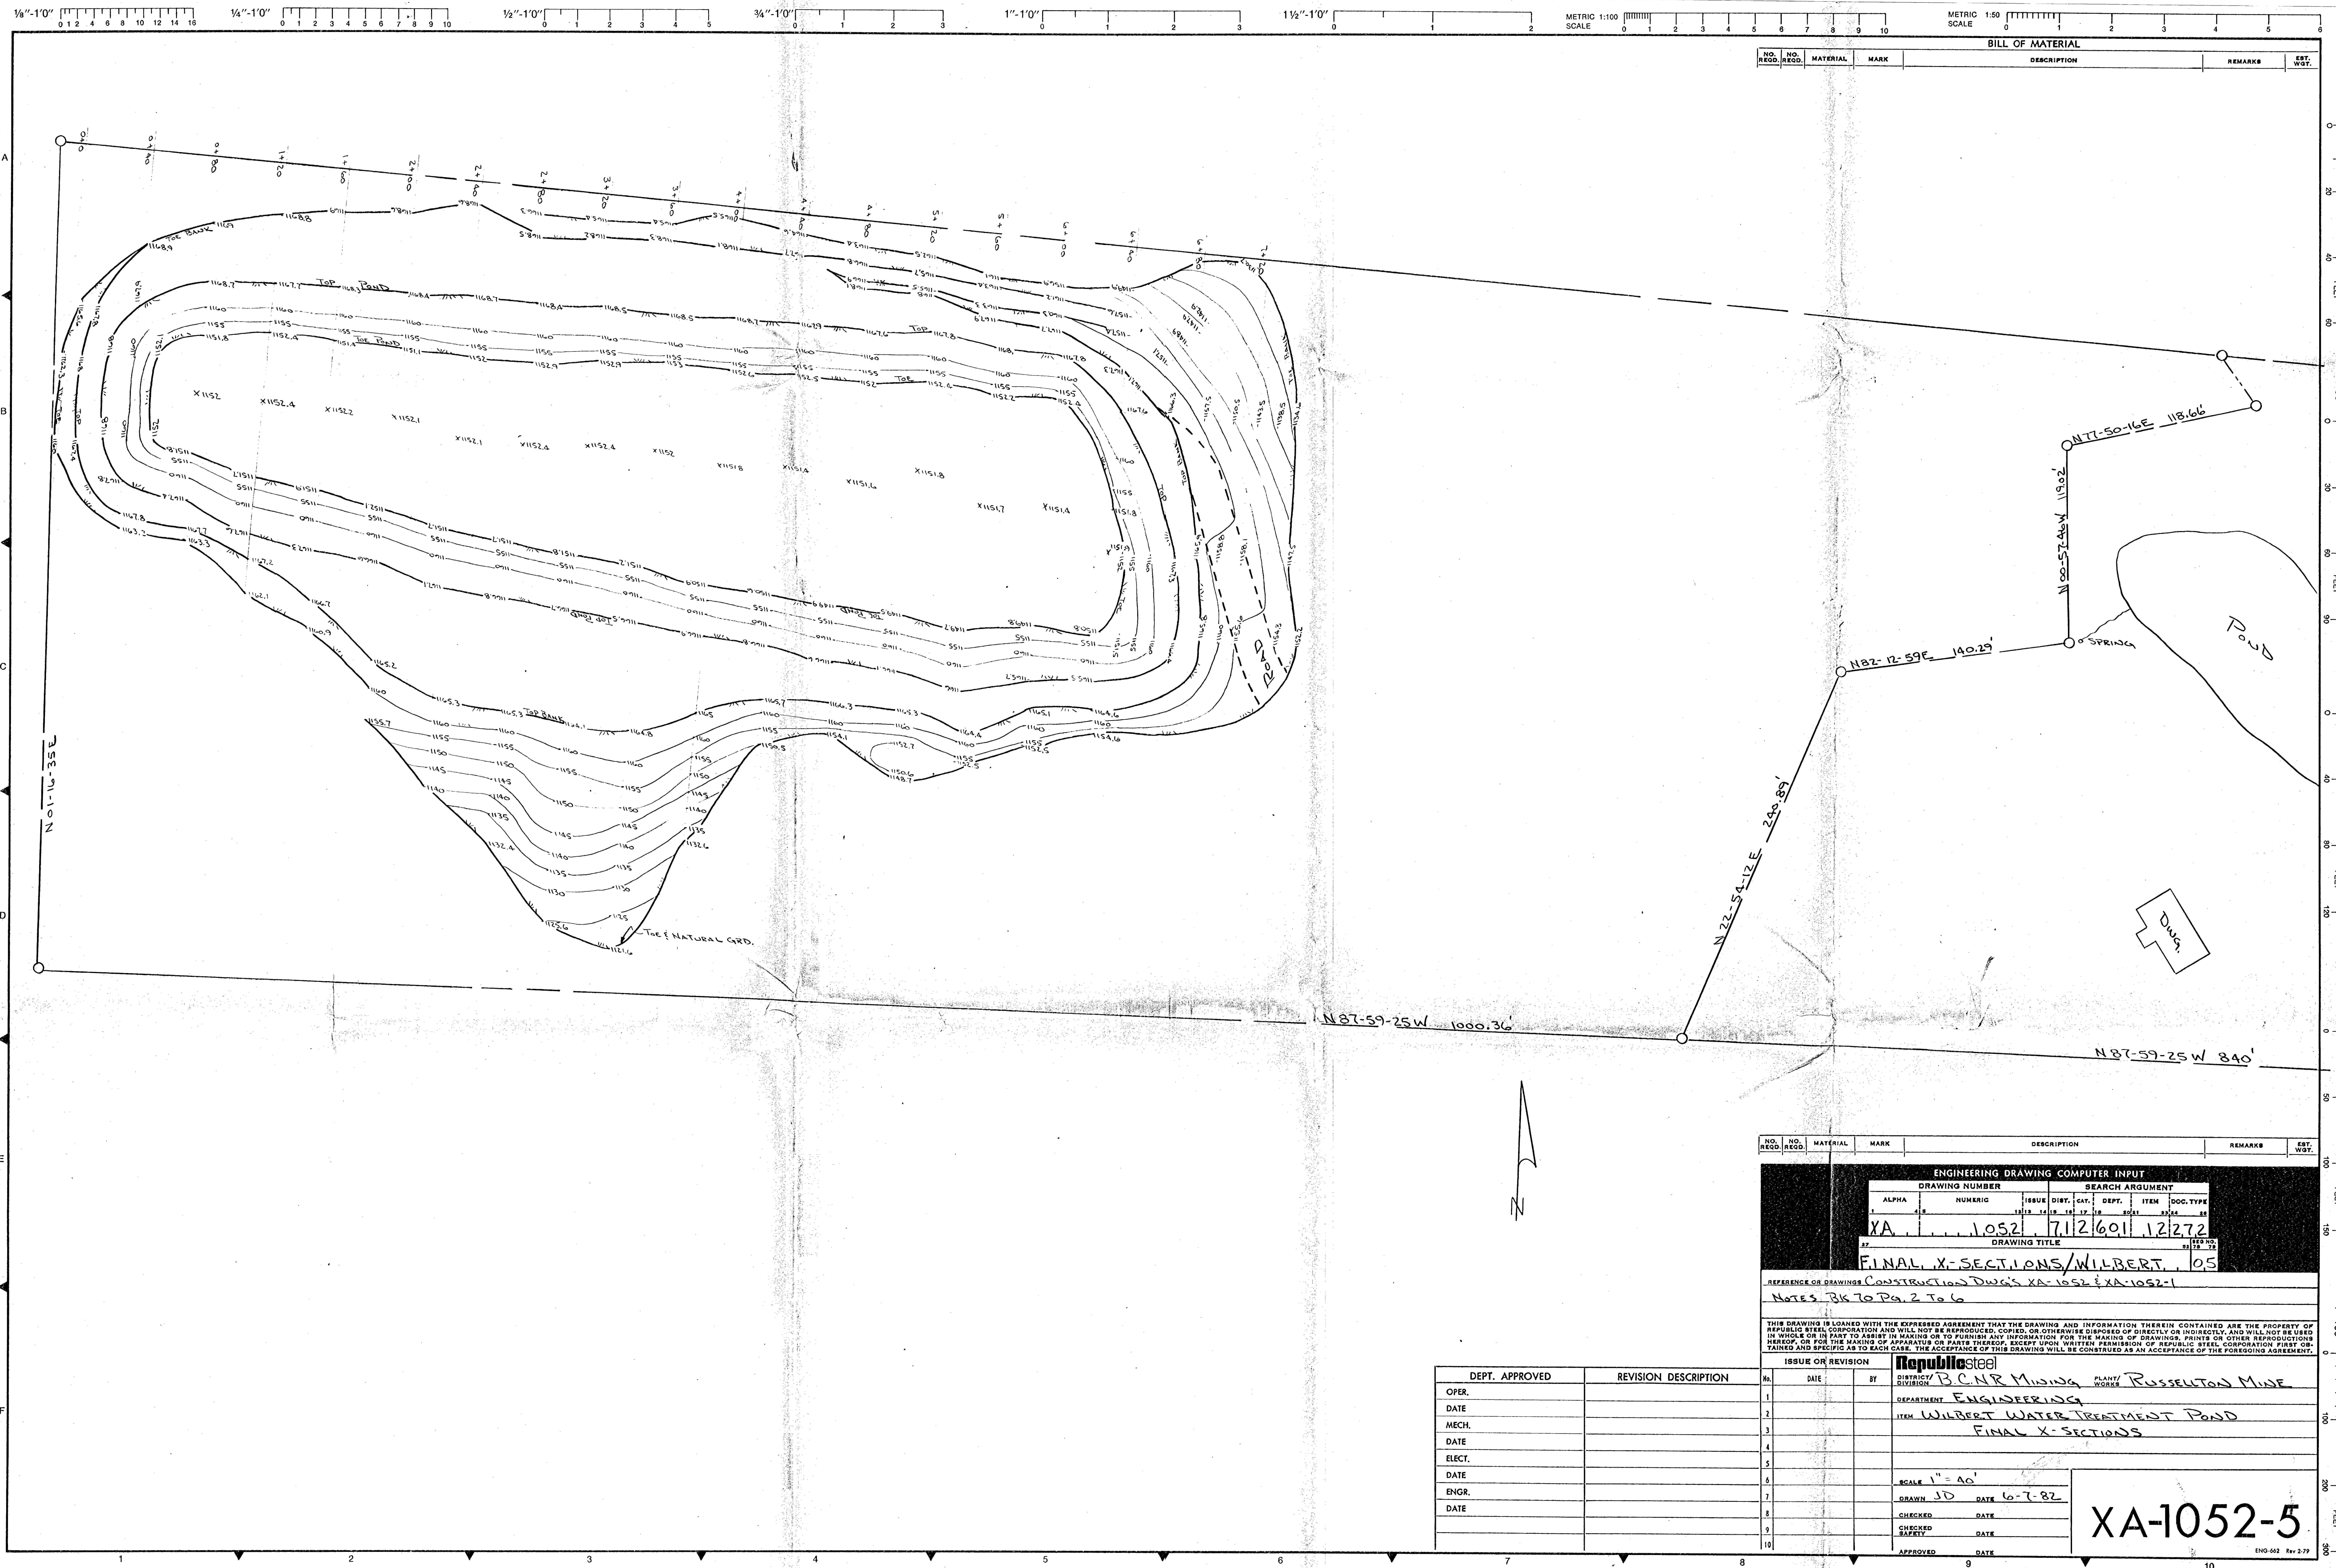

RECEIVED
JAN 6 1988
Dept. of Environmental Resources
McMurray District Office.