


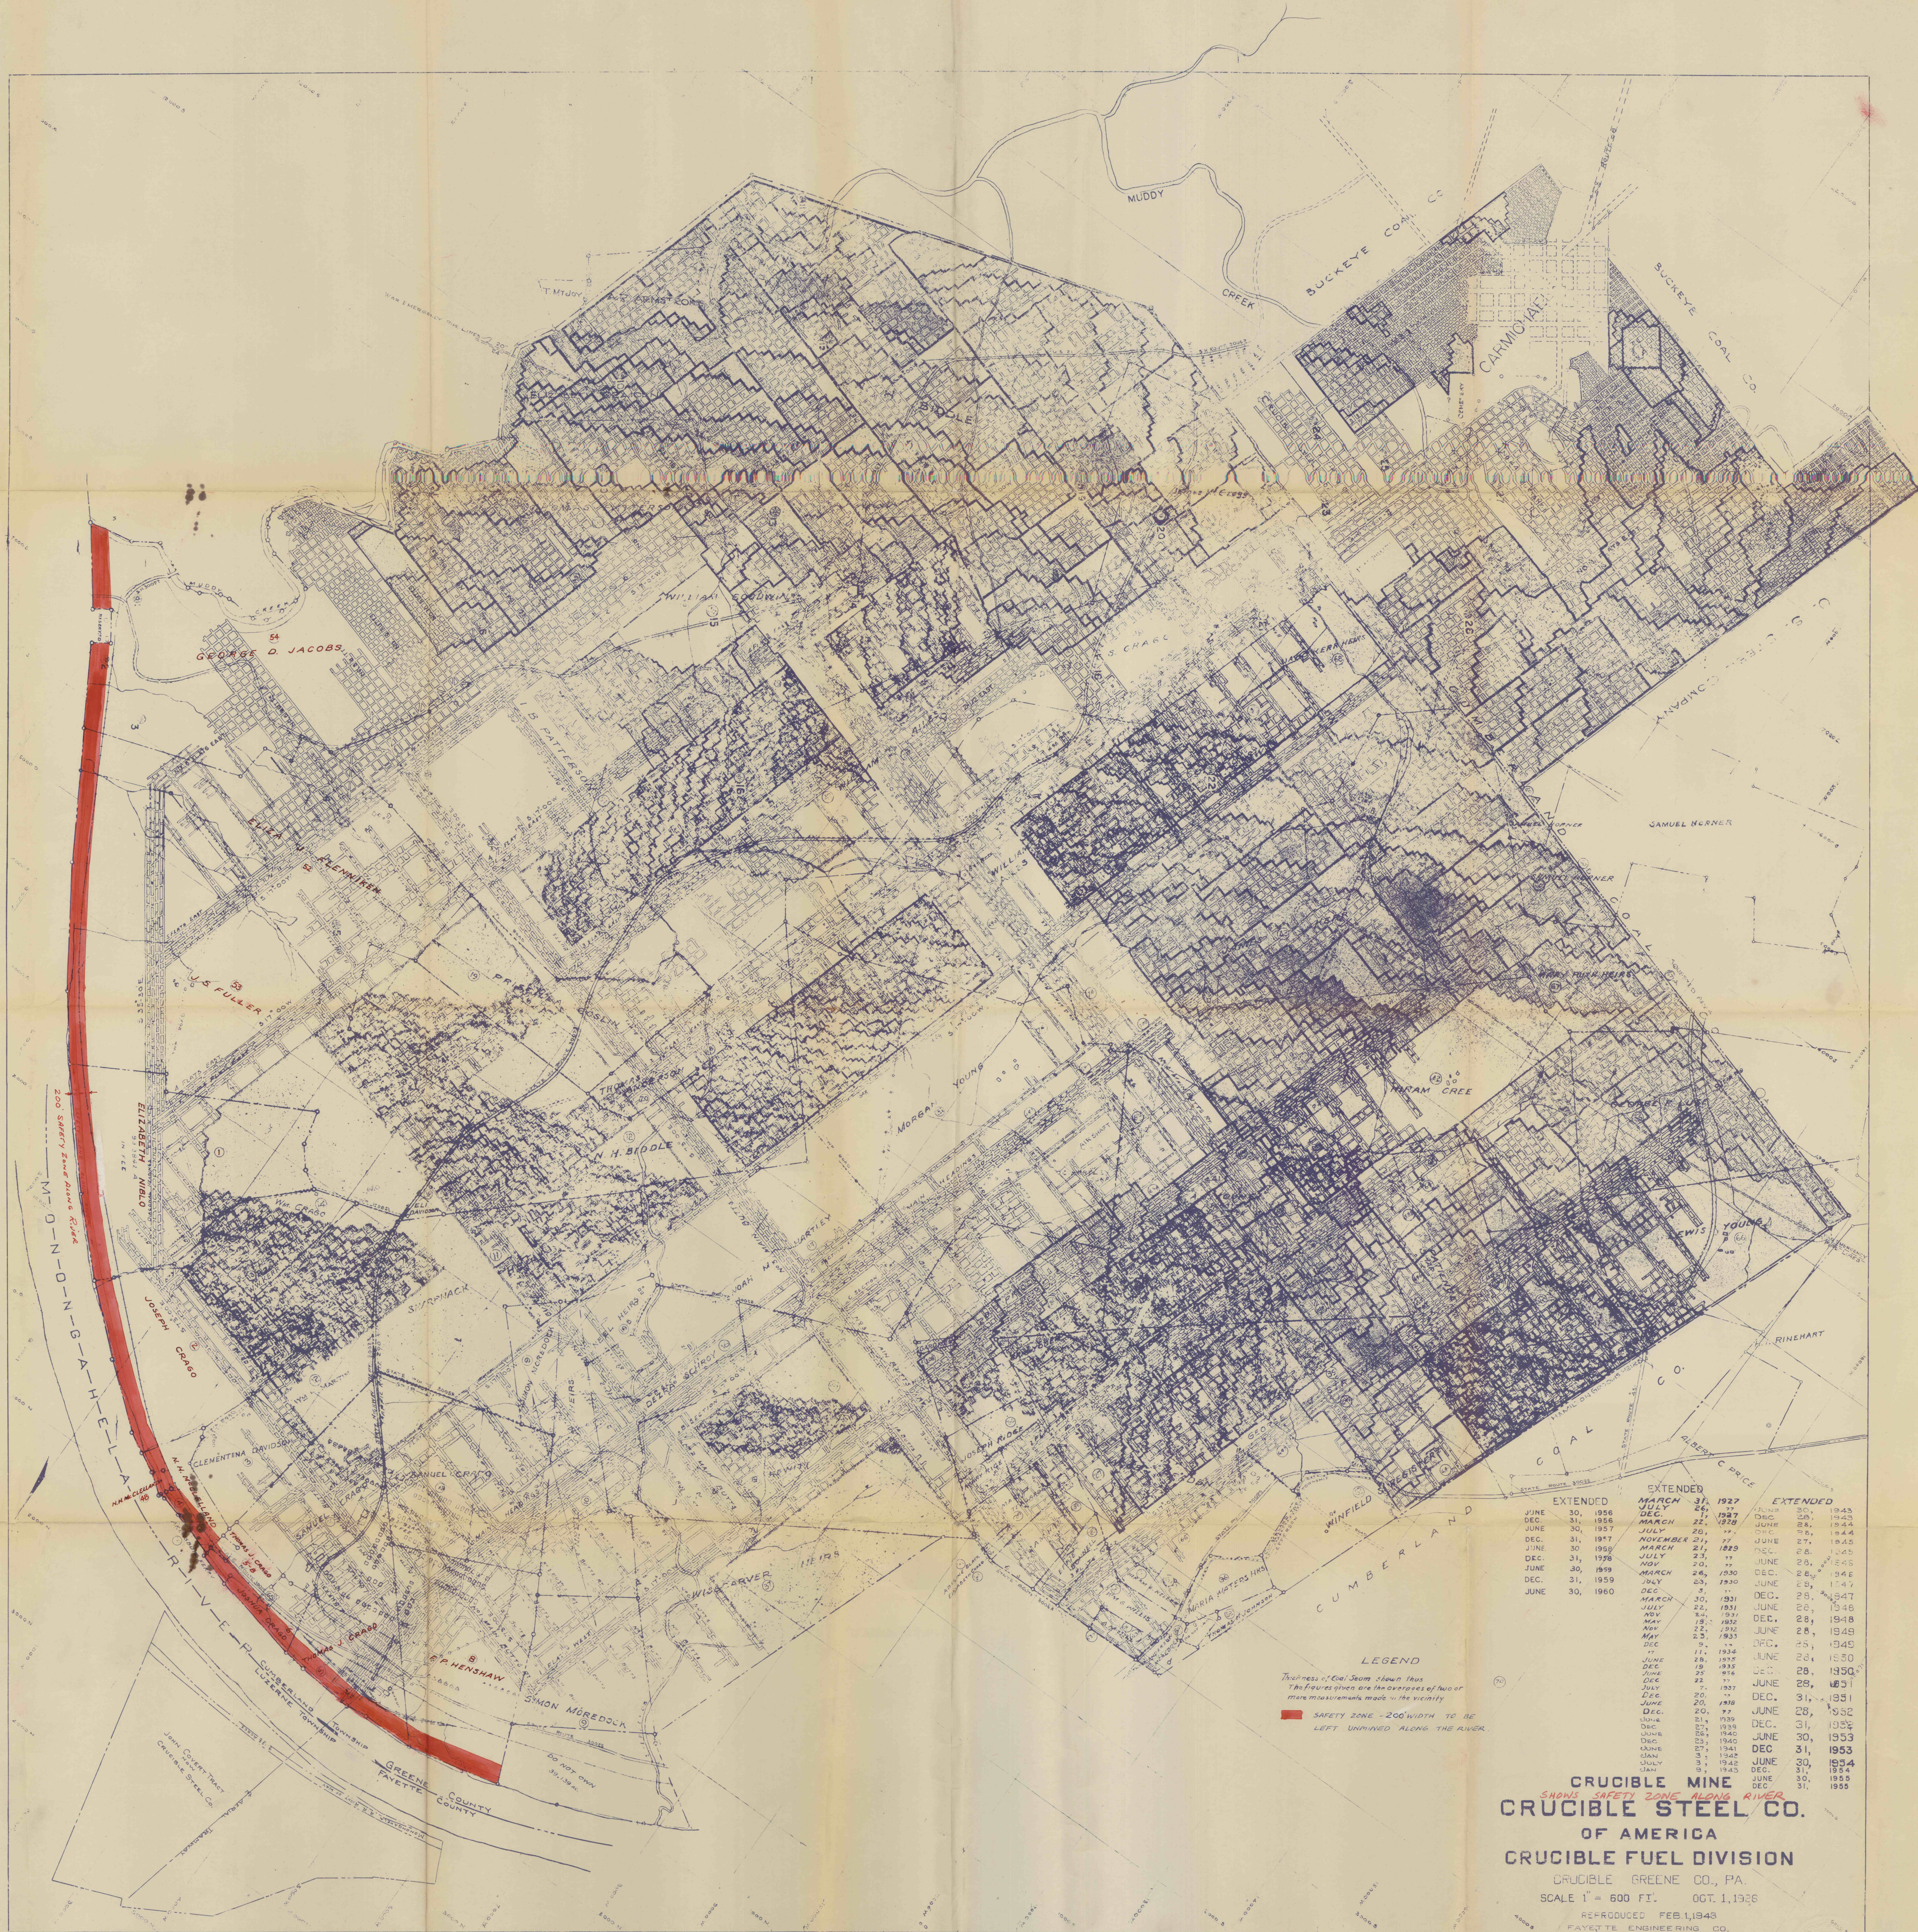

EXTENDED		EXTENDED		EXTENDED	
JUNE 30, 1956	26, 1957	MARCH 31, 1957	26, 1957	JUNE 30, 1956	26, 1957
DEC. 31, 1956	26, 1957	JULY 26, 1957	26, 1957	DEC. 31, 1956	26, 1957
JUNE 30, 1957	26, 1957	NOVEMBER 21, 1957	26, 1957	JUNE 30, 1957	26, 1957
DEC. 31, 1957	26, 1957	MARCH 21, 1958	26, 1958	DEC. 31, 1957	26, 1958
JUNE 30, 1958	26, 1958	JULY 21, 1958	26, 1958	JUNE 30, 1958	26, 1958
DEC. 31, 1958	26, 1958	NOVEMBER 21, 1958	26, 1958	DEC. 31, 1958	26, 1958
JUNE 30, 1959	26, 1959	MARCH 21, 1959	26, 1959	JUNE 30, 1959	26, 1959
DEC. 31, 1959	26, 1959	JULY 21, 1959	26, 1959	DEC. 31, 1959	26, 1959
JUNE 30, 1960	26, 1960	NOVEMBER 21, 1959	26, 1959	JUNE 30, 1960	26, 1960
	</				