


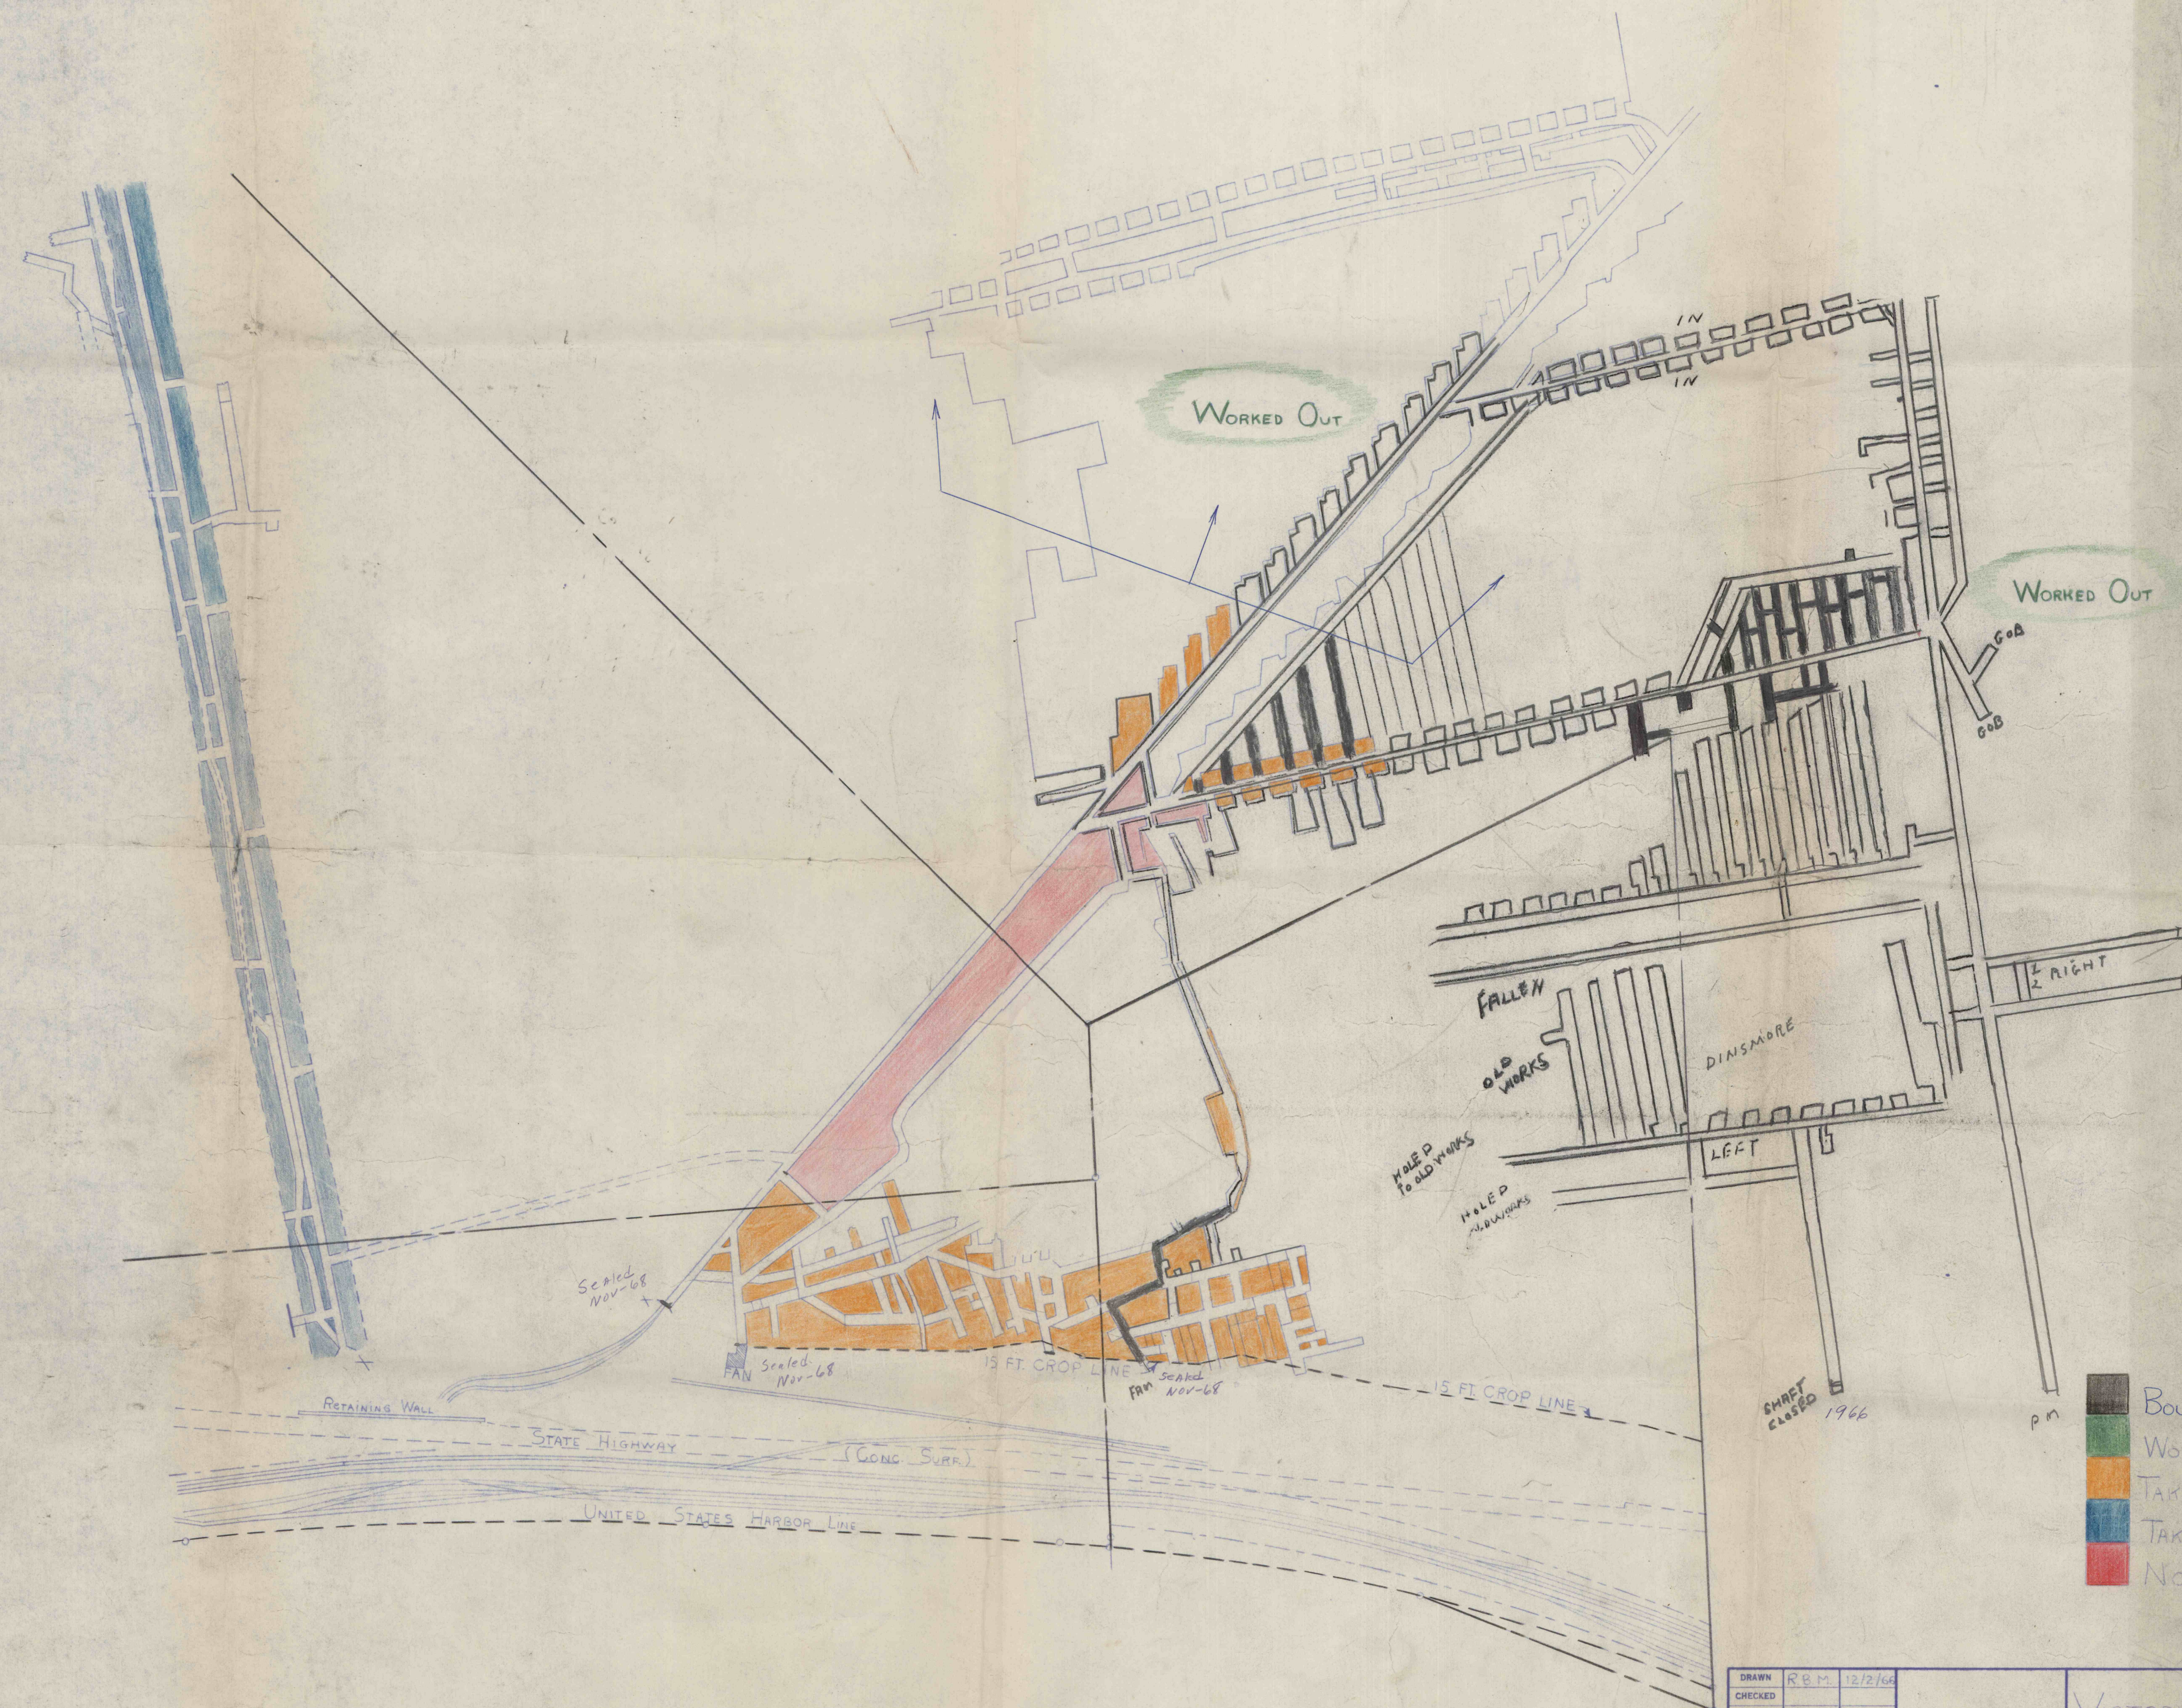

- BOUNDARY LINES
- WORKED OUT
- TAKING OUT 1/2
- TAKE OUT
- NOT MINABLE

F
NB
T-30

DRAWN	R.M.	12/12/66
CHECKED		
APPROVED		
REVISIONS		
R-1348 Closed		
11-1-68 Mine sealed		

VICTORY COAL COMPANY

MCDONALD ASSOCIATES ENGINEERING
CHARLOTTE, PA.

SCALE 1"=100'
JOB 1532
SHEET No. 2

Letter From Batch Oct-68 Mine sealed