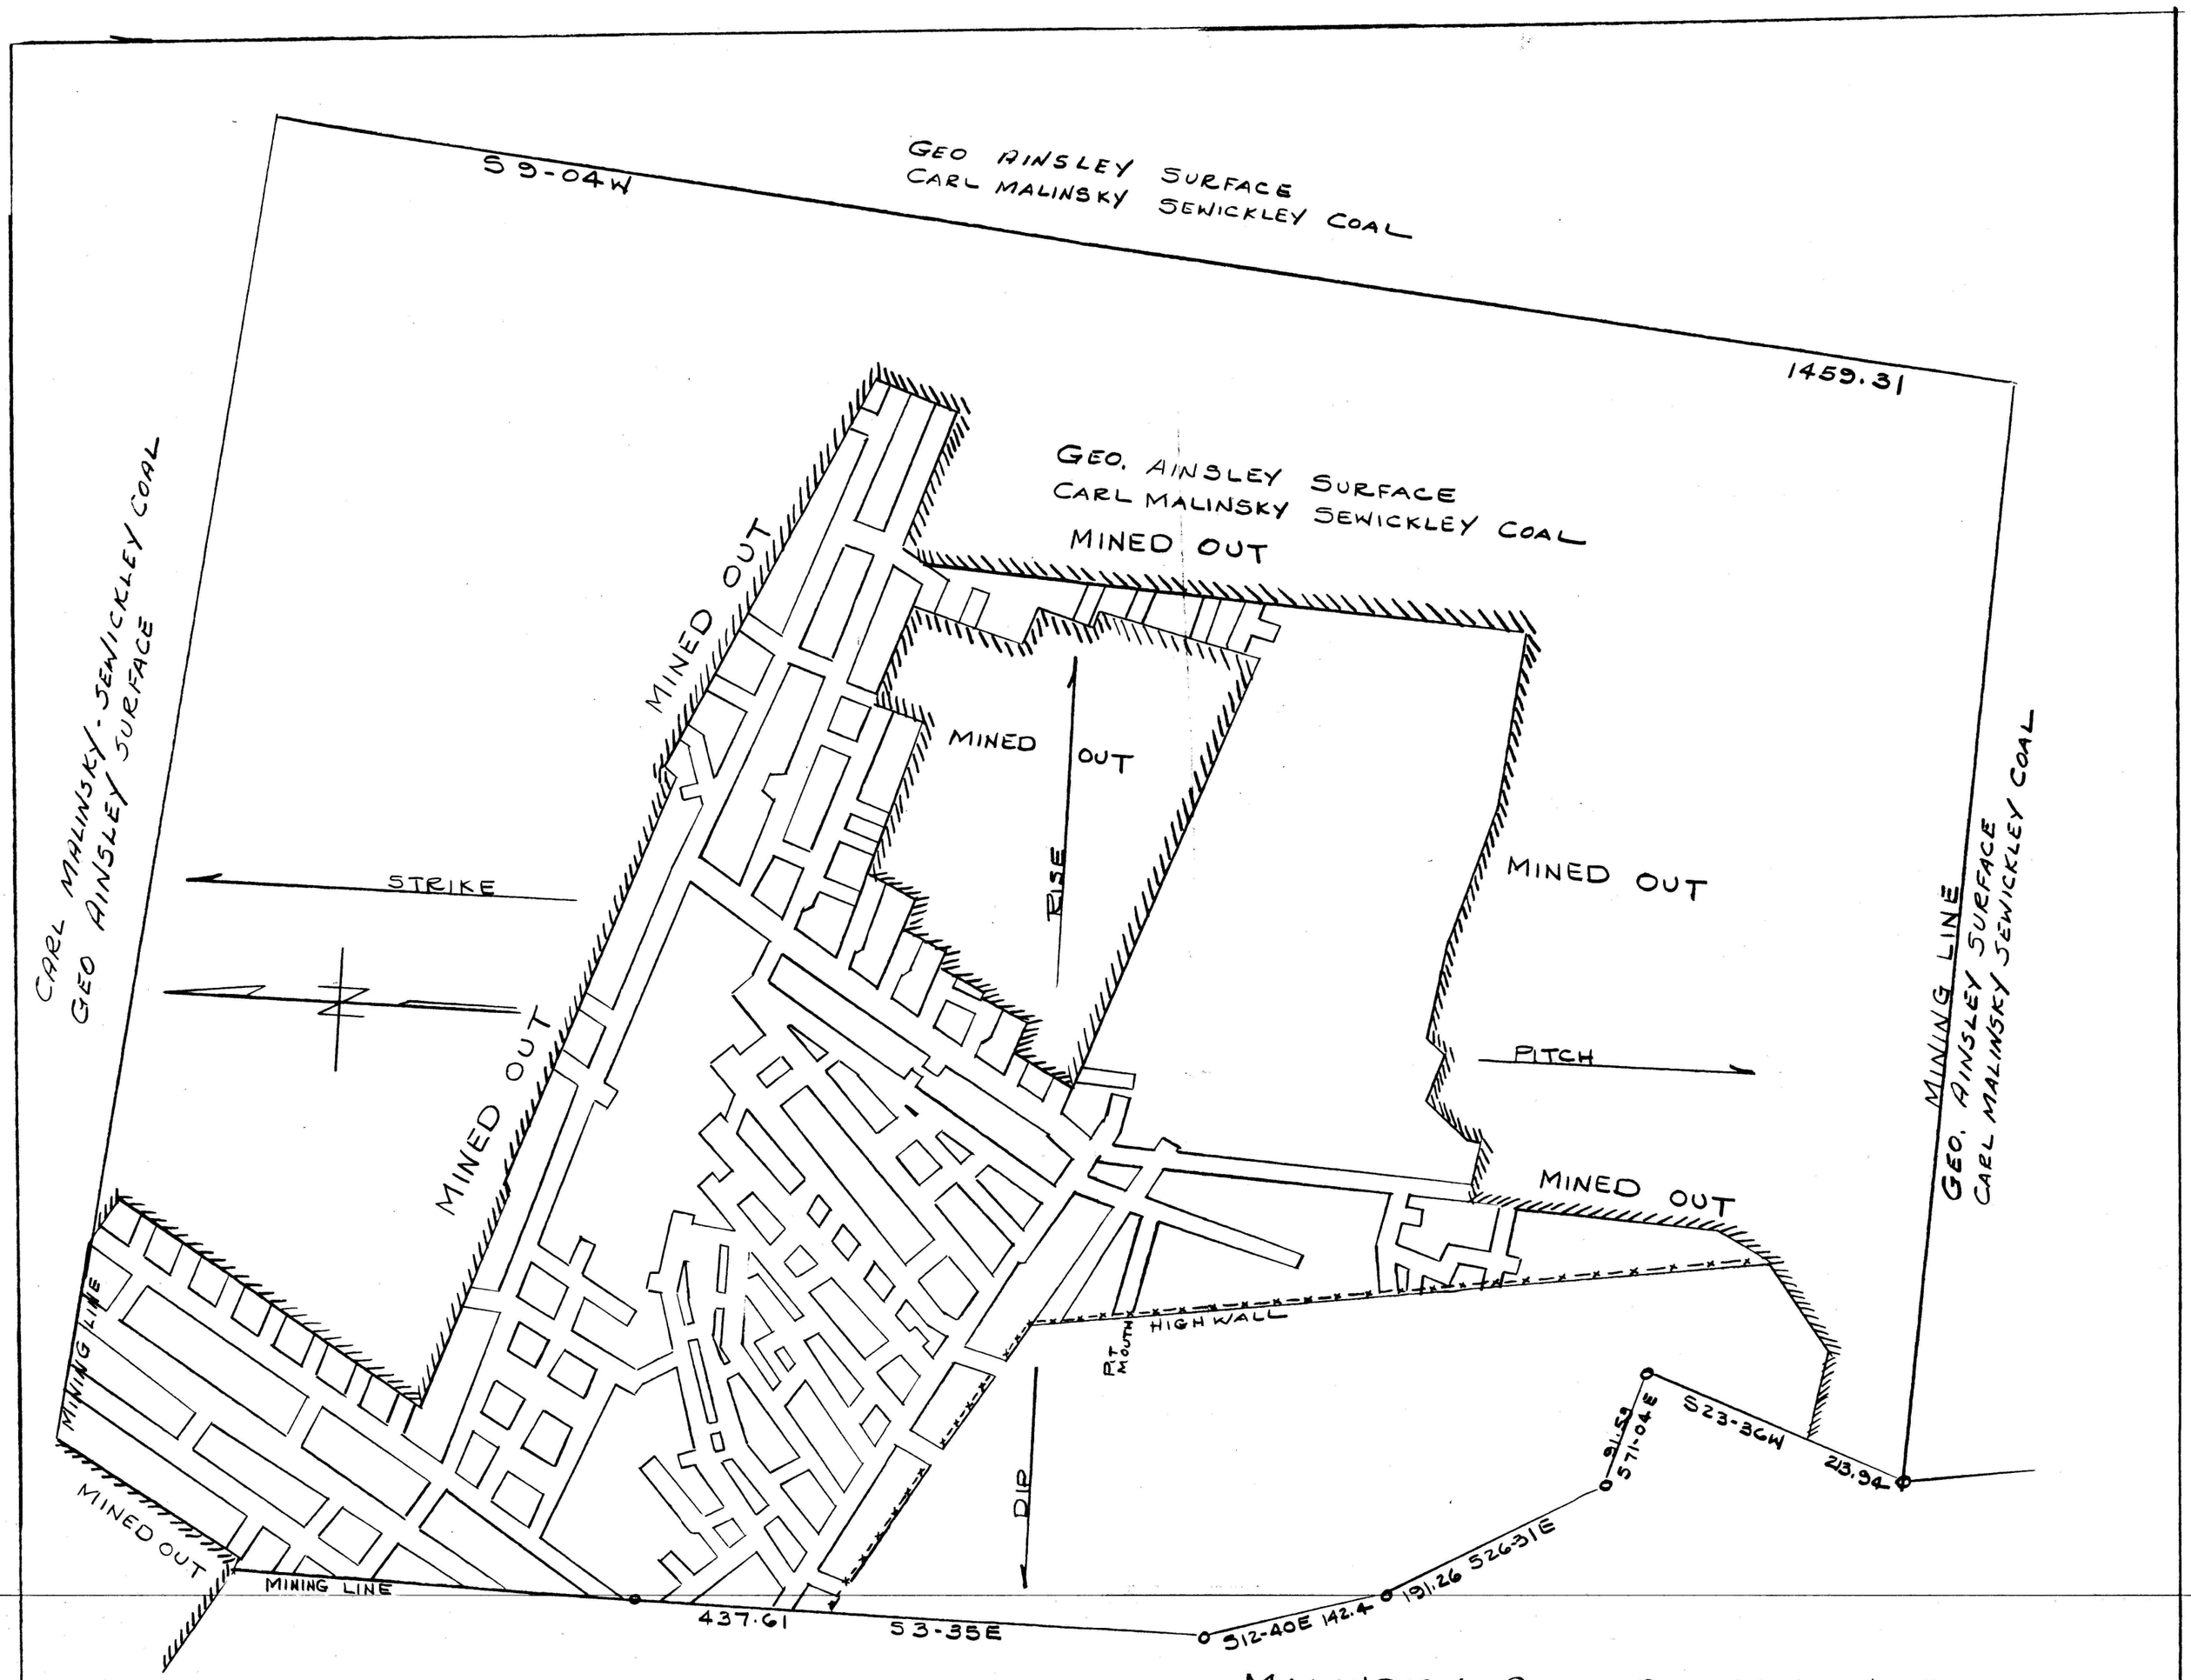

MALINSKY COAL CO. MINE Nº 2

CARL MALINSKY - OWNER SEWICKLEY COAL

NICHOLSON TWP. - FAYETTE CO. - PENNA.

SCALE 1IN = 100FT 3-2-67

PREPARED BY William A. Thistlethwaite R.S. #7770E

DEEP MINE SAFETY 100

0 100 200 Feet