





UNITED STATES
DEPARTMENT OF THE INTERIOR
GEOLOGICAL SURVEY

MASONTOWN 15' QUADRANGLE
PENNSYLVANIA
7.5 MINUTE SERIES (TOPOGRAPHIC)
SW 1/4 MASONTOWN 15' QUADRANGLE

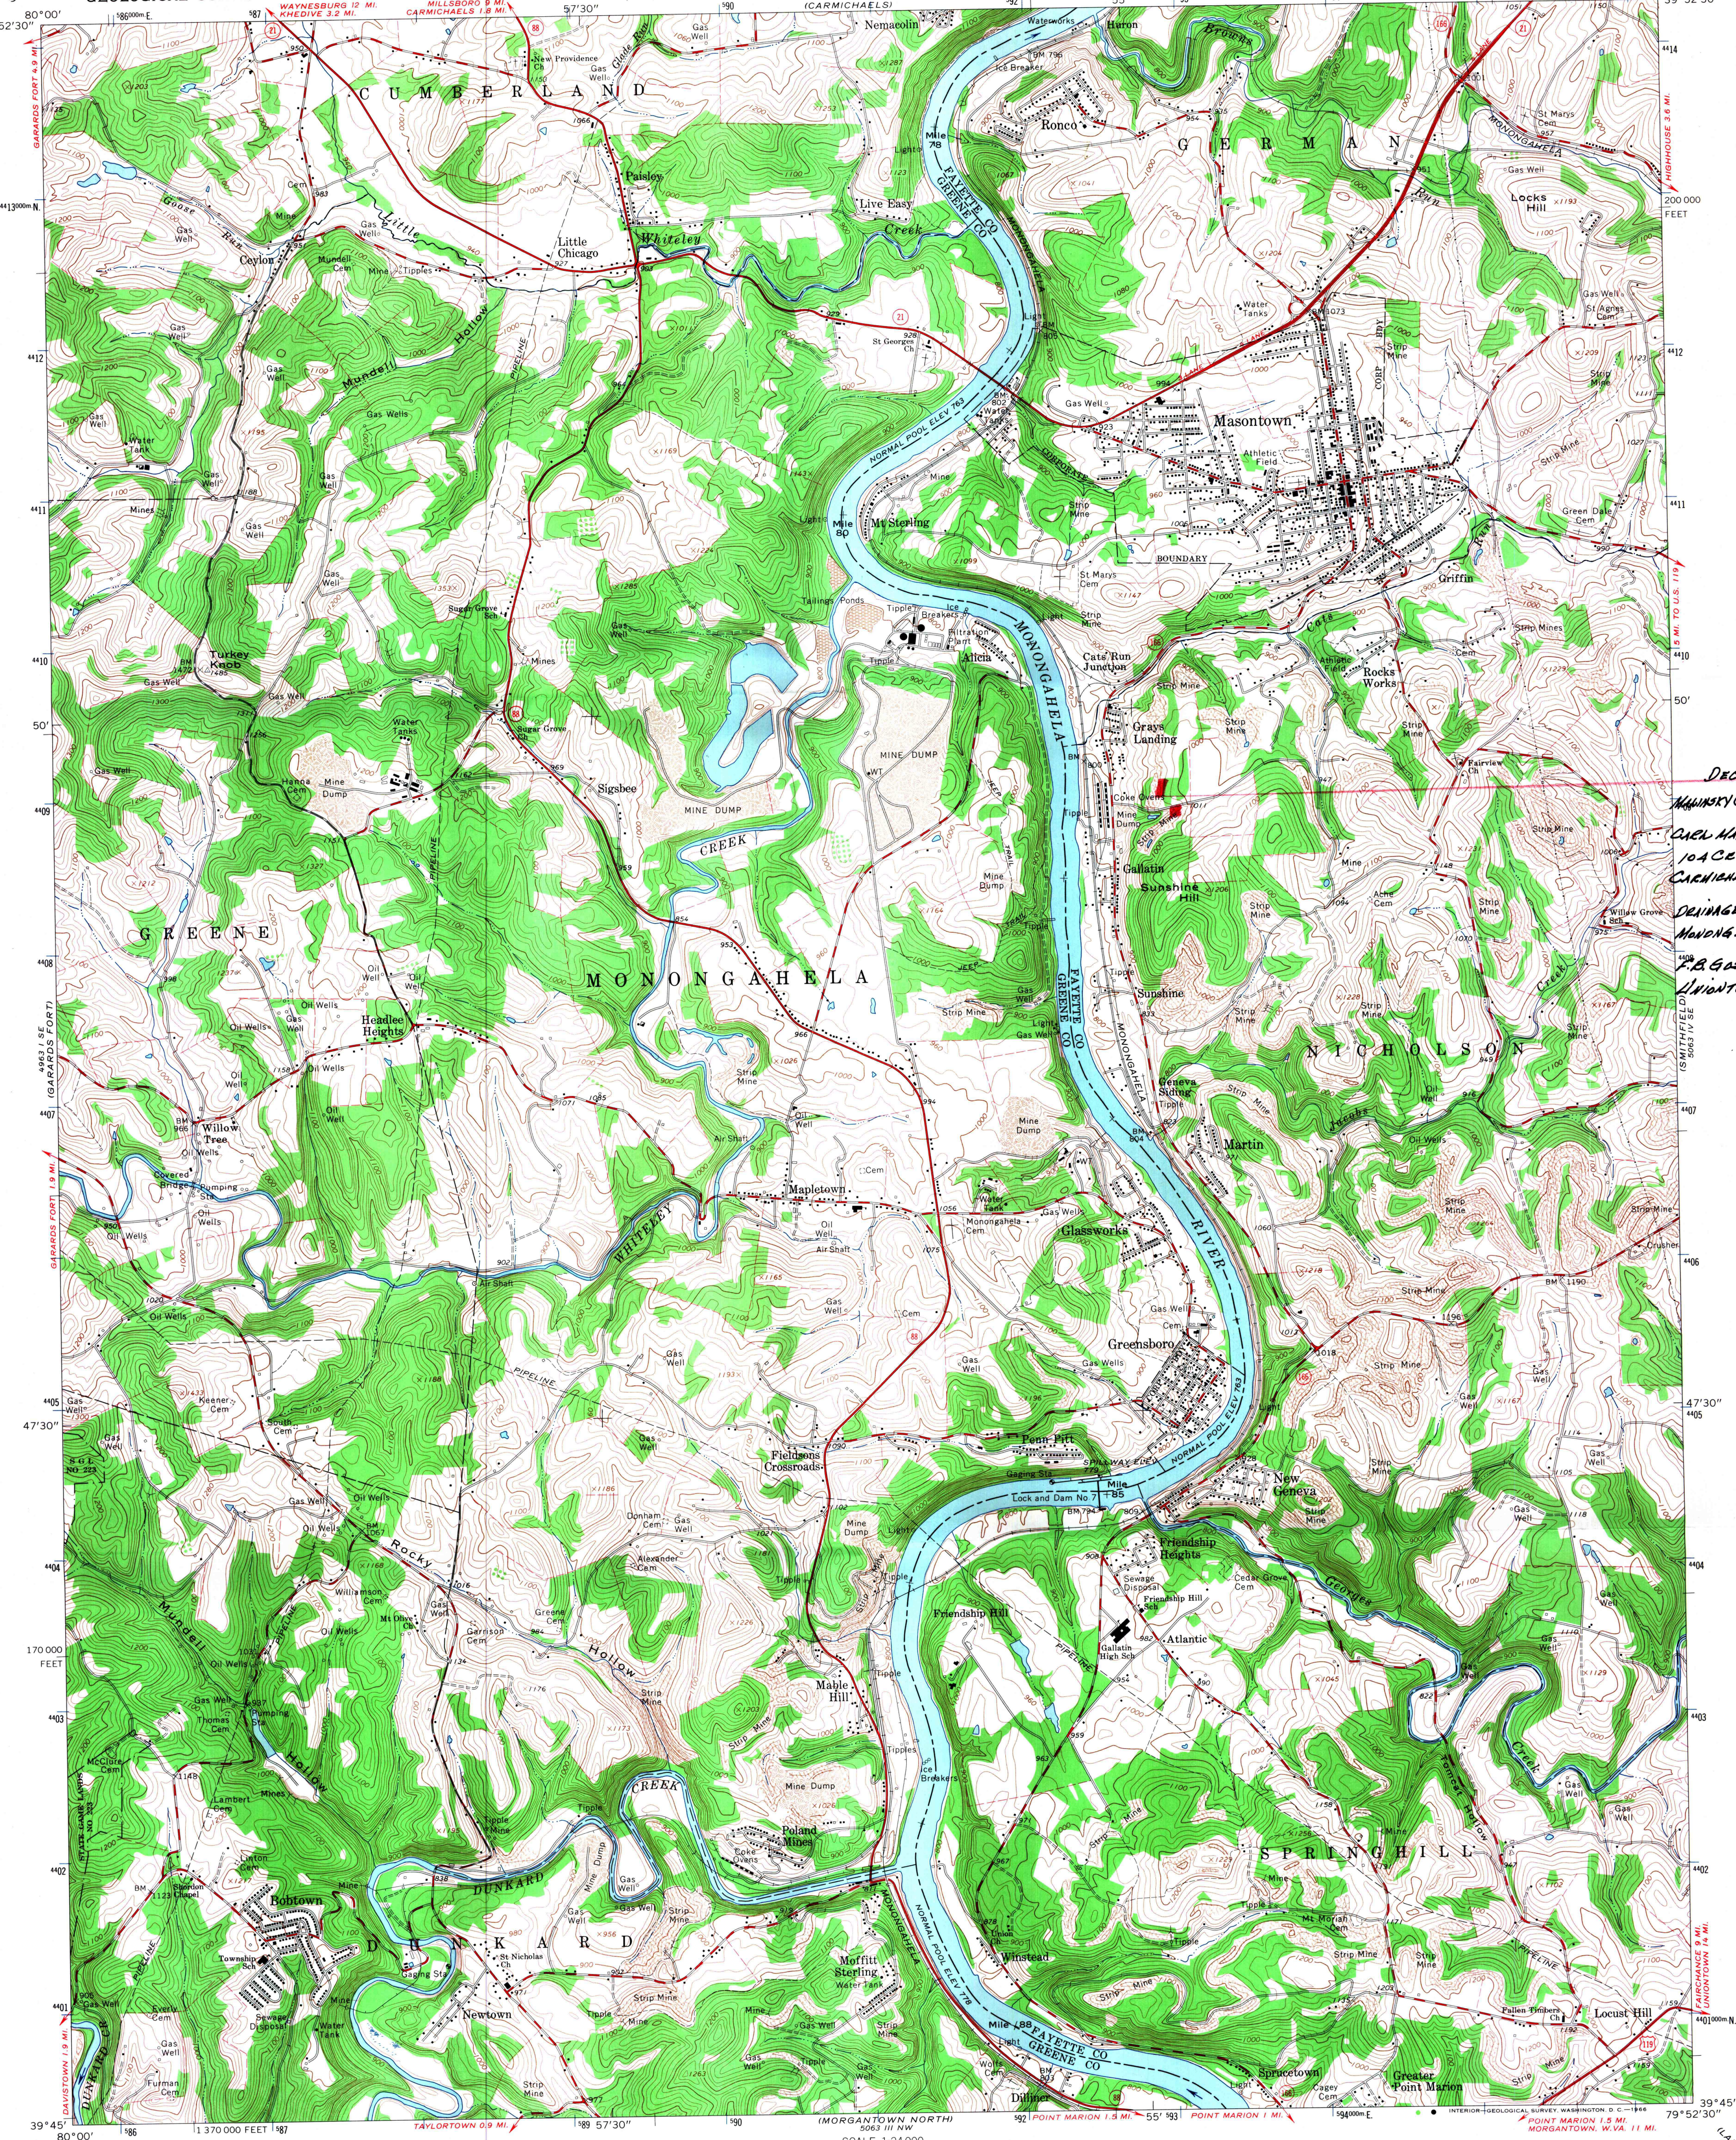

DEC. 15, 1967
MUNSKY COAL CO. MINE
104 CROSS STREET
CARNEGIES, PA.
DENINGE (FANY) TO
MONONGAHELA RIVER
P.B. GARDNER, R.F.E.
UNIONTOWN, PA.

Mapped, edited, and published by the Geological Survey
Control by USGS, USCGS, and USCE
Topography by photogrammetric methods from aerial photographs
taken 1962 and 1963. Field checked 1964
Polyconic projection. 1927 North American datum
10,000-foot grid based on Pennsylvania coordinate system, south zone
1000-meter Universal Transverse Mercator grid ticks,
zone 17, shown in blue
Fine red dashed lines indicate selected fence and field lines where
generally visible on aerial photographs. This information is unchecked

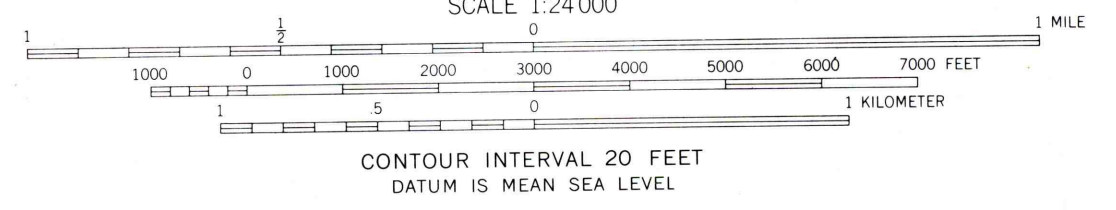

ROAD CLASSIFICATION
Heavy-duty ——— Light-duty ———
Medium-duty ——— Unimproved dirt ———
U. S. Route ——— State Route ———

MASONTOWN, PA.
SW 1/4 MASONTOWN 15' QUADRANGLE
N3945-W7952.5/7.5
1964
AMS 5063 IV SW-SERIES V831

THIS MAP COMPLIES WITH NATIONAL MAP ACCURACY STANDARDS
FOR SALE BY U.S. GEOLOGICAL SURVEY, WASHINGTON, D.C. 20242
A FOLDER DESCRIBING TOPOGRAPHIC MAPS AND SYMBOLS IS AVAILABLE ON REQUEST