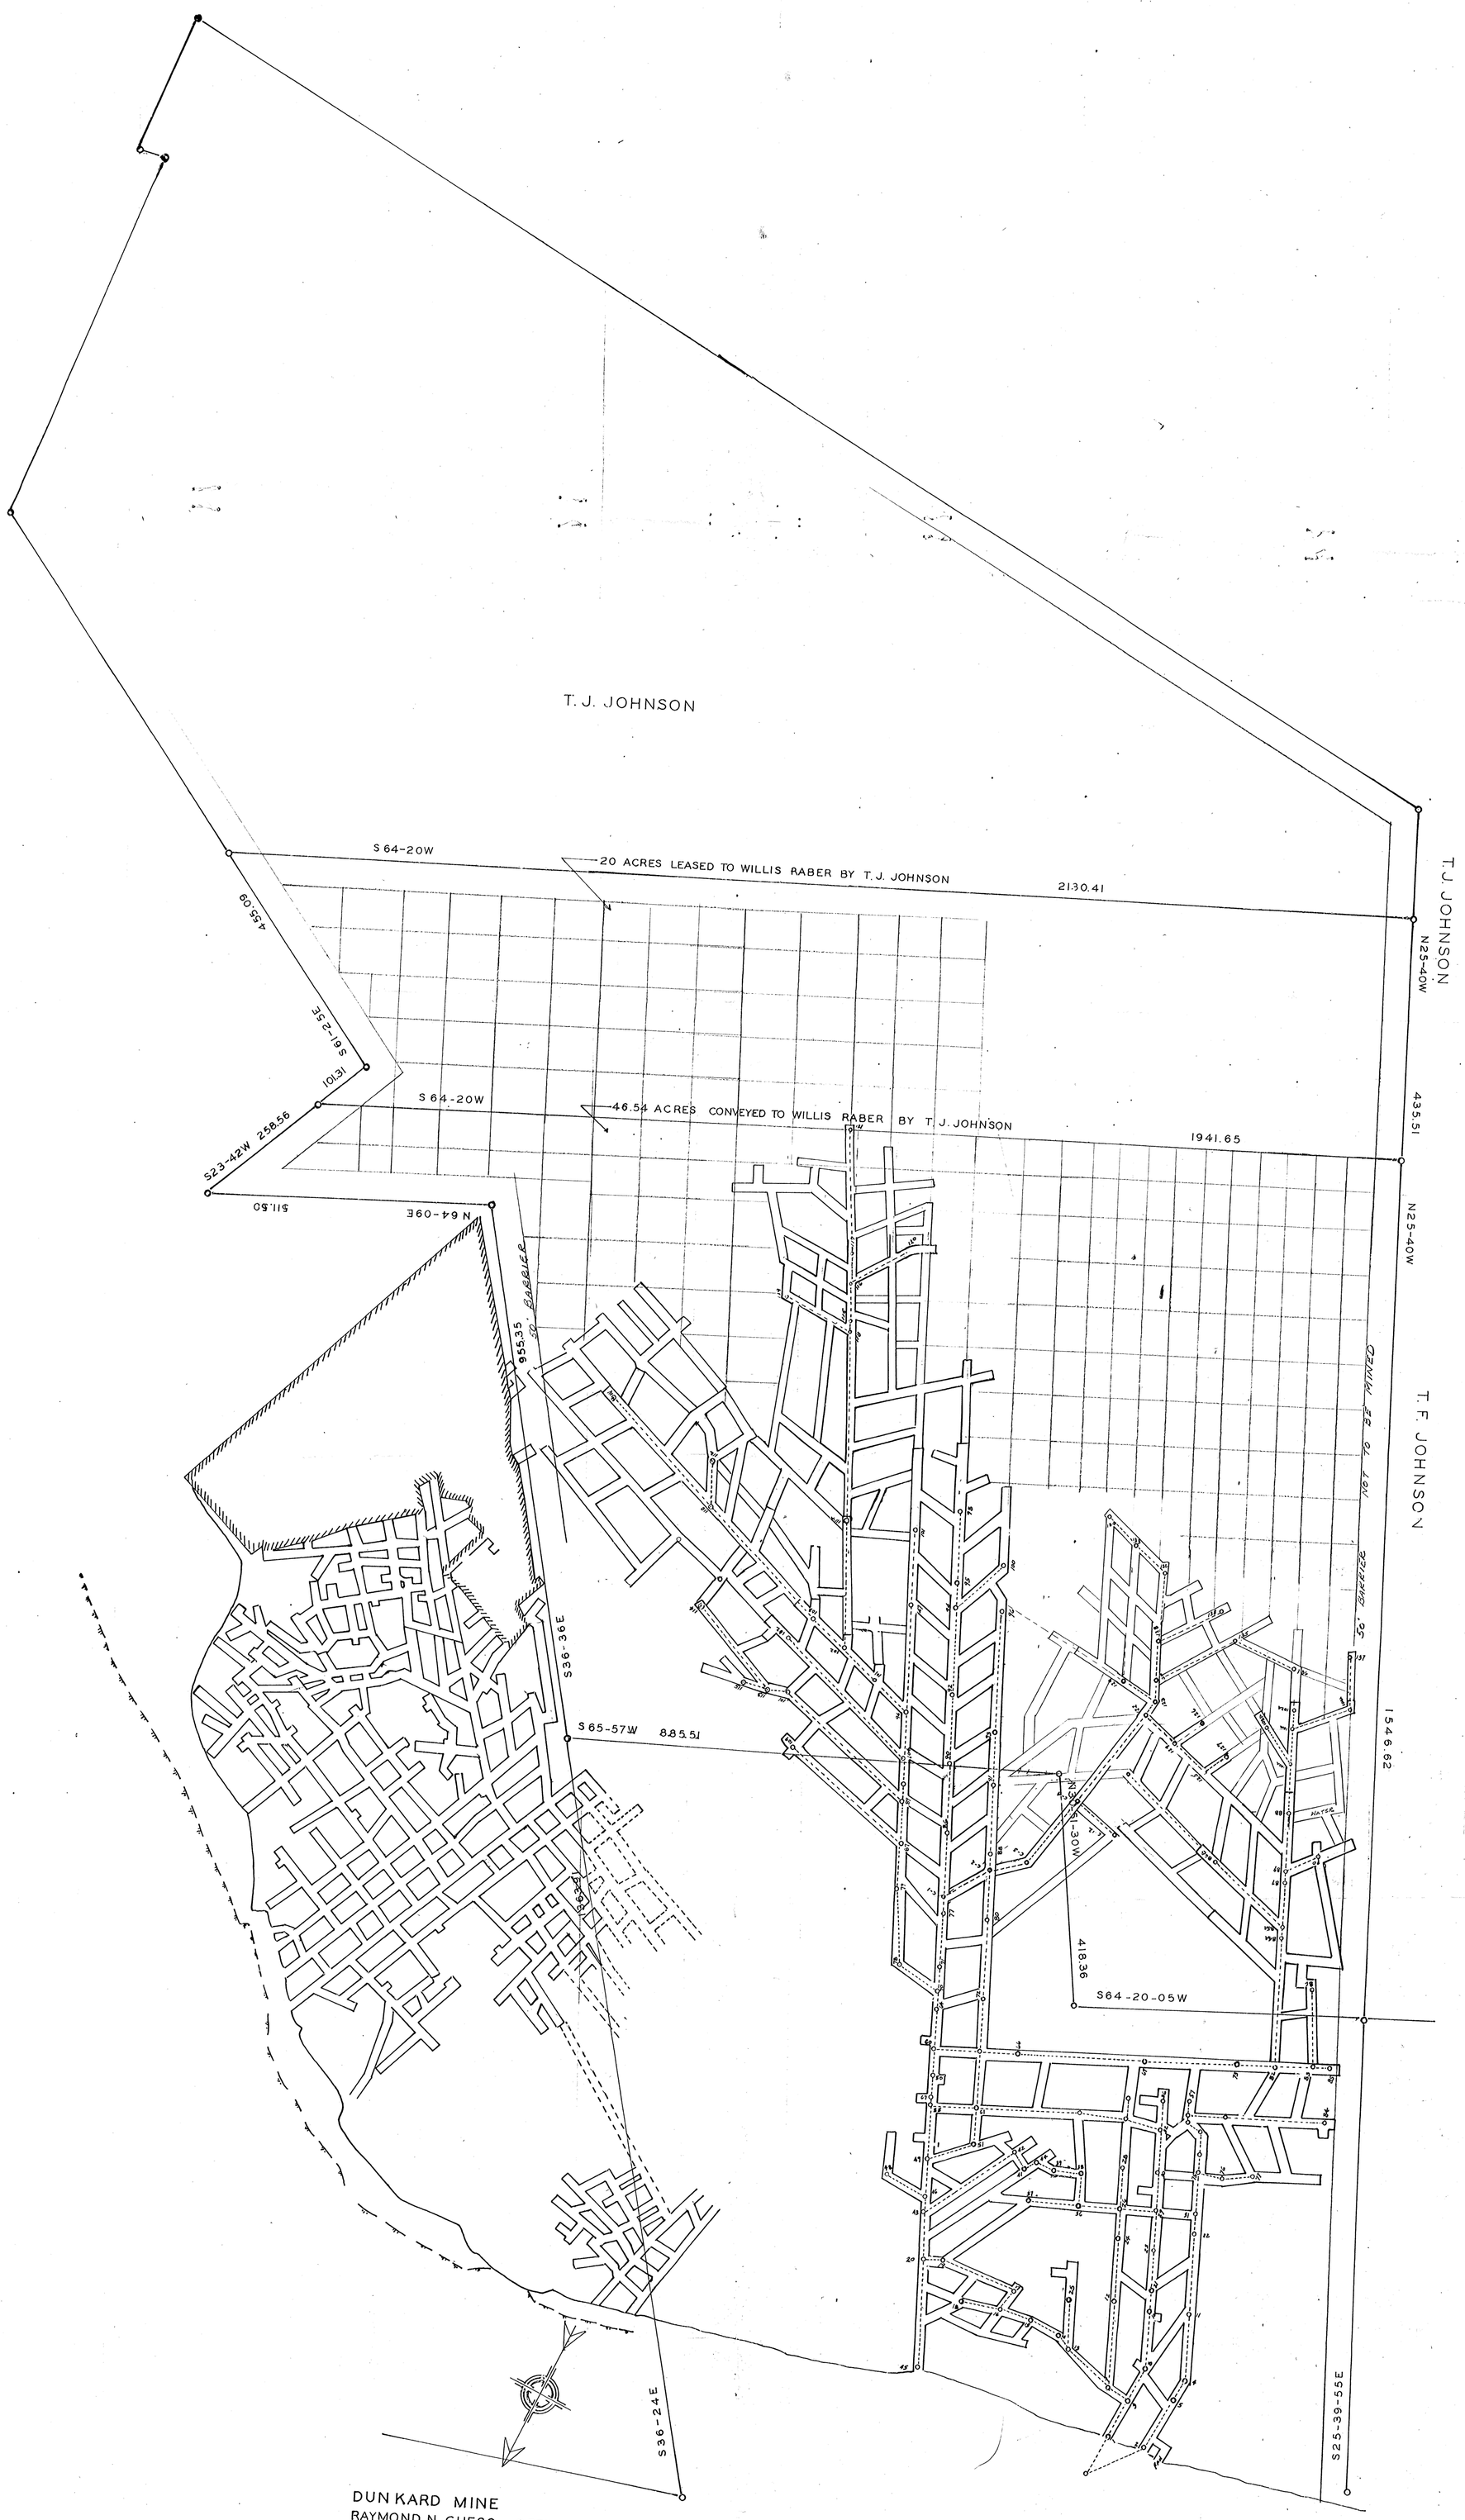

DUNKARD MINE
RAYMOND N. CHESS - OPERATOR
DUNKARD TWP. - GREENE CO. - PENNA.
SCALE 1" = 100' MARCH 1964
WILLIAM A. THISTLETHWAITE
REGISTERED SURVEYOR NO. 7770E

SURVEY	DATE
A	May 1964
B	Dec 1964
C	Sept 1965
D	May 1966
E	Sept. 1966
F	Nov. 1966
G	Jan. 1967
H	Feb. 1967
I	Aug. 1967