


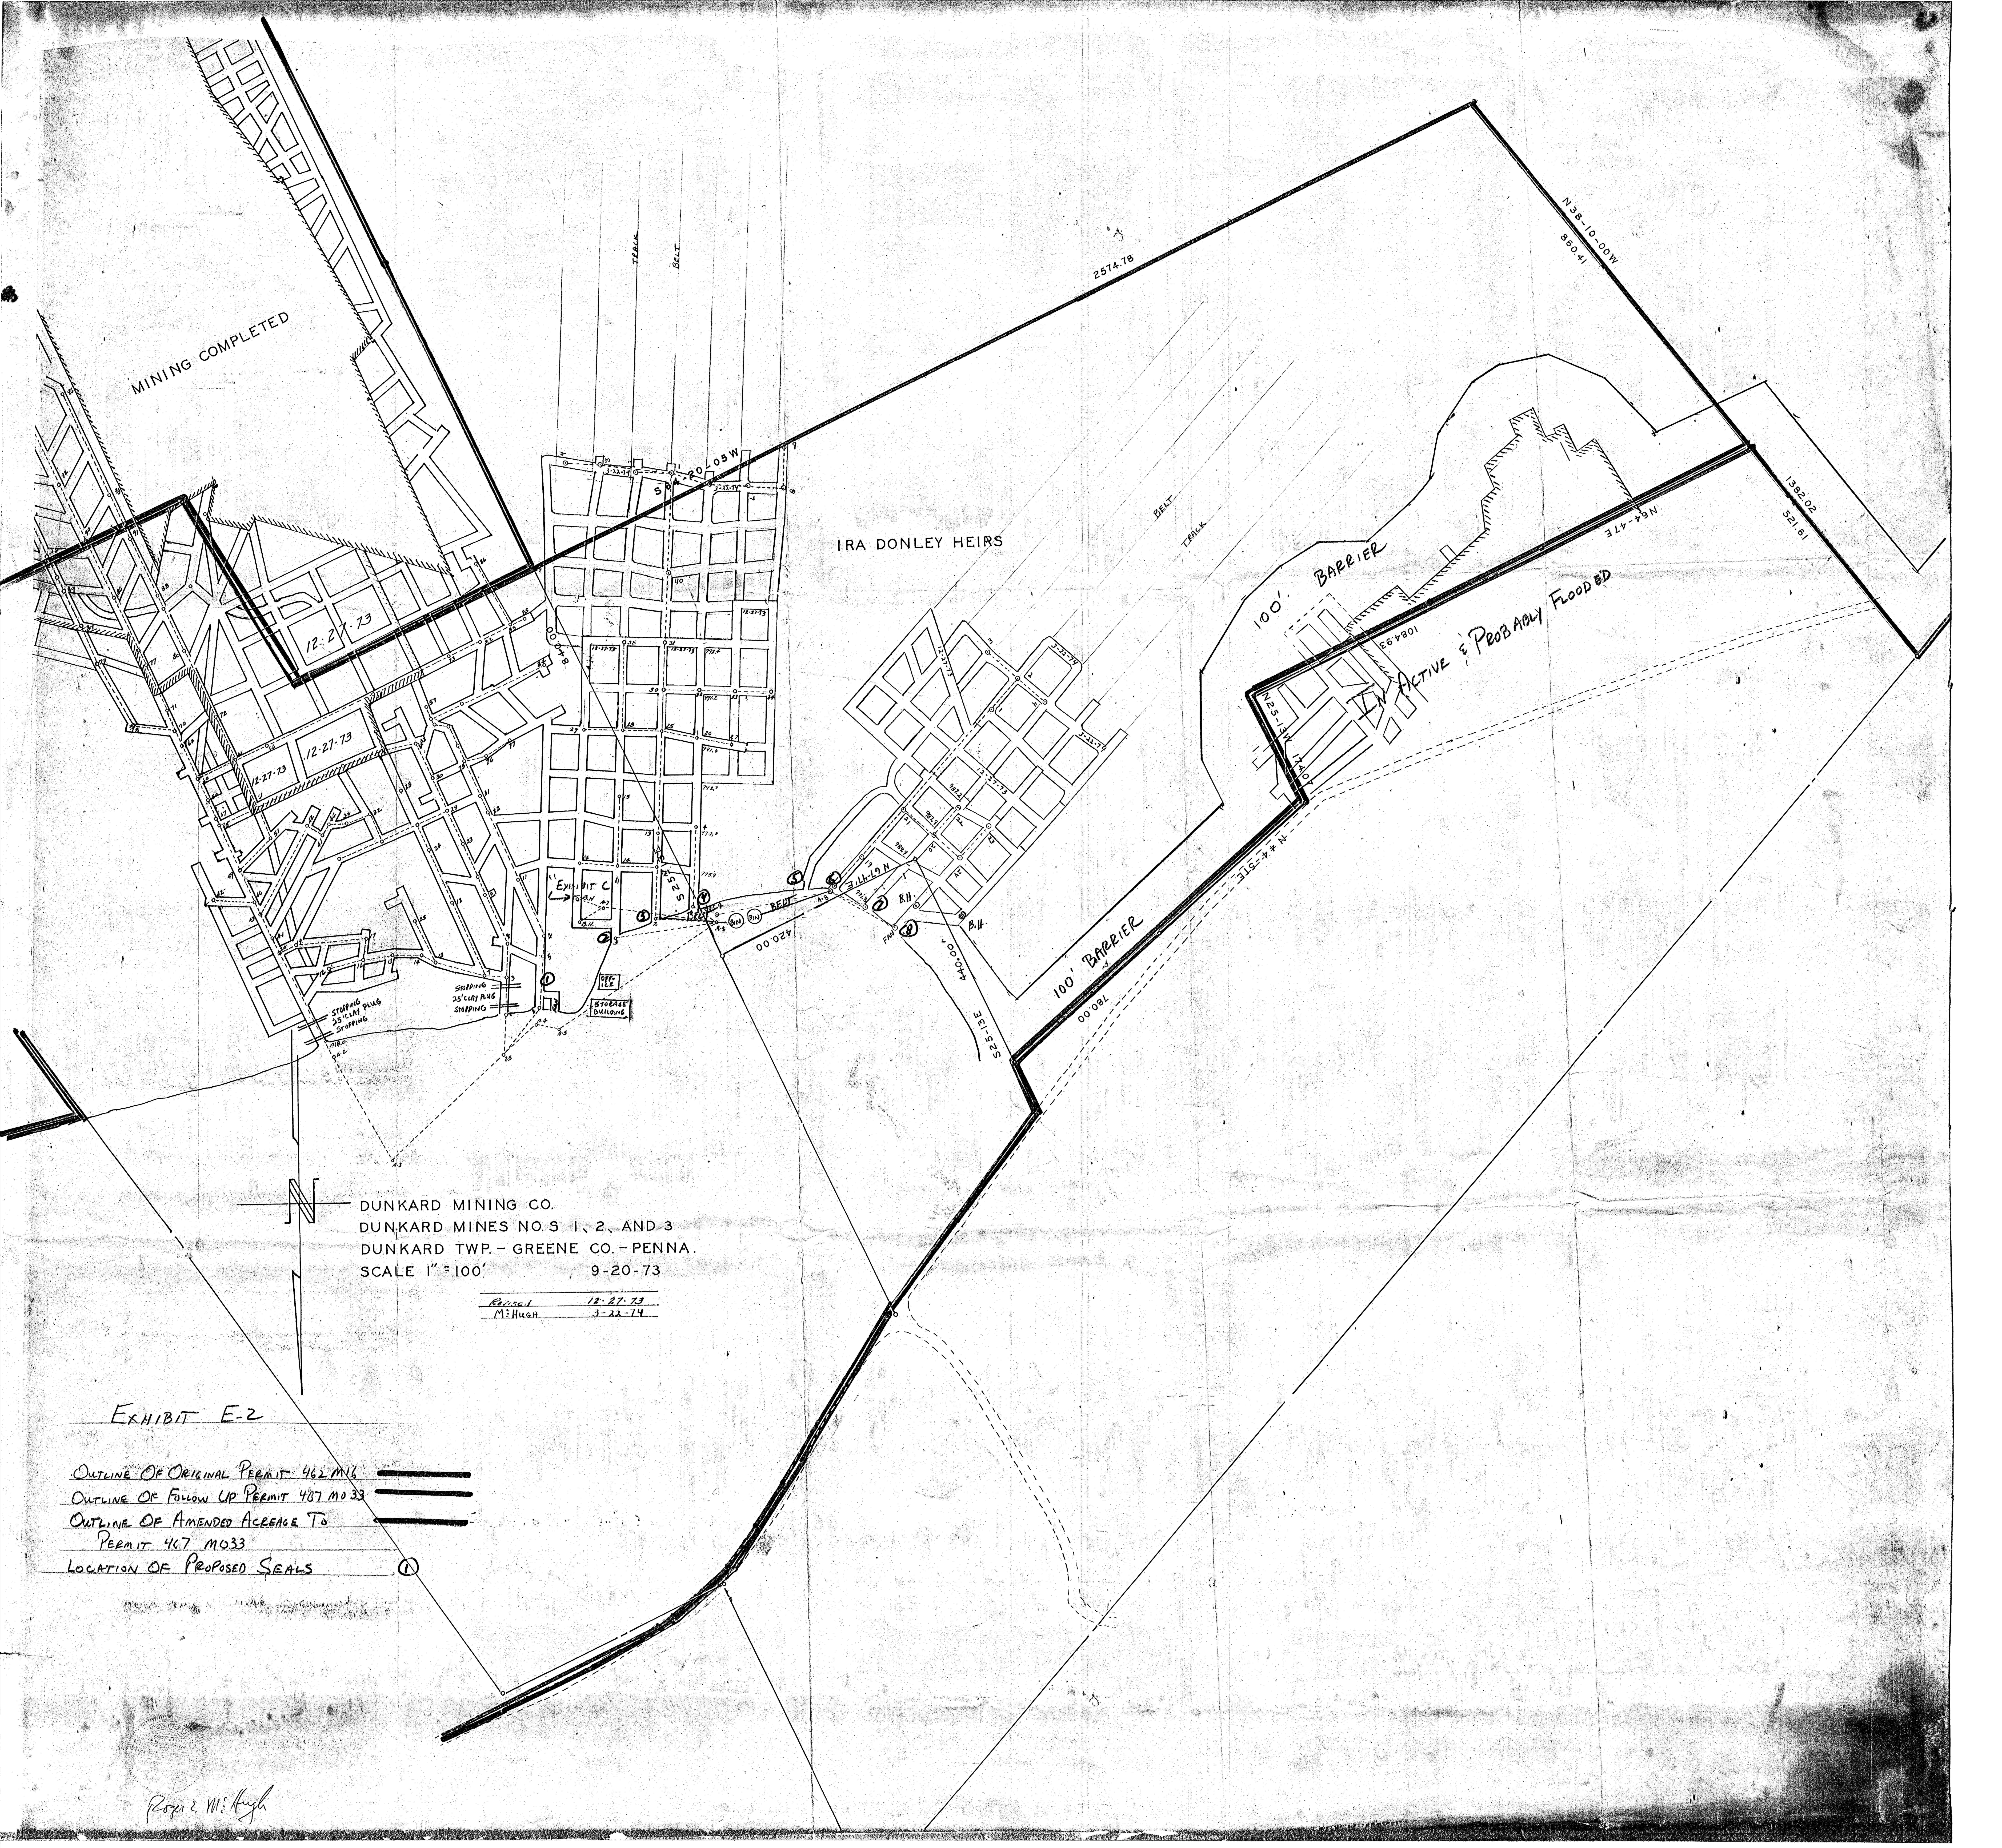

MINING COMPLETED

IRA DONLEY HEIRS

100' BARRIER

ACTIVE & PROBABLY FLOODED

100' BARRIER

DUNKARD MINING CO.
DUNKARD MINES NO. 1, 2, AND 3
DUNKARD TWP. - GREENE CO. - PENNA.
SCALE 1" = 100' 9-20-73

Revised 12-27-73
Mellish 3-22-74

EXHIBIT E-2

- OUTLINE OF ORIGINAL PERMIT 462 M16
- OUTLINE OF FOLLOW UP PERMIT 487 M033
- OUTLINE OF AMENDED ACREAGE TO PERMIT 467 M033
- LOCATION OF PROPOSED SEALS

Roger W. Hughes